
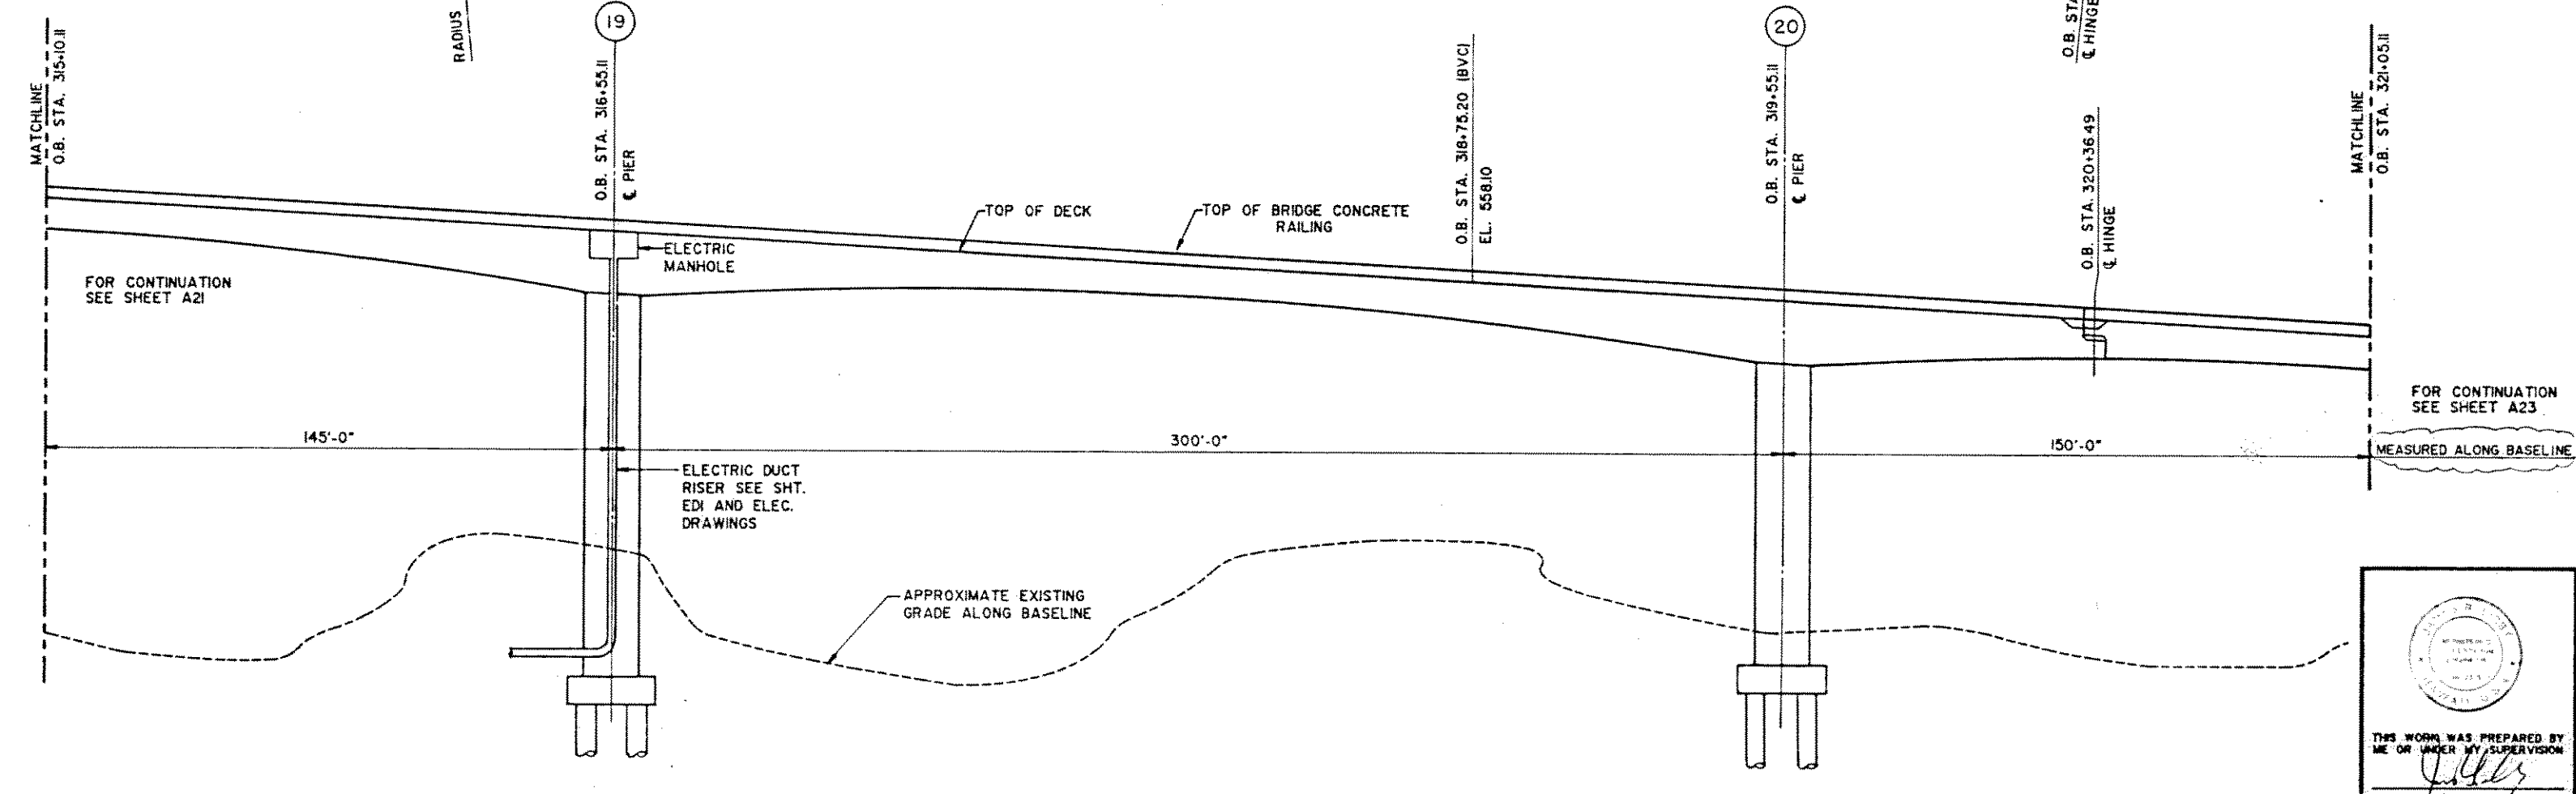


FED. ROAD DIST. NO.	STATE	FED. AID PROJ. NO.	FISCAL YEAR	SHEET NO.	TOTAL SHEETS
HAWAII	HAW.	I-H3-1 (57)	1988		

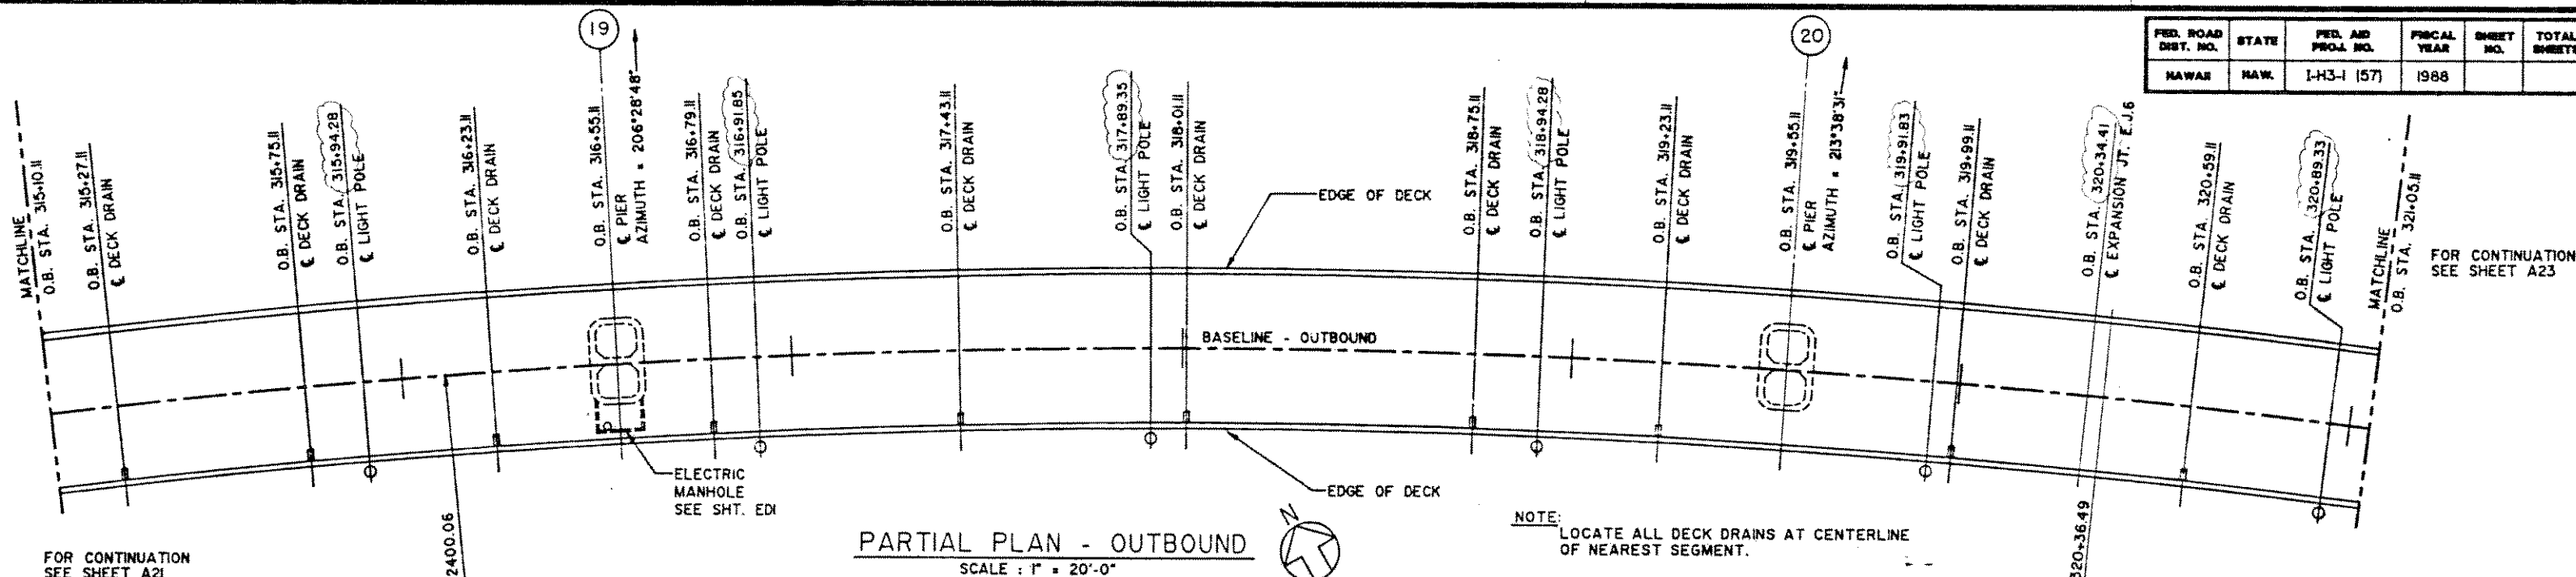

- LEGEND:
- 1. — INDICATES GROUND BUSS EXTENDING DOWN PIER TO GROUND ROD.
 - 2. O/R INDICATES OFFSET RIGHT OF BASELINE.
 - 3. O/L INDICATES OFFSET LEFT OF BASELINE.

08/23/91	UPDATED LIGHT POLES & E.J. STA.
DATE	REVISION
J. MULLER INTERNATIONAL	Libby Engineers

STATE OF HAWAII
DEPARTMENT OF TRANSPORTATION
HIGHWAY DIVISION

PART. DECK LAYOUT & ELEVATION
STA. 315+10.11 TO STA. 321+05.11
OUTBOUND STRUCTURE
INTERSTATE ROUTE H-3
F.A.I. PROJECT NO. I-H3-1 (57)
F.A.I. PROJECT NO. I-H3-1 (58)
SCALE: AS NOTED DATE: JUNE 1990
SHEET No. A22 OF 24 SHEETS