



FED. ROAD DIST. NO.	STATE	FED. AID PROJ. NO.	FISCAL YEAR	SHEET NO.	TOTAL SHEETS
HAWAII	HAW.	I-H3-1(57)	1988		

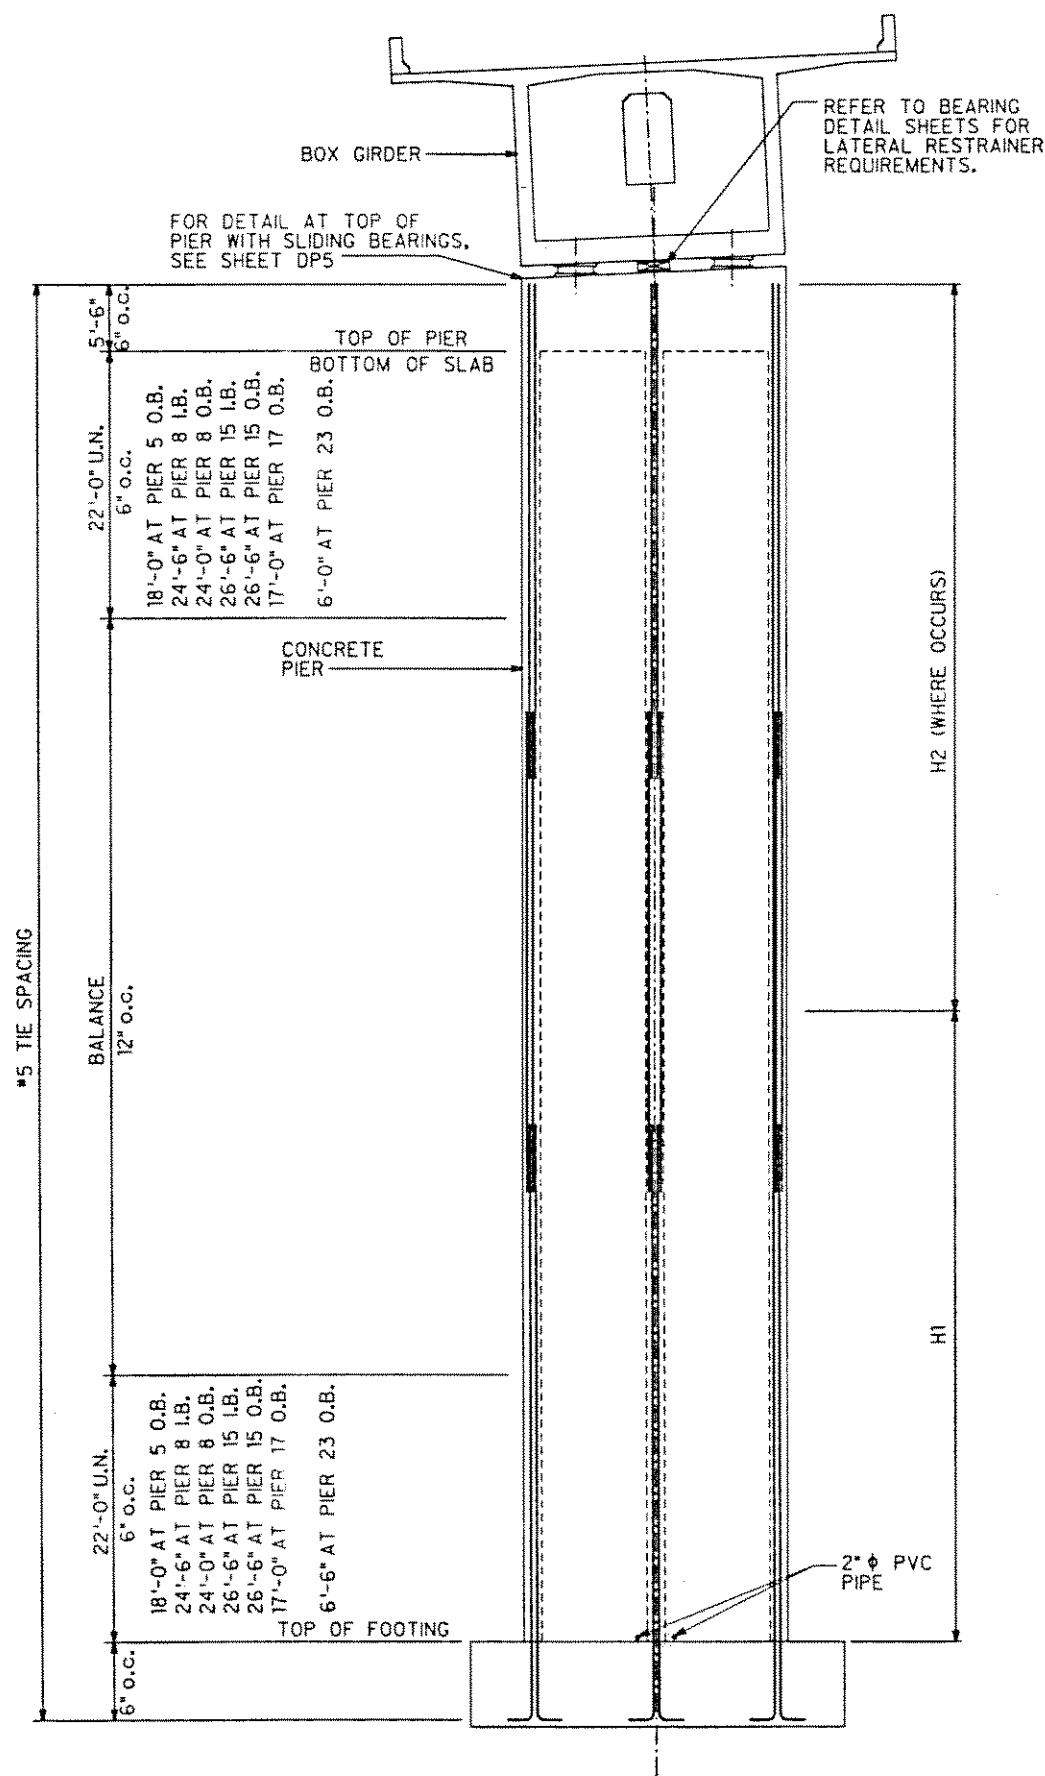


PIER ELEVATION
SCALE : 1/8" = 1'-0"

PIER NO. INBOUND	H1	REFERENCE SECTION	H2	REFERENCE SECTION	CONNECTION CONDITION	PIER SEGMENT TYPE	PIER NO. OUTBOUND	H1	REFERENCE SECTION	H2	REFERENCE SECTION	CONNECTION CONDITION	PIER SEGMENT TYPE
1	FULL HT.	A/PS2	N/A		FIXED	I	1	FULL HT.	A/PS2	N/A		FIXED	I
2	FULL HT.	A/PS2	N/A		FIXED	I	2	FULL HT.	A/PS2	N/A		FIXED	I
3	FULL HT.	A/PS2	N/A		FIXED	I	3	FULL HT.	A/PS2	N/A		FIXED	I
4	FULL HT.	A/PS2	N/A		SLIDING	I	4	FULL HT.	A/PS2	N/A		SLIDING	I
5	FULL HT.	A/PS2	N/A		SLIDING	I	5	FULL HT.	A/PS2	N/A		SLIDING	I
6	FULL HT.	A/PS2	N/A		FIXED	II	6	FULL HT.	A/PS2	N/A		FIXED	II
7	110'	A/PS2	BALANCE OF PIER HT.	B/PS2	FIXED	II	7	90'	A/PS2	BALANCE OF PIER HT.	B/PS2	FIXED	II
8	FULL HT.	A/PS2	N/A		SLIDING	II	8	FULL HT.	A/PS2	N/A		SLIDING	II
9	FULL HT.	A/PS2	N/A		FIXED	II	9	FULL HT.	A/PS2	N/A		FIXED	II
10	FULL HT.	A/PS2	N/A		FIXED	II	10	28'	A/PS2	BALANCE OF PIER HT.	B/PS2	FIXED	II
11	FULL HT.	A/PS2	N/A		FIXED	II	11	FULL HT.	A/PS2	N/A		FIXED	II
12	FULL HT.	A/PS2	N/A		SLIDING	II	12	FULL HT.	A/PS2	N/A		SLIDING	II
13	FULL HT.	A/PS2	N/A		SLIDING	II	13	FULL HT.	A/PS2	N/A		SLIDING	II
14	50'	A/PS2	BALANCE OF PIER HT.	B/PS2	FIXED	II	14	50'	A/PS2	BALANCE OF PIER HT.	B/PS2	FIXED	II
15	50'	A/PS2	BALANCE OF PIER HT.	B/PS2	FIXED	II	15	FULL HT.	A/PS2	N/A		FIXED	II
16	50'	A/PS2	BALANCE OF PIER HT.	B/PS2	FIXED	II	16	50'	A/PS2	BALANCE OF PIER HT.	B/PS2	FIXED	II
17	FULL HT.	A/PS2	N/A		SLIDING	II	17	FULL HT.	A/PS2	N/A		SLIDING	II
18	FULL HT.	A/PS2	N/A		FIXED	II	18	FULL HT.	A/PS2	N/A		FIXED	II
19	FULL HT.	A/PS2	N/A		FIXED	II	19	FULL HT.	A/PS2	N/A		FIXED	II
20	FULL HT.	A/PS2	N/A		FIXED	II	20	FULL HT.	A/PS2	N/A		FIXED	II
21	FULL HT.	A/PS2	N/A		FIXED	II	21	40'	A/PS2	BALANCE OF PIER HT.	B/PS2	FIXED	II
22	65'	A/PS2	BALANCE OF PIER HT.	B/PS2	FIXED	II	22	50'	A/PS2	BALANCE OF PIER HT.	B/PS2	FIXED	II
23	FULL HT.	A/PS2	N/A		SLIDING	II	23	FULL HT.	A/PS2	N/A		SLIDING	II

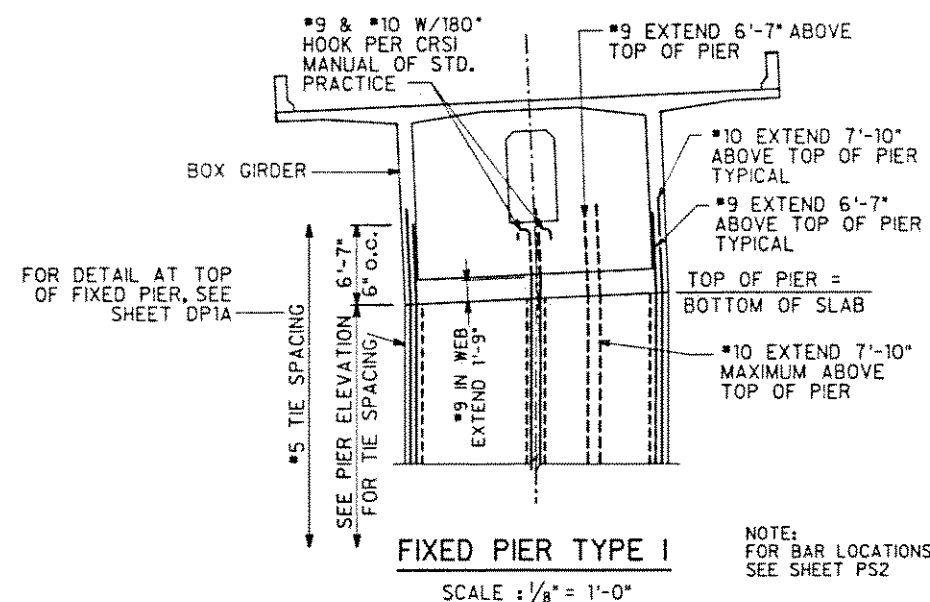

06/21/91	UPDATED DRAWING
05/03/91	UPDATED DRAWING
04/05/91	UPDATED SCHEDULE
12/13/90	ADD PIERS 21-23 I.B.
12/10/90	ADD PIERS 17-20 I.B. & O.B.
12/05/90	ADD PIERS 21-23 O.B.
10/25/90	ADD PIERS 13-16 I.B.
10/04/90	UPDATED DRAWING
9/26/90	ADD PIERS 9-16 O.B.
9/14/90	ADD PIERS 9, 10, & 12 I.B.
7/16/90	SHOW REINFORCING ON FIXED PIER
6/29/90	ADD PIERS 5 & 6

DATE	REVISION
J. MULLER INTERNATIONAL	Libby Engineers

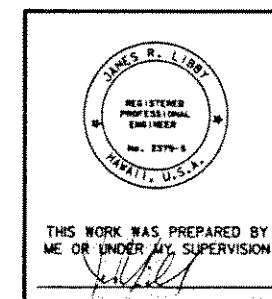

STATE OF HAWAII
DEPARTMENT OF TRANSPORTATION HIGHWAYS DIVISION
PIER SCHEDULE
INTERSTATE ROUTE H-3 F.A.I. PROJECT No. I-H3-1(57) F.A.I. PROJECT No. I-H3-1(58)
SCALE : AS NOTED
DATE : JUNE 1990
SHEET NO. PS1 OF SHEETS