
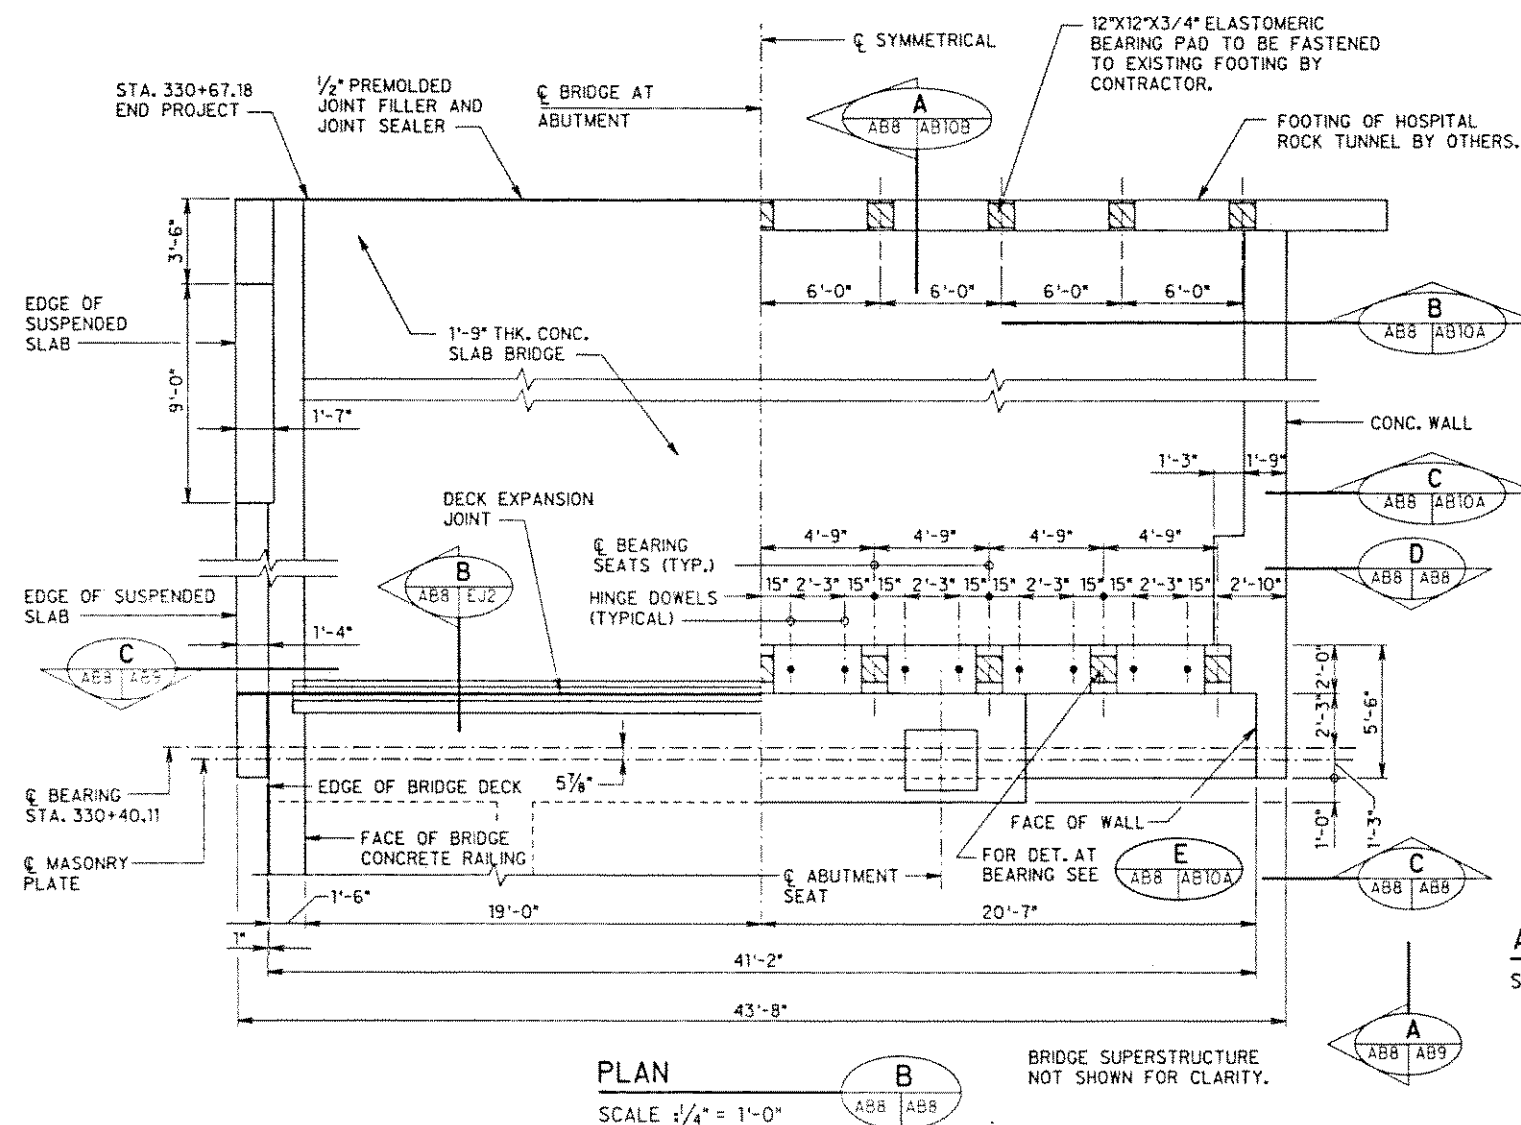
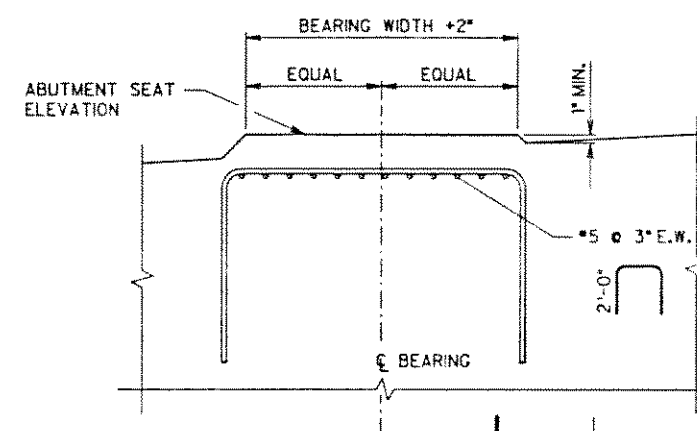
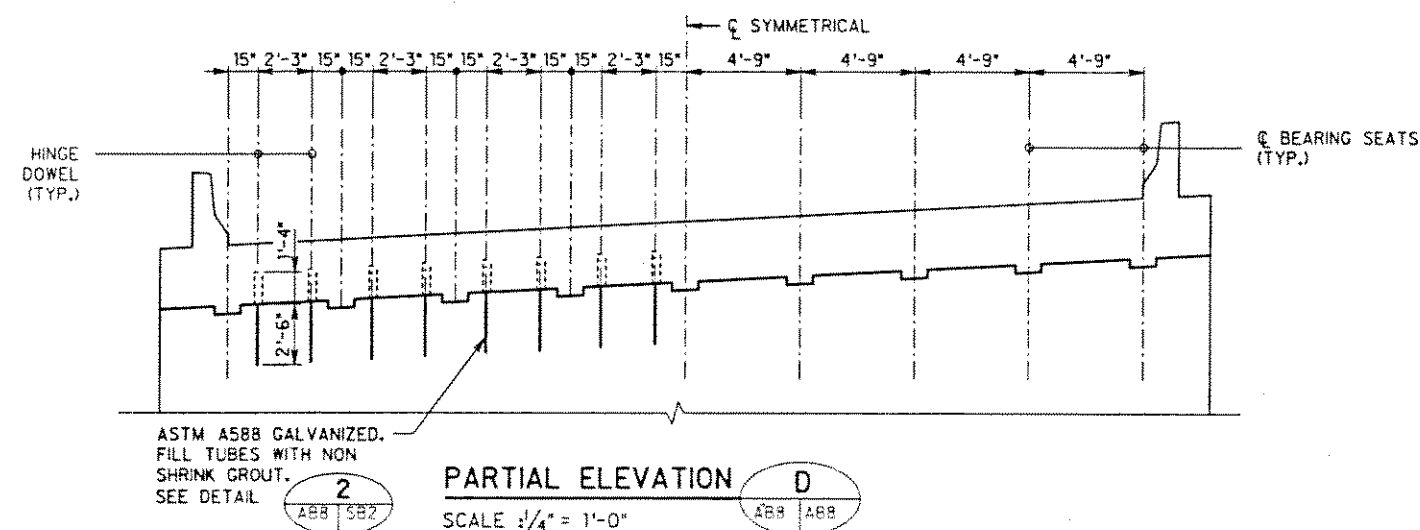
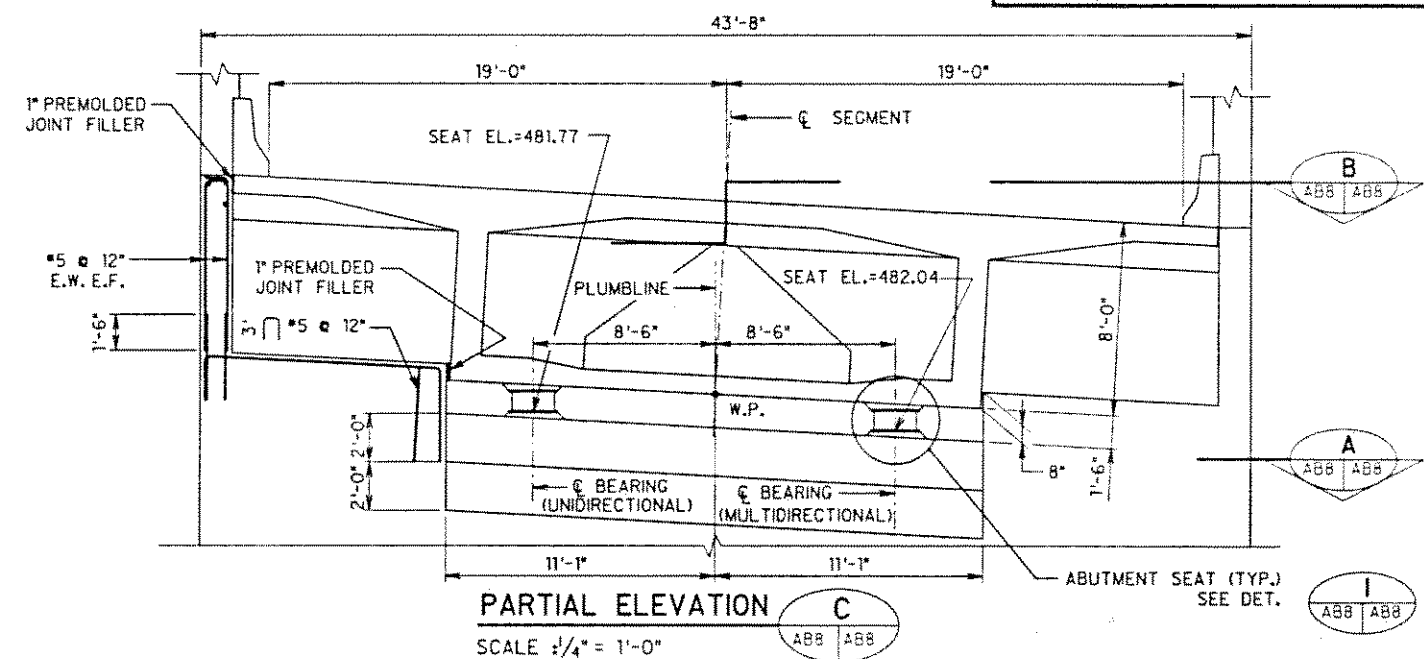


FED. ROAD DIST. NO.	STATE	FED. AID PROJ. NO.	FISCAL YEAR	SHEET NO.	TOTAL SHEETS
HAWAII	HAW.	I-H3-1(57)	1988		

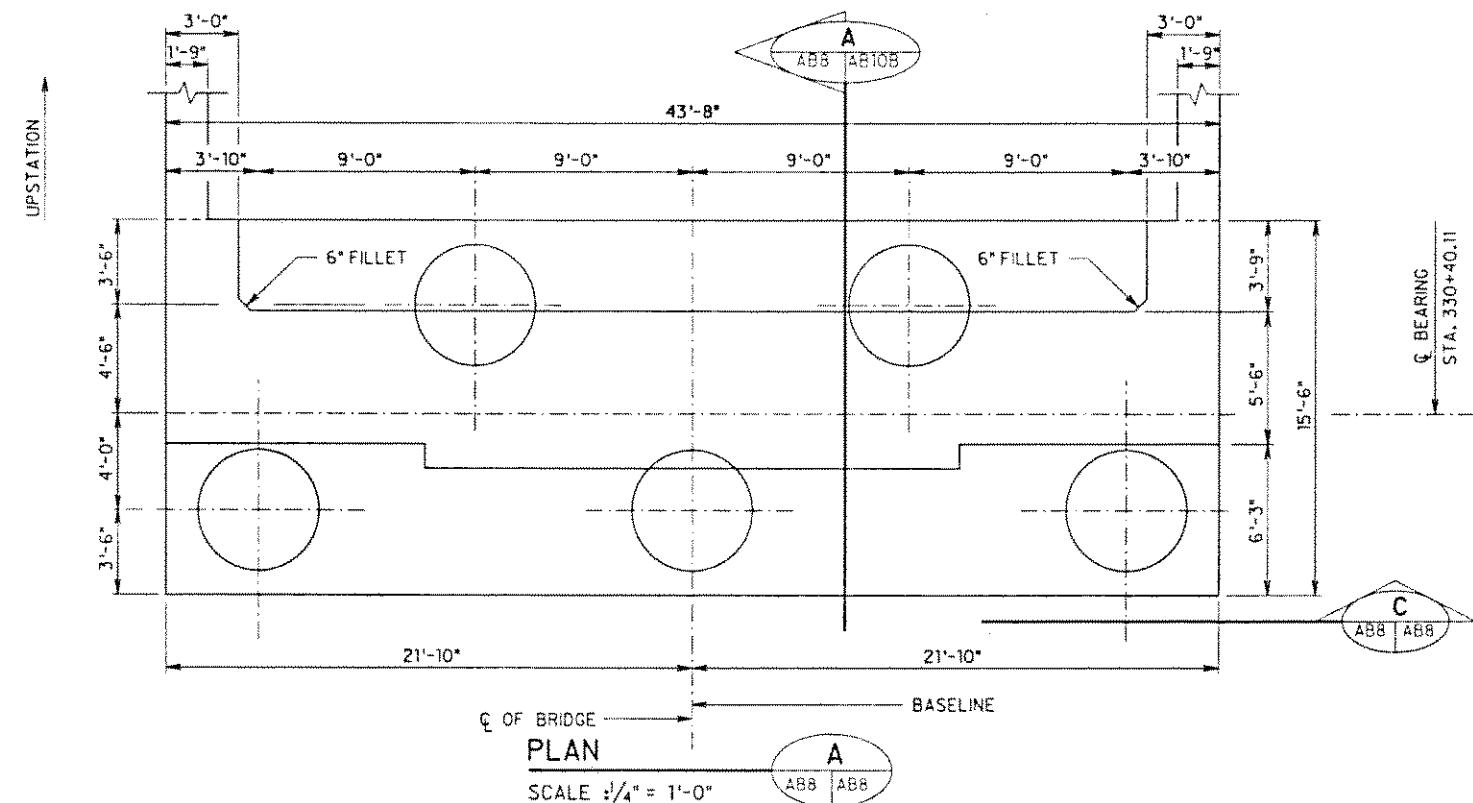

DATE

REVISION

J. MULLER INTERNATIONAL


Libby Engineers

STATE OF HAWAII
DEPARTMENT OF TRANSPORTATION
HIGHWAYS DIVISION

PLANS AND ELEVATIONS
OUTBOUND ABUTMENT 2

INTERSTATE ROUTE H-3
F.A.I. PROJECT No. I-H3-1(57)
F.A.I. PROJECT No. I-H3-1(58)
SCALE: AS NOTED DATE: JUN 1991

SHEET No. AB8 OF SHEETS

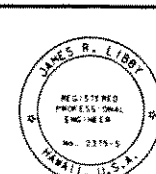

THIS WORK WAS PREPARED BY ME OR UNDER MY SUPERVISION