


ORIGINAL PLAN	SURVEY PLOTTED BY _____	DATE _____
	DRAWN BY _____	
	TRAINED BY _____	
NOTE BOOK	DESIGNED BY _____	
	QUANTITIES BY _____	
N _o	CHECKED BY _____	

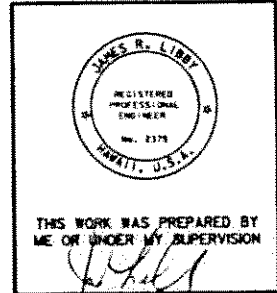


I=INBOUND (O=OUTBOUND)

ABUTMENT No. → I A1-2 → SEGMENT RANGE No. IN THE SPAN FROM THE ABUTMENT

SHEET No. 51 OF SHEETS

FED. ROAD DIST. NO.	STATE	FED. AID PROJ. NO.	FISCAL YEAR	SHEET NO.	TOTAL SHEETS
HAWAII	HAW.	I-H3-1(57)	1988		

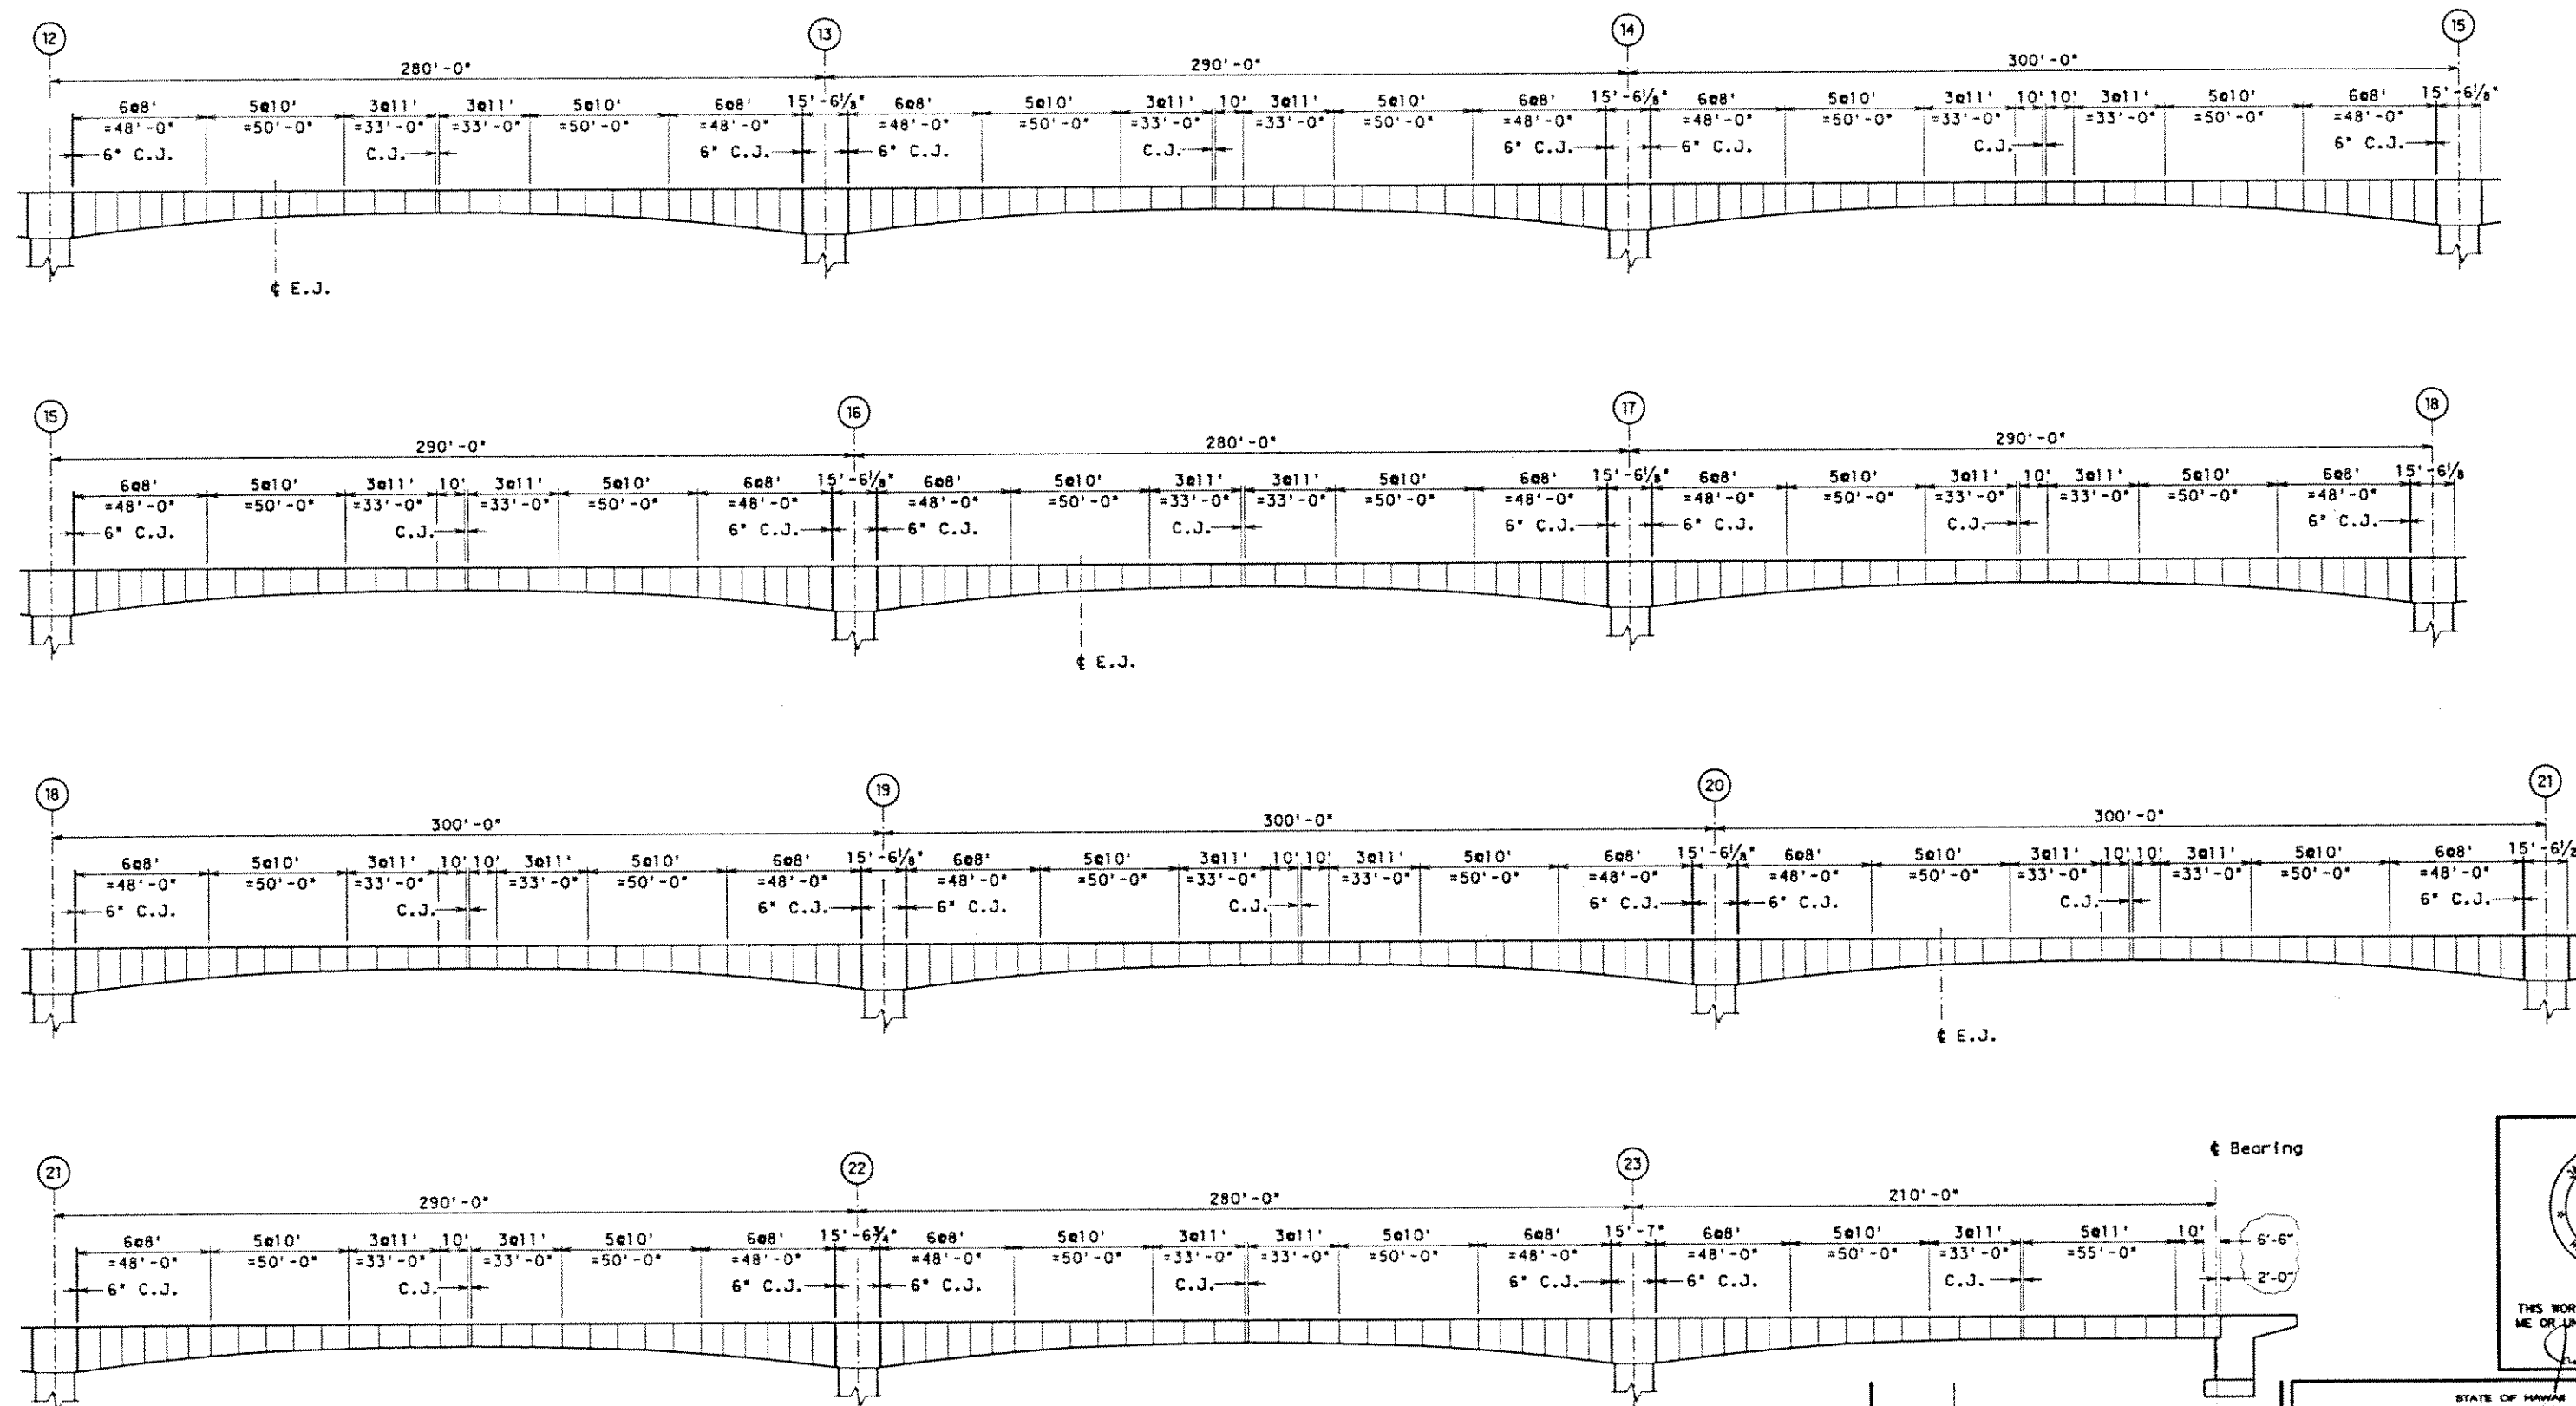

I=INBOUND (O=OUTBOUND) U=UPSTATION SIDE (D=DOWNSTATION SIDE)

PIER No. 13-12U SEGMENT RANGE No. IN THE CANTILEVER FROM THE PIER

ABUTMENT No. 1A1-2 SEGMENT RANGE No. IN THE SPAN FROM THE ABUTMENT

SEGMENT DESIGNATION

07/02/91 UPDATED DRAWING.

DATE REVISION

J. MULLER INTERNATIONAL Libby Engineers

STATE OF HAWAII
DEPARTMENT OF TRANSPORTATION
HIGHWAYS DIVISION

SEGMENT LAYOUT II
I.B. STA. 296+65.53 TO
I.B. STA. 330+77.29

INTERSTATE ROUTE H-3

F.A.I. PROJECT No. I-H3-1(57)

F.A.I. PROJECT No. I-H3-1(58)

SCALE: AS NOTED DATE: JUN. 1990

SHEET No. 52 OF SHEETS



THIS WORK WAS PREPARED BY
ME OR UNDER MY SUPERVISION

James R. Libby

DESIGNED BY
CHECKED BY
DATE
NOTED BY
DATE