


FED. ROAD DIST. NO.	STATE	FED. AID PROJ. NO.	FISCAL YEAR	SHEET NO.	TOTAL SHEETS
HAWAII	HAW.	I-H3-1(57)	1988		

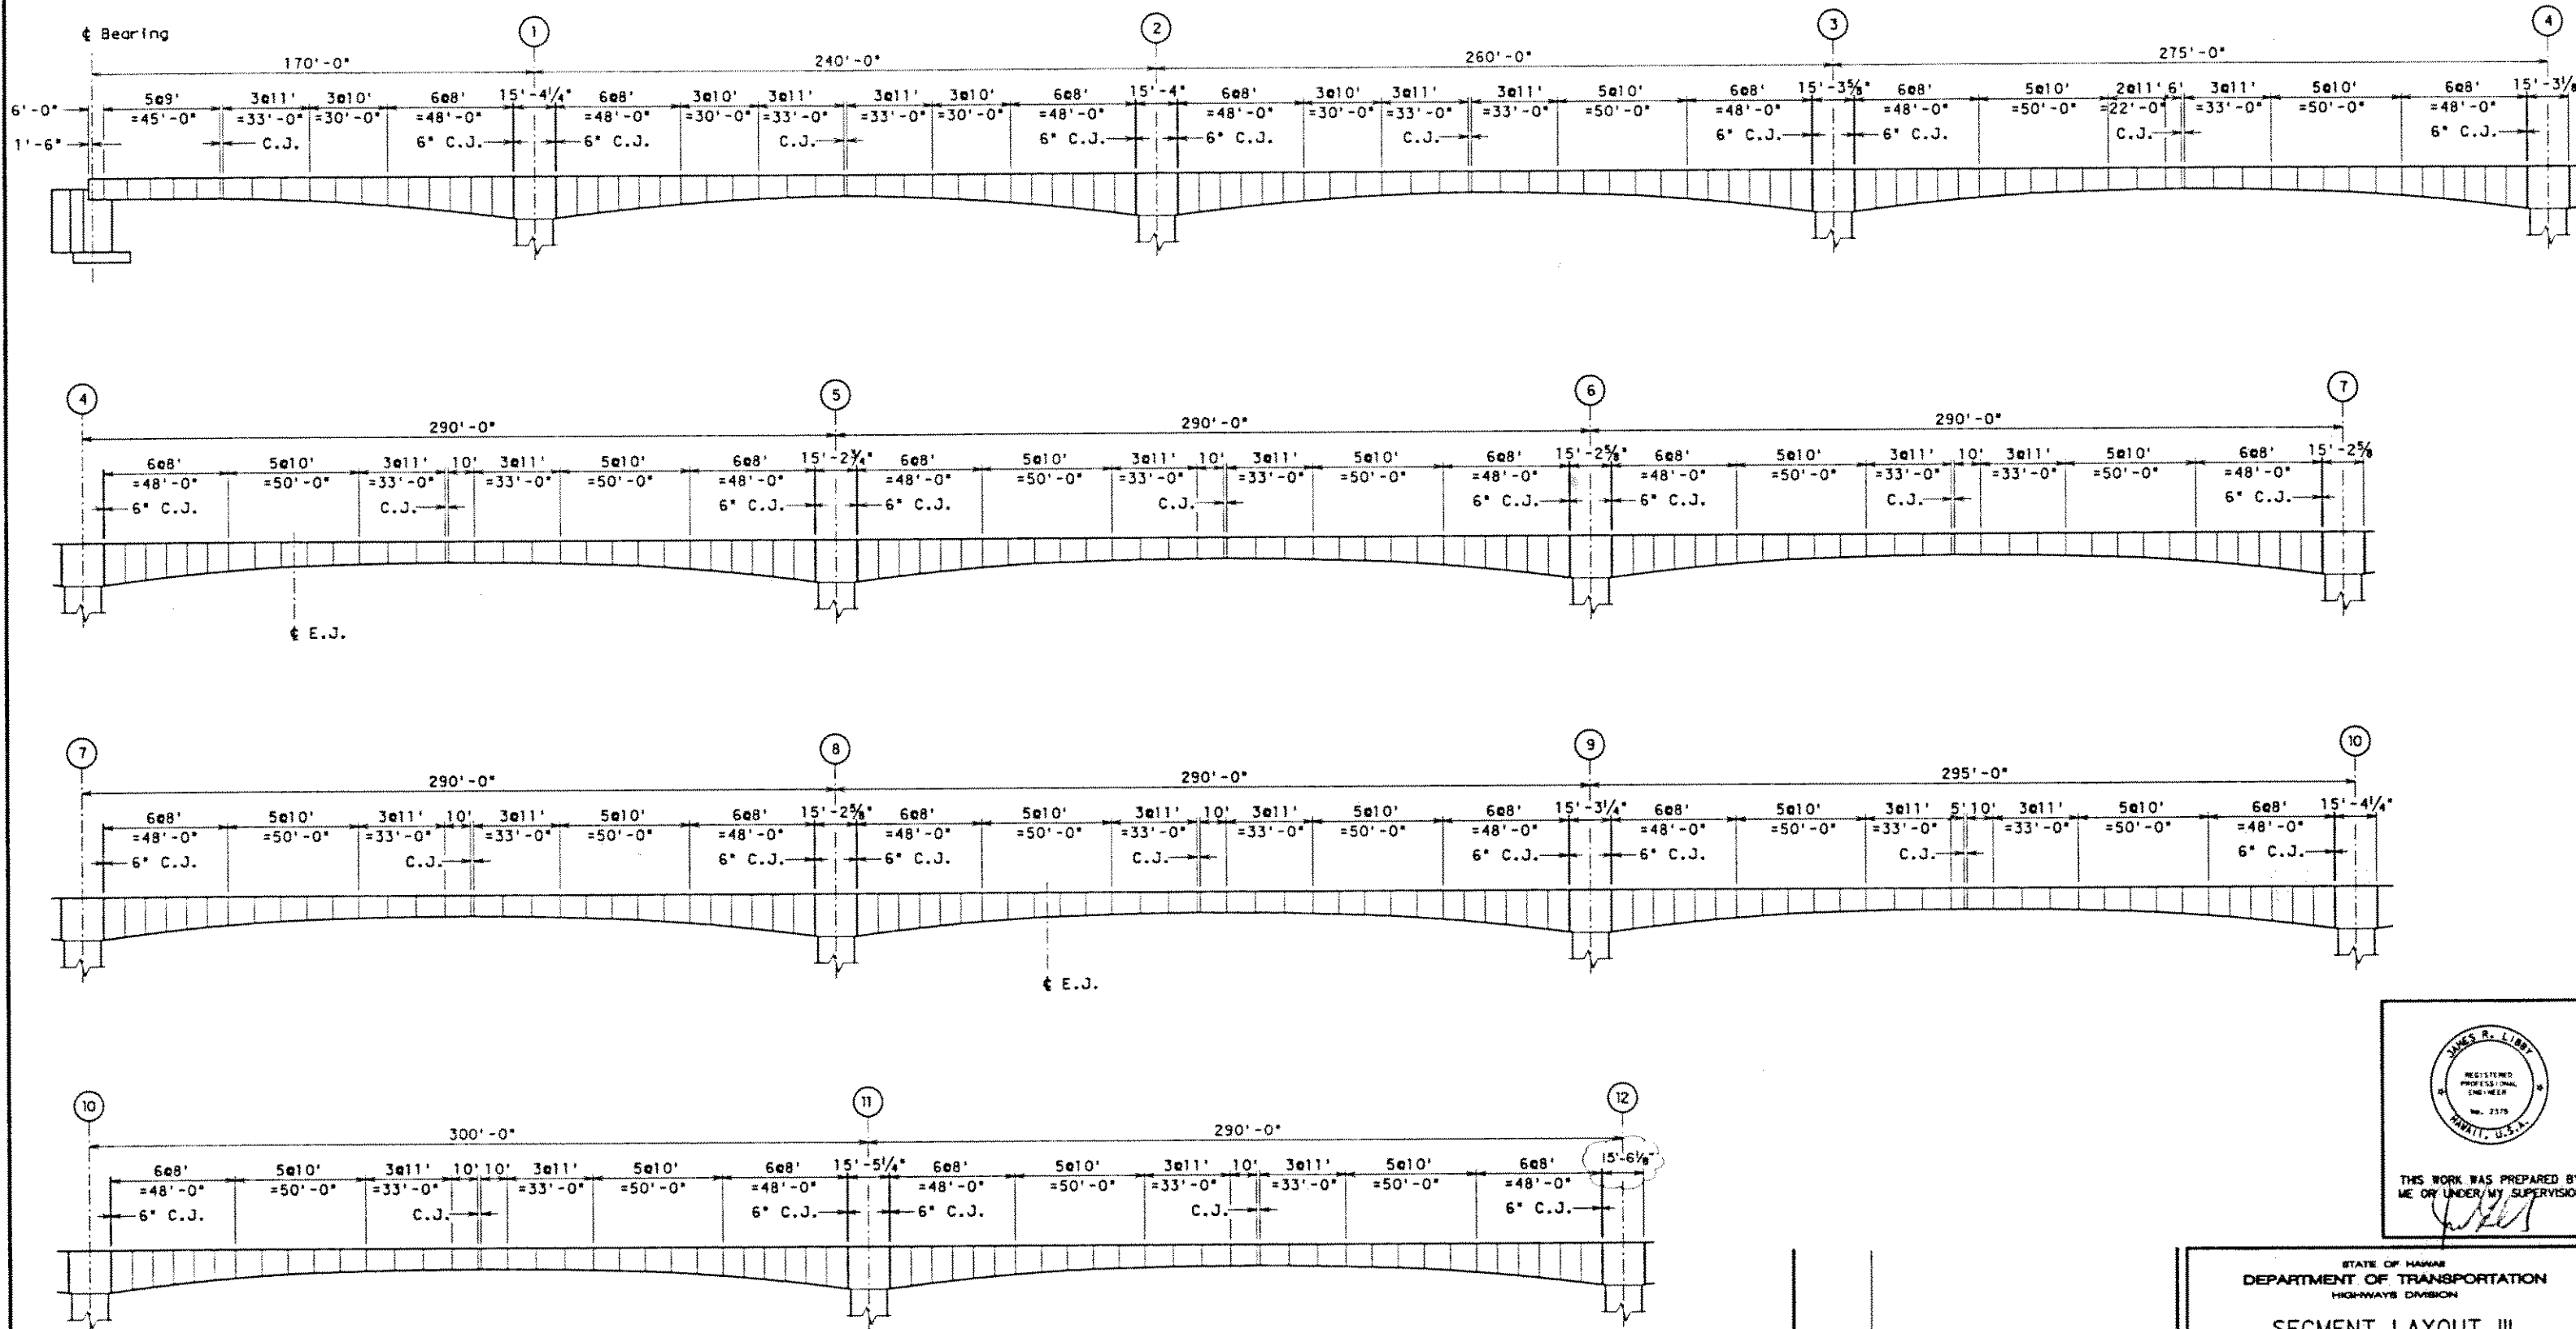


I=INBOUND (O=OUTBOUND) U=UPSTATION SIDE (O=DOWNSTATION SIDE)

PIER No. 13-12U SEGMENT RANGE No. IN THE CANTILEVER FROM THE PIER

ABUTMENT No. 1A1-2 SEGMENT RANGE No. IN THE SPAN FROM THE ABUTMENT

SEGMENT DESIGNATION

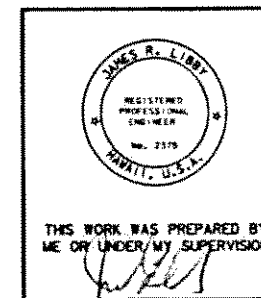

08/23/91 UPDATED PIER SEGMENT LENGTH.
DATE REVISION

J. MULLER INTERNATIONAL Libby Engineers

STATE OF HAWAII
DEPARTMENT OF TRANSPORTATION
HIGHWAYS DIVISION


SEGMENT LAYOUT III
O.B. STA. 264+23.36 TO
O.B. STA. 297+05.11

INTERSTATE ROUTE H-3
F.A.I. PROJECT No. I-H3-1(57)
F.A.I. PROJECT No. I-H3-1(58)

SCALE: AS NOTED DATE: JUN. 1990

SHEET No. 53 OF SHEETS

FED. ROAD DIST. NO.	STATE	FED. AID PROJ. NO.	FISCAL YEAR	SHEET NO.	TOTAL SHEETS
HAWAII	HAW.	I-H3-1(57)	1988		

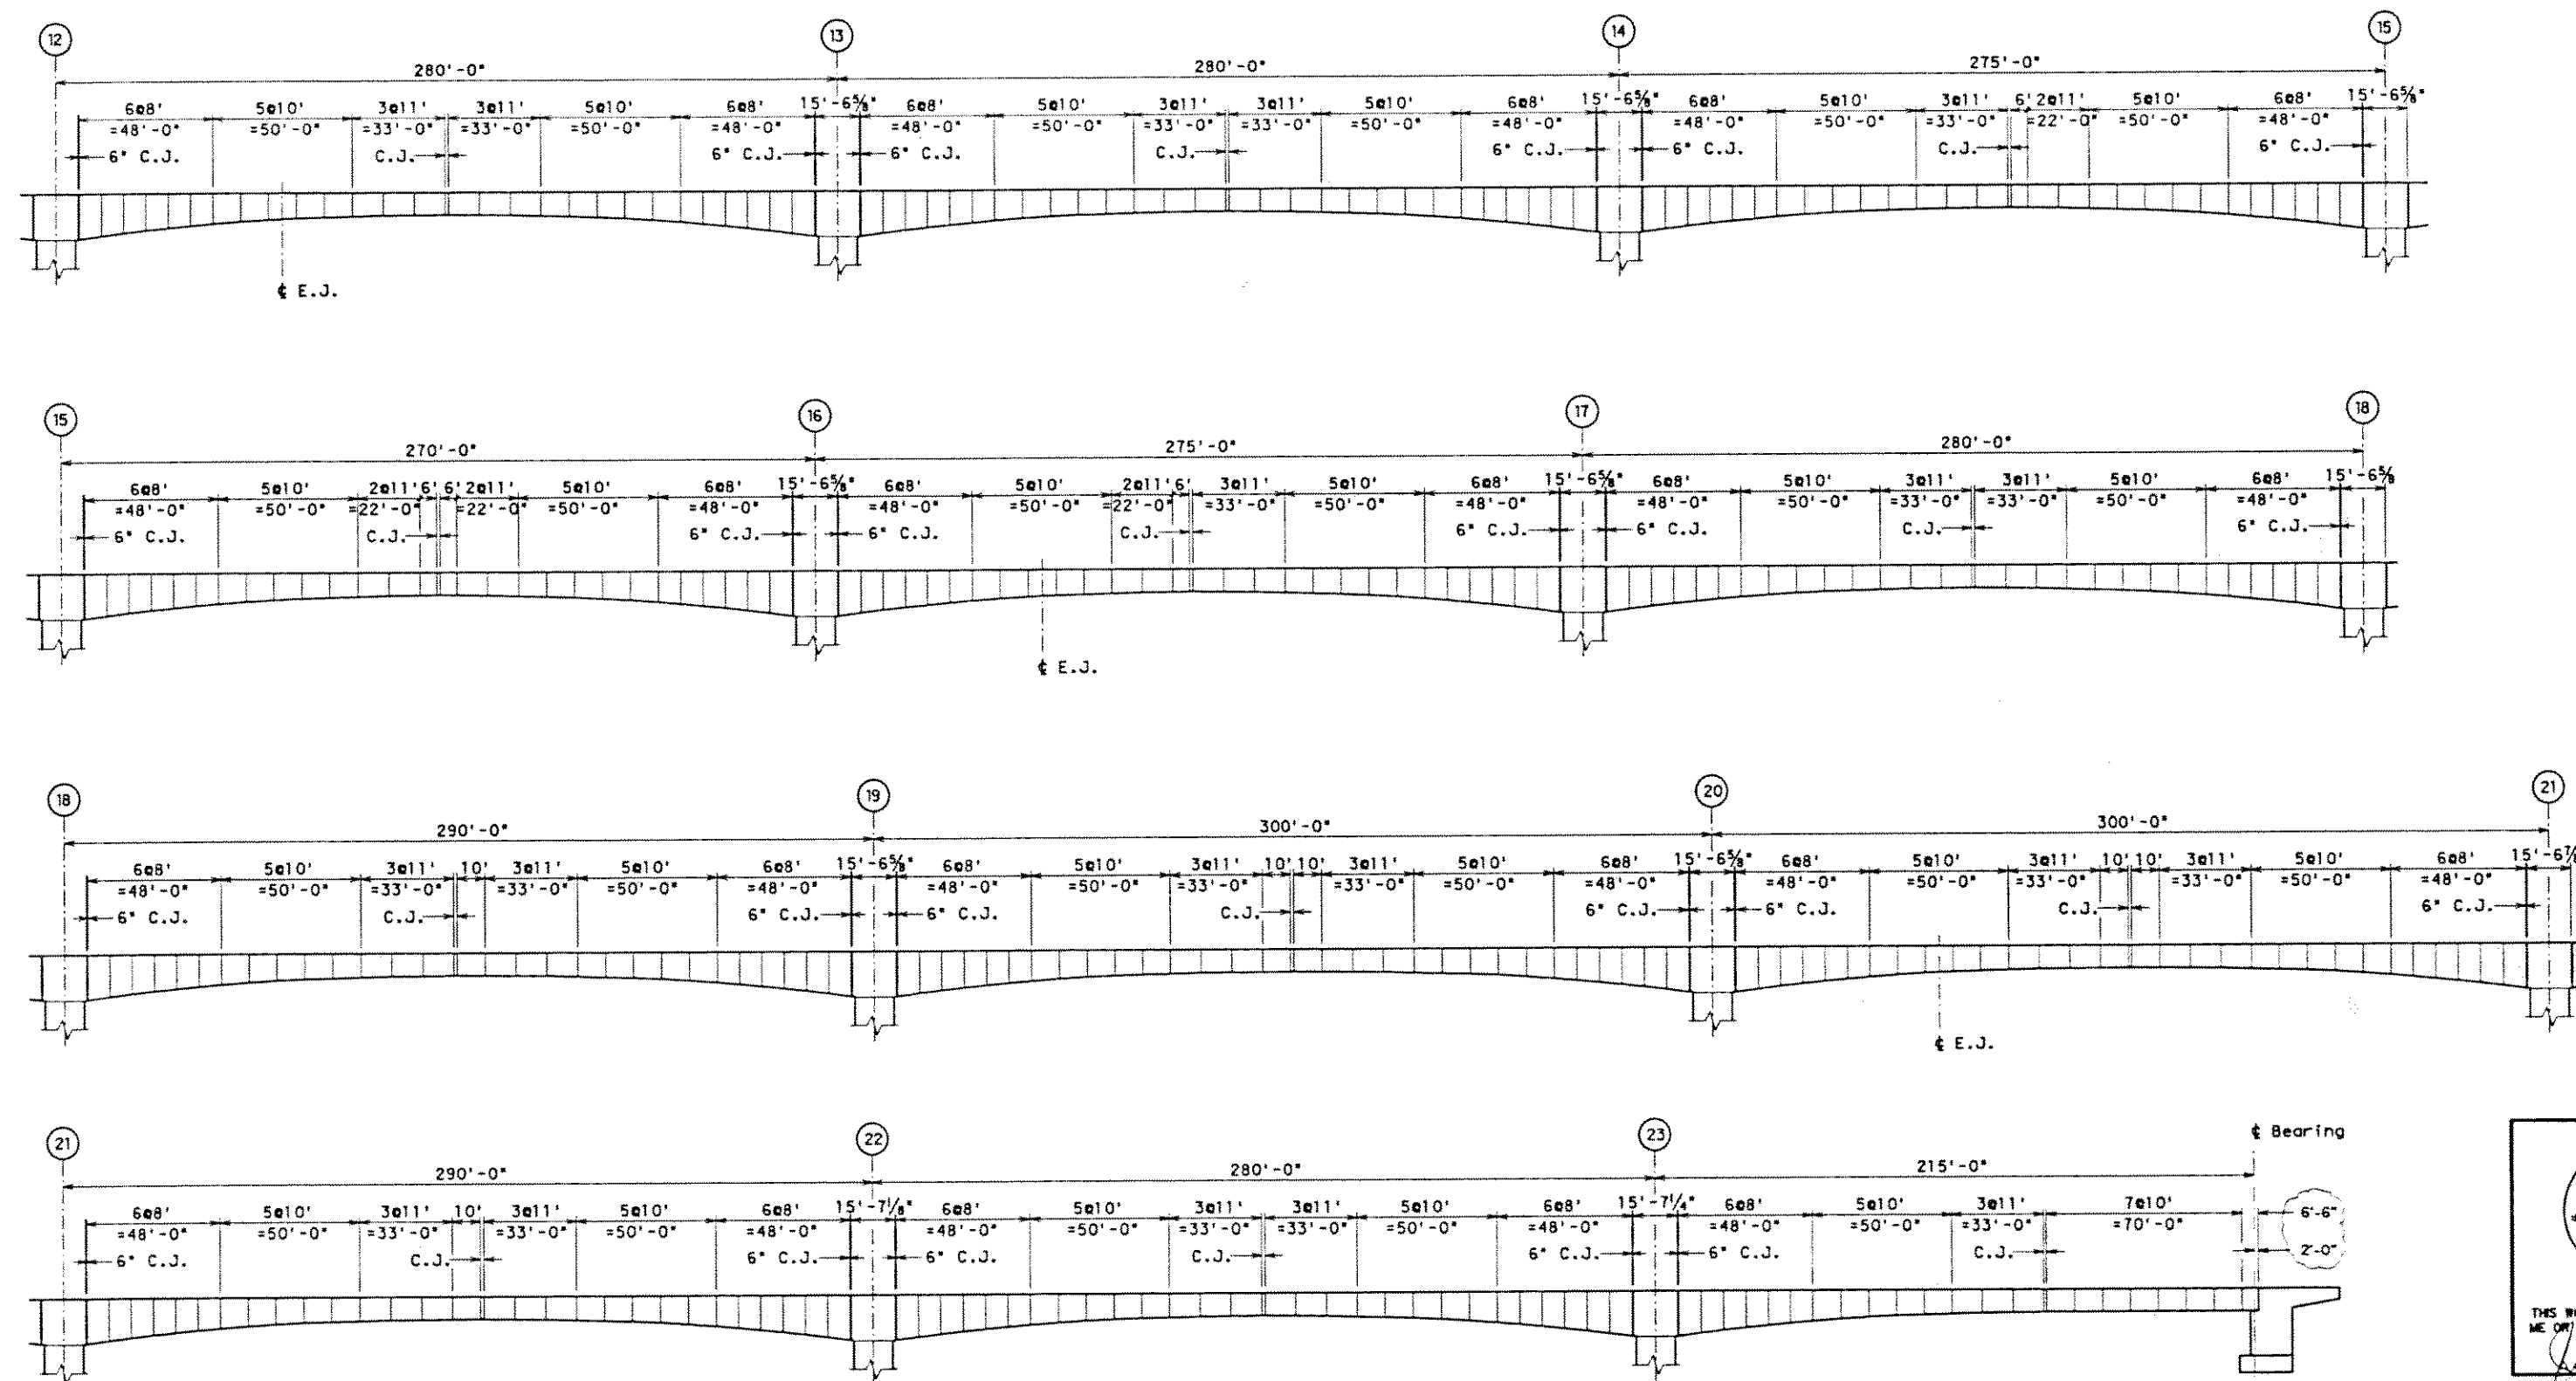

I=INBOUND (O=OUTBOUND) U=UPSTATION SIDE (D=DOWNSTATION SIDE)

PIER No. 13-12U SEGMENT RANGE No. IN THE CANTILEVER FROM THE PIER

ABUTMENT No. 1A1-2 SEGMENT RANGE No. IN THE SPAN FROM THE ABUTMENT

SEGMENT DESIGNATION

07/02/91 UPDATED DRAWING.
DATE REVISION

J. MULLER INTERNATIONAL Libby Engineers

STATE OF HAWAII
DEPARTMENT OF TRANSPORTATION
HIGHWAYS DIVISION

SEGMENT LAYOUT IV

O.B. STA. 297+05.11 TO

O.B. STA. 330+41.86

INTERSTATE ROUTE H-3

F.A.I. PROJECT No. I-H3-1(57)

F.A.I. PROJECT No. I-H3-1(58)

SCALE: AS NOTED DATE: JUN. 1990

SHEET No. 54 OF SHEETS



THIS WORK WAS PREPARED BY
ME OR UNDER MY SUPERVISION