


FED. ROAD DIST. NO.	STATE	FED. AID PROJ. NO.	FISCAL YEAR	SHEET NO.	TOTAL SHEETS
HAWAII	HAW.	I-H3-1(57)	1988		

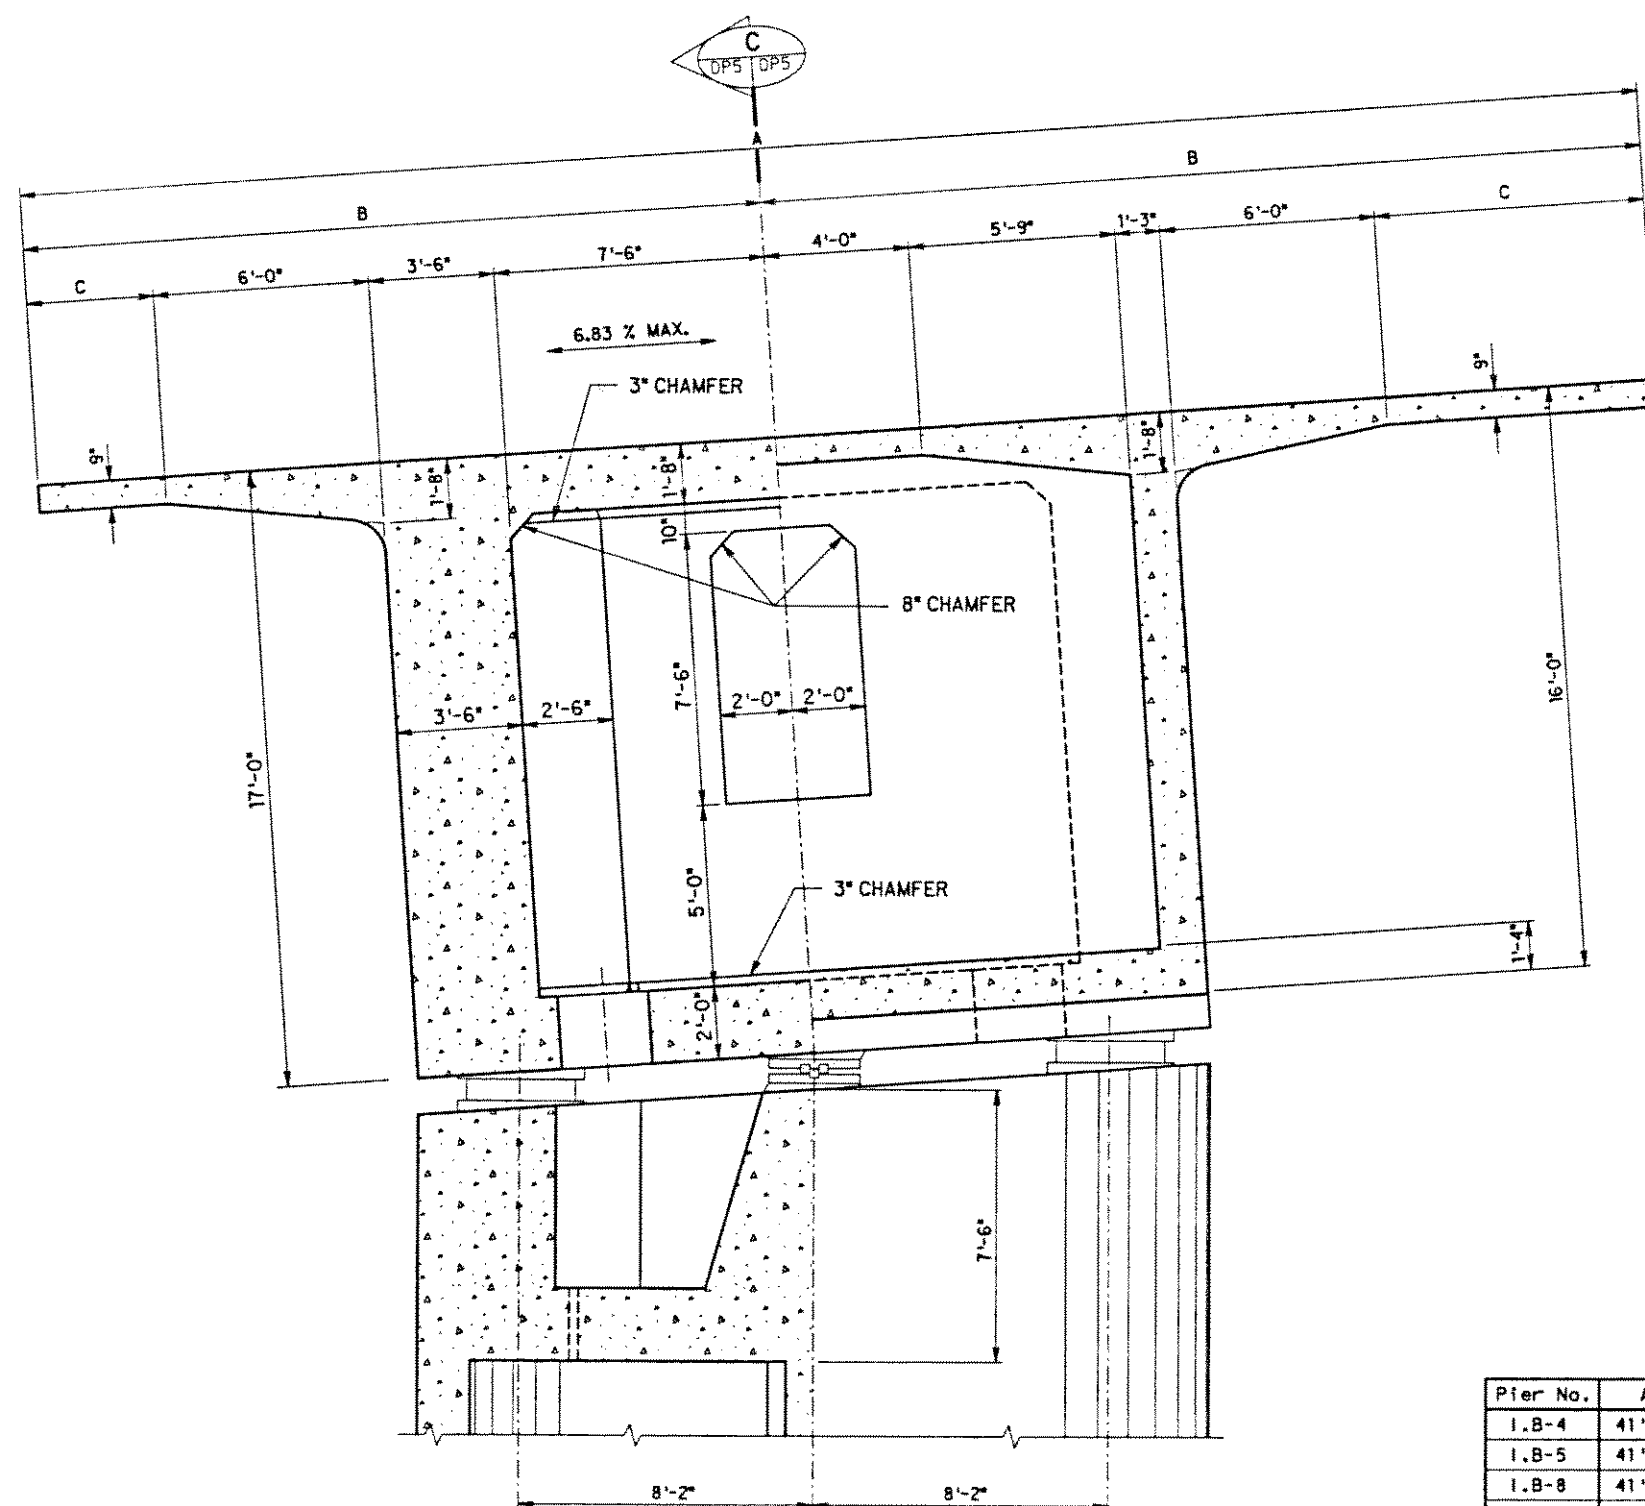

HALF SECTION
SCALE: 3/8" = 1'-0"


A
DPS DPS

HALF SECTION
SCALE: 3/8" = 1'-0"

B
DPS DPS

NOTE: FOR DRAIN HOLE DETAIL SEE SHEET PB1
FOR DETAILS OF CONNECTION AT CLOSURE JOINT SEE SHEET PB5

Pier No.	A	B	C
I.B-4	41'-1"	20'-6 1/2"	3'-6 1/2"
I.B-5	41'-1"	20'-6 1/2"	3'-6 1/2"
I.B-8	41'-1"	20'-6 1/2"	3'-6 1/2"
I.B-12	41'-1"	20'-6 1/2"	3'-6 1/2"
I.B-13	41'-1"	20'-6 1/2"	3'-6 1/2"
I.B-17	41'-1"	20'-6 1/2"	3'-6 1/2"
I.B-23	49'-1"	24'-6 1/2"	7'-6 1/2"
O.B-4	47'-1"	23'-6 1/2"	6'-6 1/2"
O.B-5	47'-1"	23'-6 1/2"	6'-6 1/2"
O.B-8	47'-1"	23'-6 1/2"	6'-6 1/2"
O.B-12	41'-1"	20'-6 1/2"	3'-6 1/2"
O.B-13	41'-1"	20'-6 1/2"	3'-6 1/2"
O.B-17	41'-1"	20'-6 1/2"	3'-6 1/2"
O.B-23	41'-1"	20'-6 1/2"	3'-6 1/2"

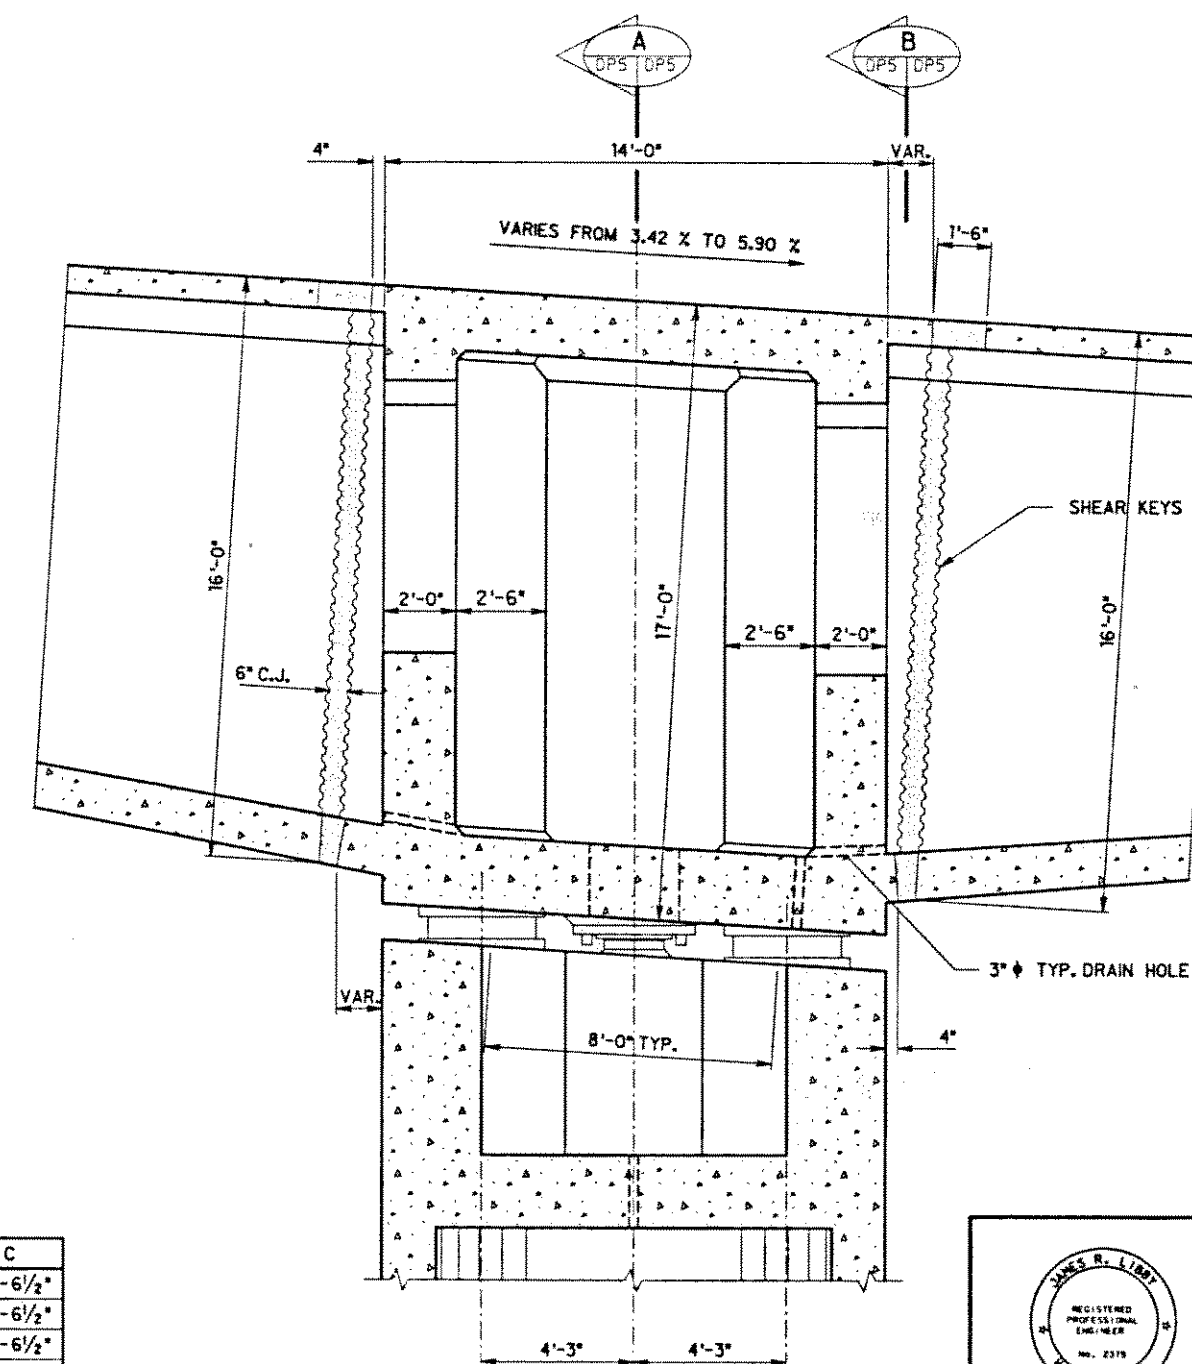

SECTION

SCALE: 3/8" = 1'-0"

C
DPS DPS

4/29/91 UPDATED DRAWING.

DATE REVISION

J. MULLER
INTERNATIONAL

Libby
Engineers

STATE OF HAWAII
DEPARTMENT OF TRANSPORTATION
HIGHWAYS DIVISION

SLIDING PIER SEGMENT
DIMENSIONS
(TYPE I)

INTERSTATE ROUTE H-3

F.A.I. PROJECT No. I-H3-1(57)


F.A.I. PROJECT No. I-H3-1(58)

SCALE: AS NOTED DATE: JUN. 1990

SHEET No. DPSAOF SHEETS

139

FED. ROAD DIST. NO.	STATE	FED. AID PROJ. NO.	FISCAL YEAR	SHEET NO.	TOTAL SHEETS
HAWAII	HAW.	I-H3-1(57)	1988		

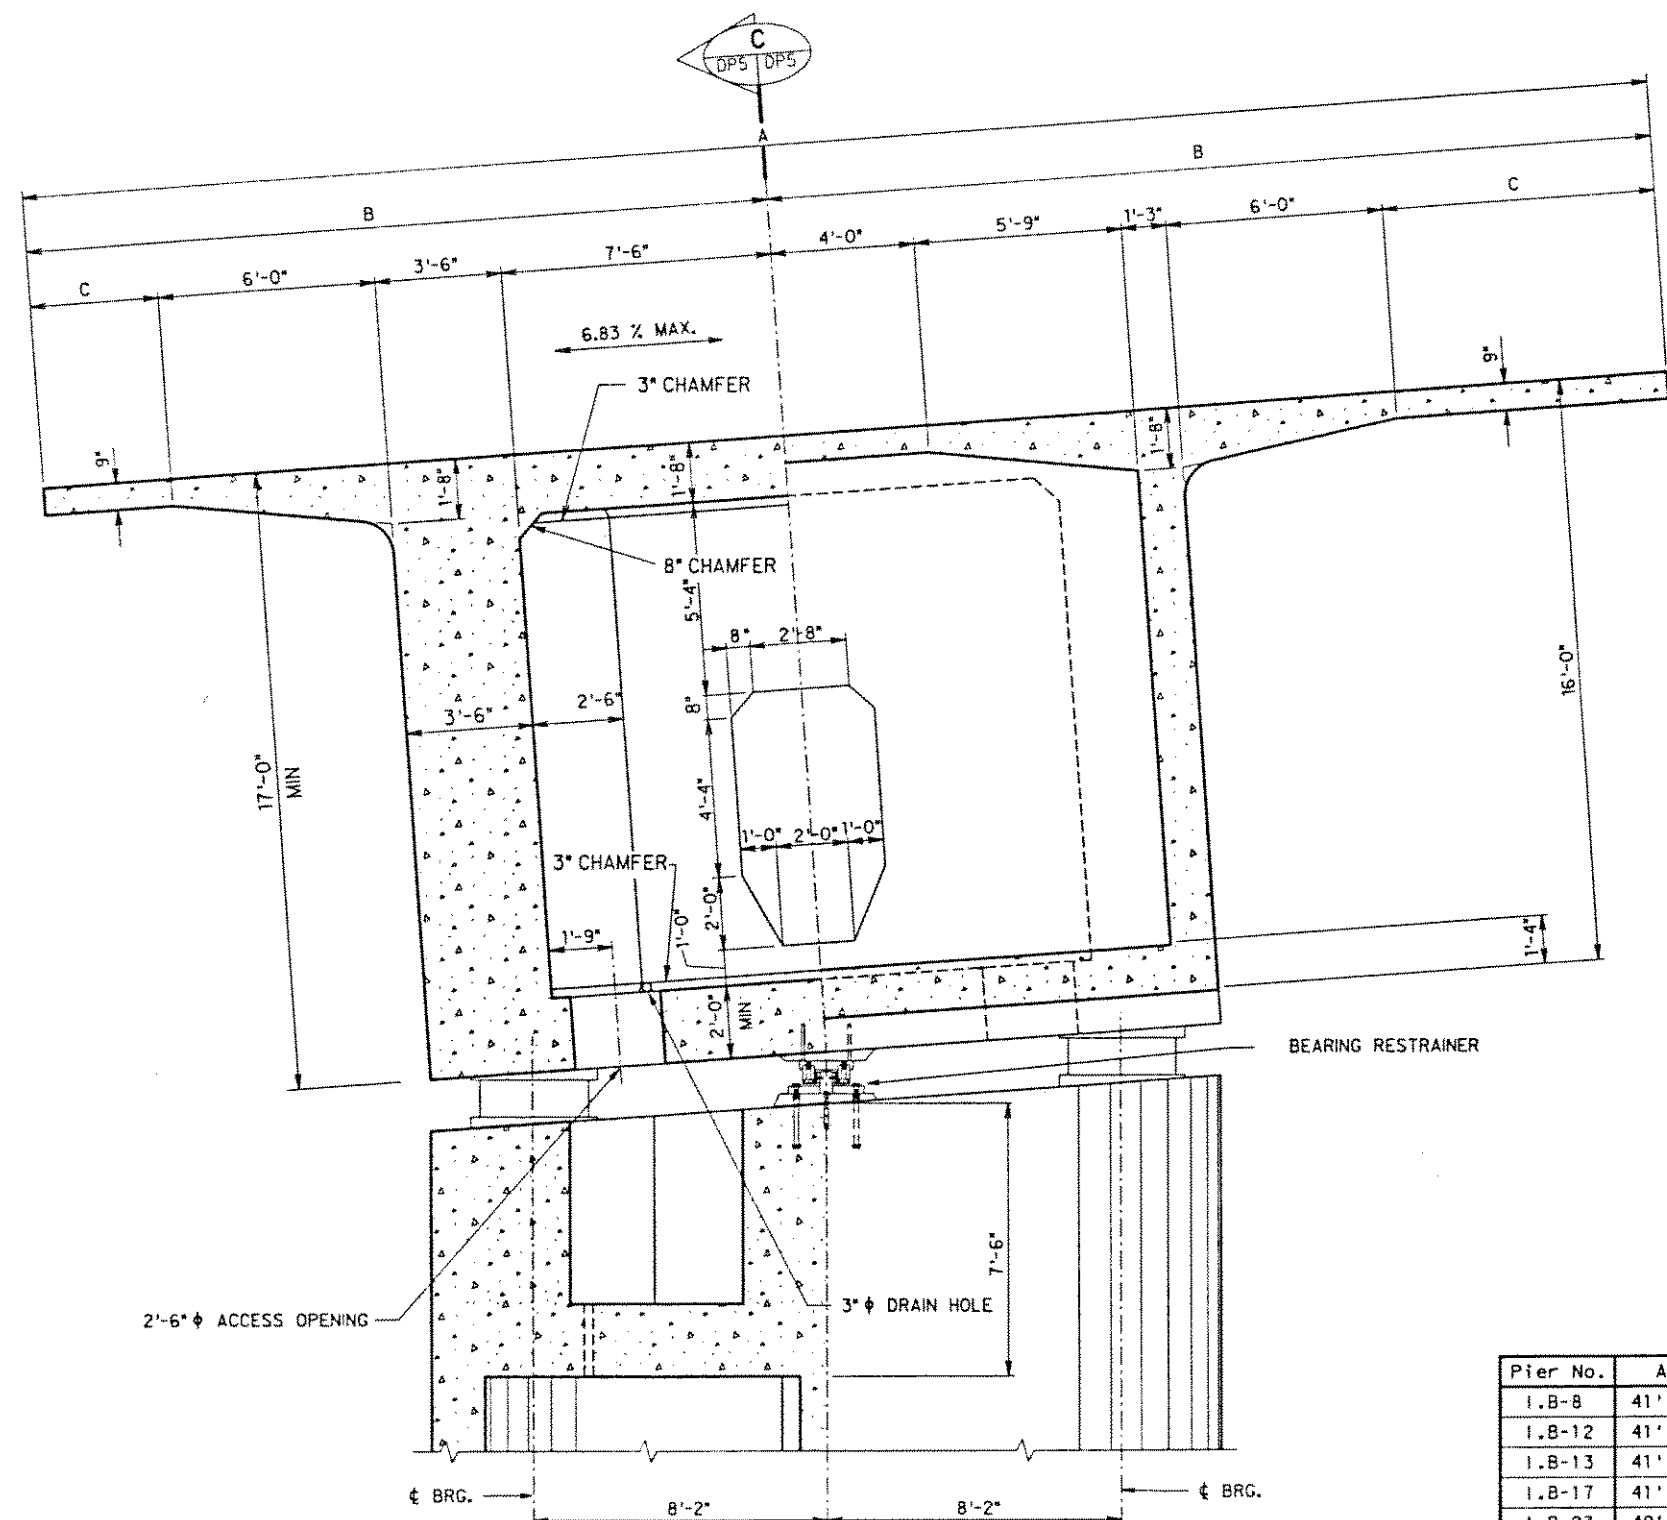


HALF SECTION A
SCALE: 3/8" = 1'-0"

HALF SECTION B
SCALE: 3/8" = 1'-0"

NOTE: FOR DRAIN HOLE DETAIL SEE SHEET PB1
FOR DETAILS OF CONNECTION AT CLOSURE JOINT SEE SHEET PB5

Pier No.	A	B	C
1.B-8	41'-1"	20'-6 1/2"	3'-6 1/2"
1.B-12	41'-1"	20'-6 1/2"	3'-6 1/2"
1.B-13	41'-1"	20'-6 1/2"	3'-6 1/2"
1.B-17	41'-1"	20'-6 1/2"	3'-6 1/2"
1.B-23	49'-1"	24'-6 1/2"	7'-6 1/2"
0.B-8	47'-1"	23'-6 1/2"	6'-6 1/2"
0.B-12	41'-1"	20'-6 1/2"	3'-6 1/2"
0.B-13	41'-1"	20'-6 1/2"	3'-6 1/2"
0.B-17	41'-1"	20'-6 1/2"	3'-6 1/2"
0.B-23	41'-1"	20'-6 1/2"	3'-6 1/2"

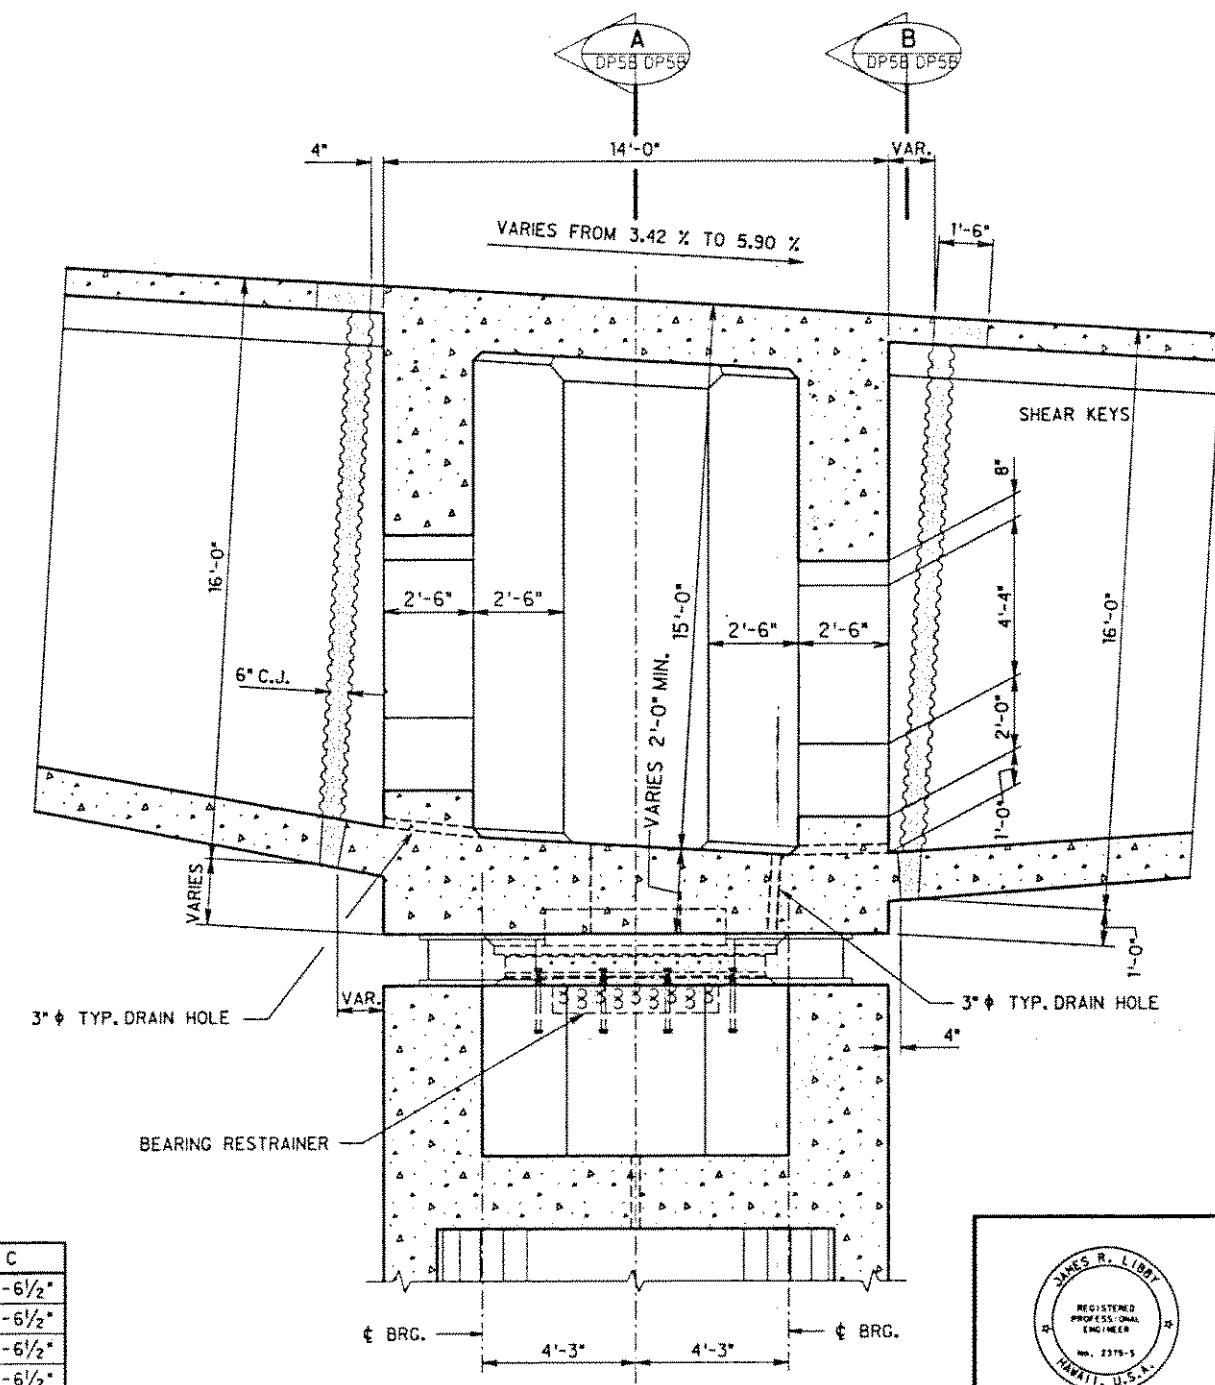

SECTION C
SCALE: 3/8" = 1'-0"

THIS WORK WAS PREPARED BY
ME OR UNDER MY SUPERVISION

DATE

REVISION

J. MULLER INTERNATIONAL

Libby Engineers

STATE OF HAWAII

DEPARTMENT OF TRANSPORTATION

HIGHWAYS DIVISION

SLIDING PIER SEGMENT

DIMENSIONS

TYPE II

INTERSTATE ROUTE H-3

F.A.I. PROJECT No. I-H3-1(57)

F.A.I. PROJECT No. I-H3-1(58)

SCALE: AS NOTED

DATE: APR. 1991

SHEET No. DP5B OF

SHEETS

REVIEWED BY: _____
DATE: _____
DESIGNED BY: _____
CHECKED BY: _____
NOTED BY: _____
DATE: _____