
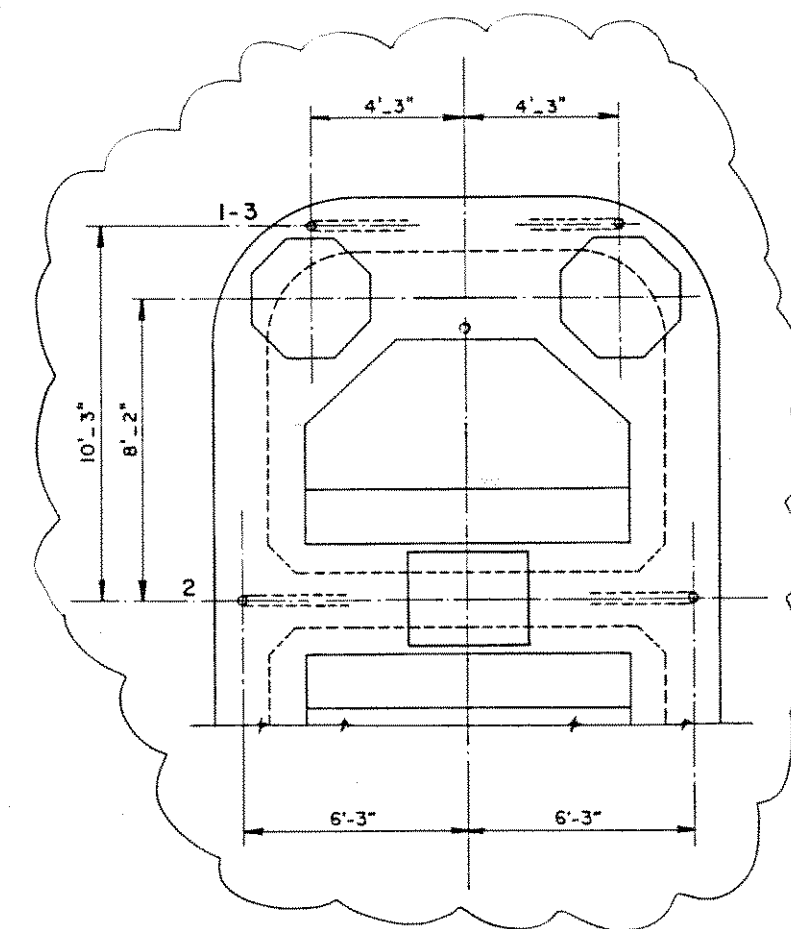
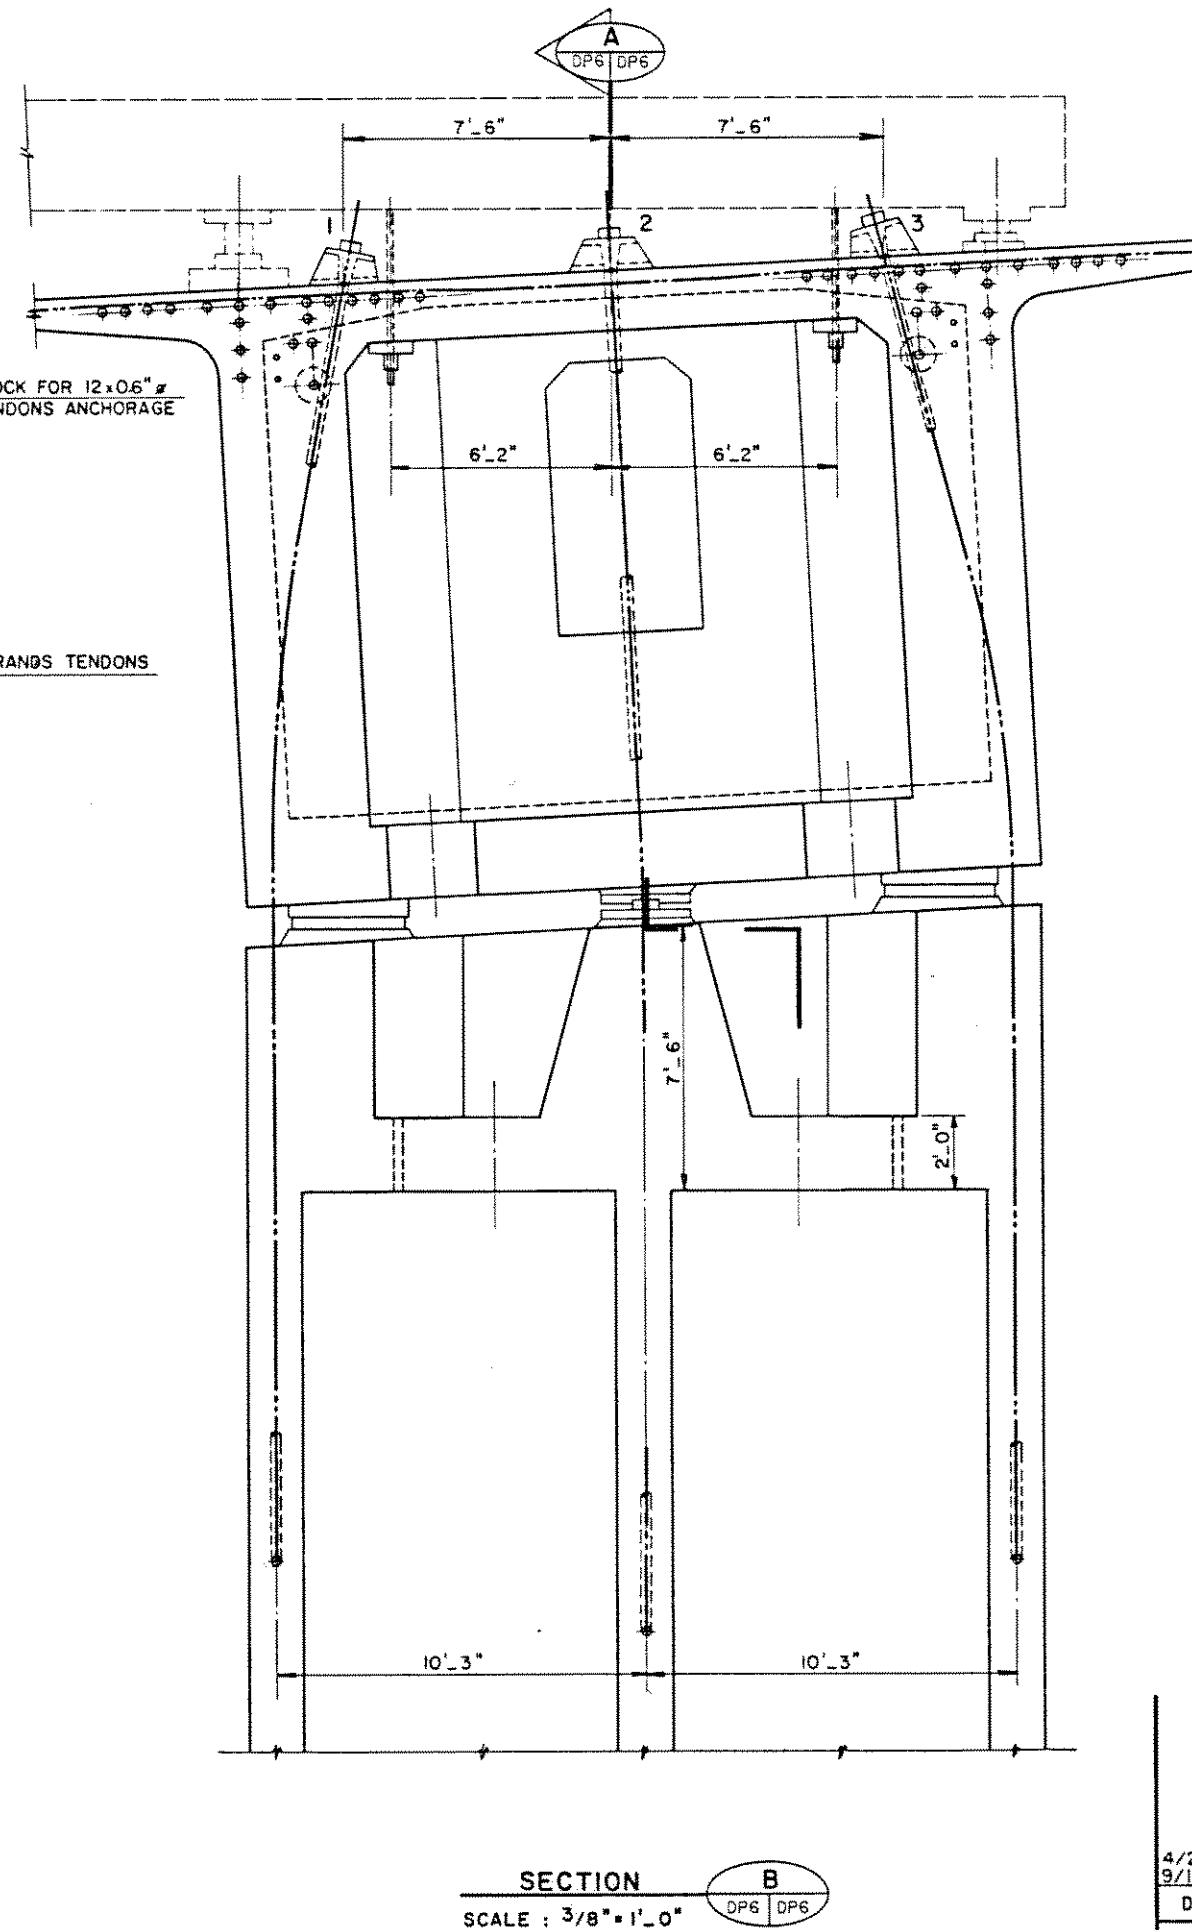


FED. ROAD DIST. NO.	STATE	FED. AID PROJ. NO.	FISCAL YEAR	SHEET NO.	TOTAL SHEETS
HAWAII	HAW.	I-H3-1 (57)	1988		

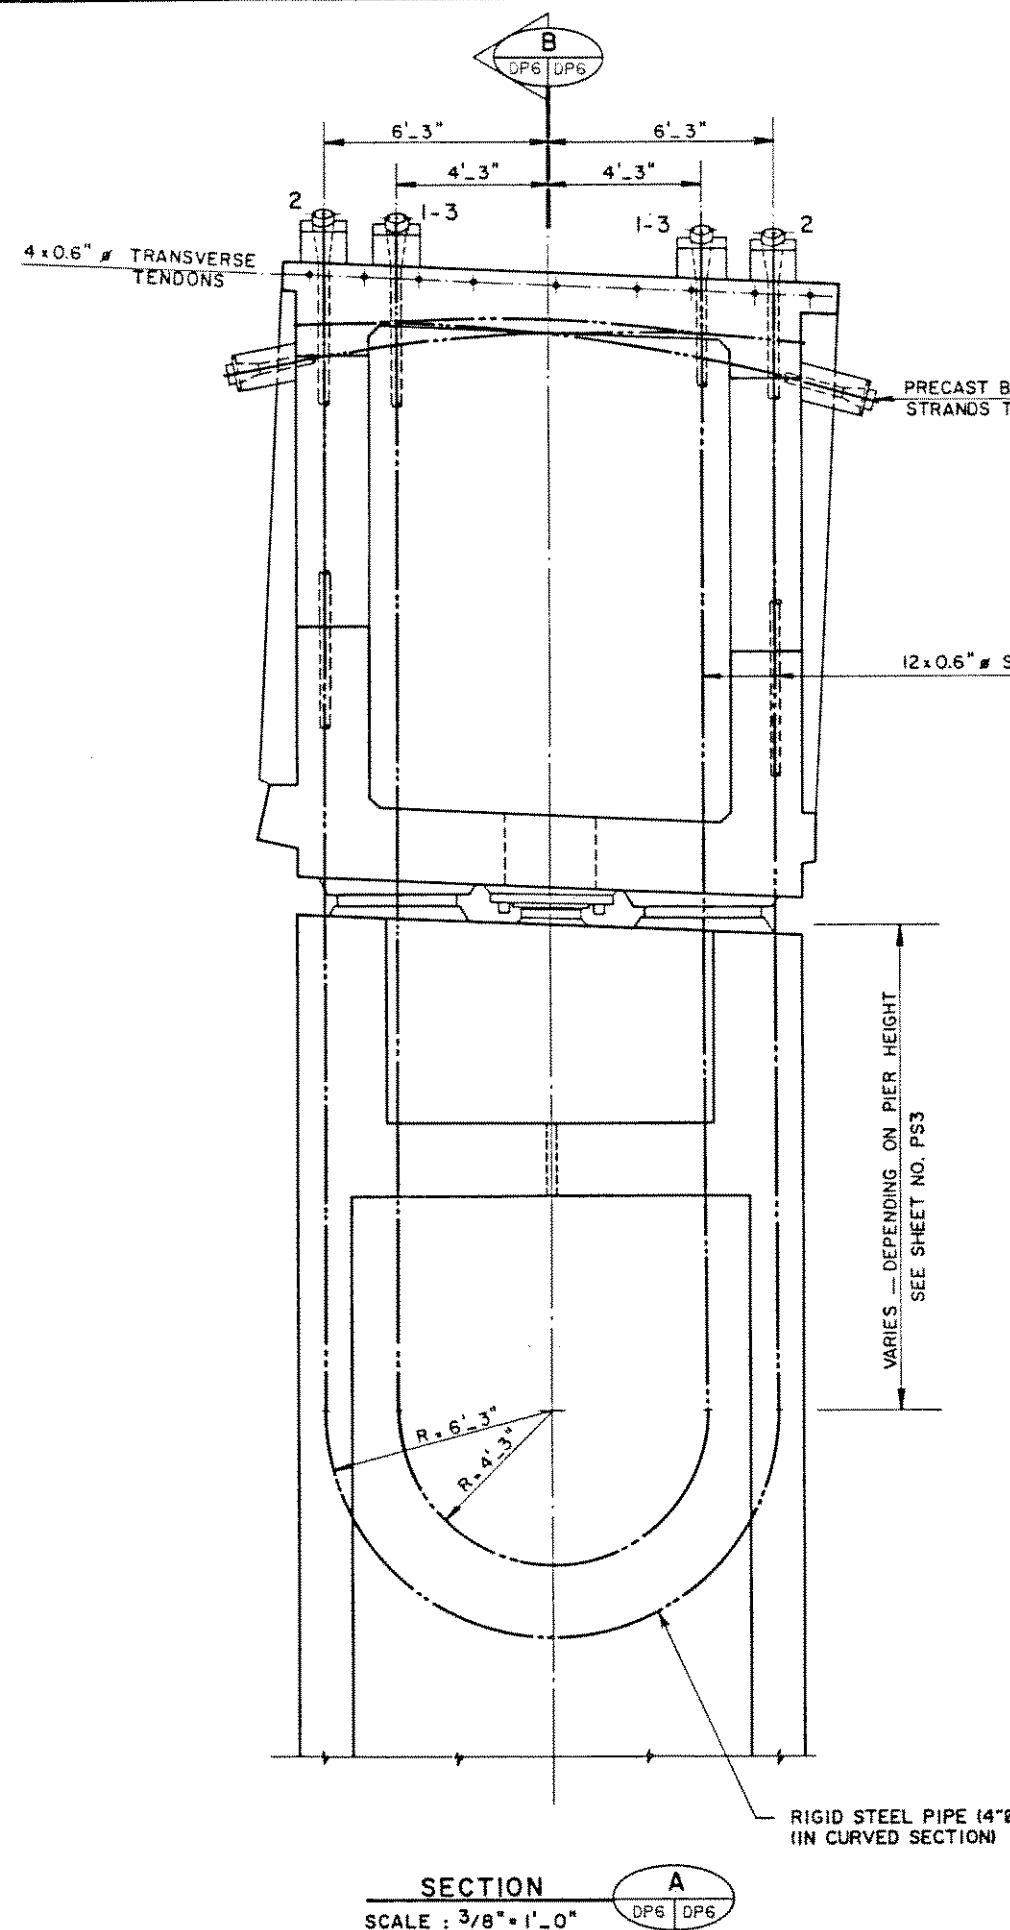

ORIGINAL PLAN	DATE
DRAWN BY	
DESIGNED BY	
NOTED BY	
CHECKED BY	

4/29/91 UPDATED DRAWING.
9/17/90 UPDATED DRAWING.

DATE REVISION

J. MULLER INTERNATIONAL E Libby Engineers

STATE OF HAWAII
DEPARTMENT OF TRANSPORTATION
HIGHWAYS DIVISION

SLIDING PIER SEGMENT
P.T. DETAILS

TYPE 1

INTERSTATE ROUTE H-3

F.A.I. PROJECT No. I-H3-1 (57)

F.A.I. PROJECT No. I-H3-1 (58)



SCALE: AS NOTED DATE: JUN. 1990

SHEET NO. DP6A OF SHEETS




THIS WORK WAS PREPARED BY
ME OR UNDER MY SUPERVISION

FED. ROAD DIST. NO.	STATE	FED. AID PROJ. NO.	FISCAL YEAR	SHEET NO.	TOTAL SHEETS
HAWAII	HAW.	I-H3-1(57)	1988		

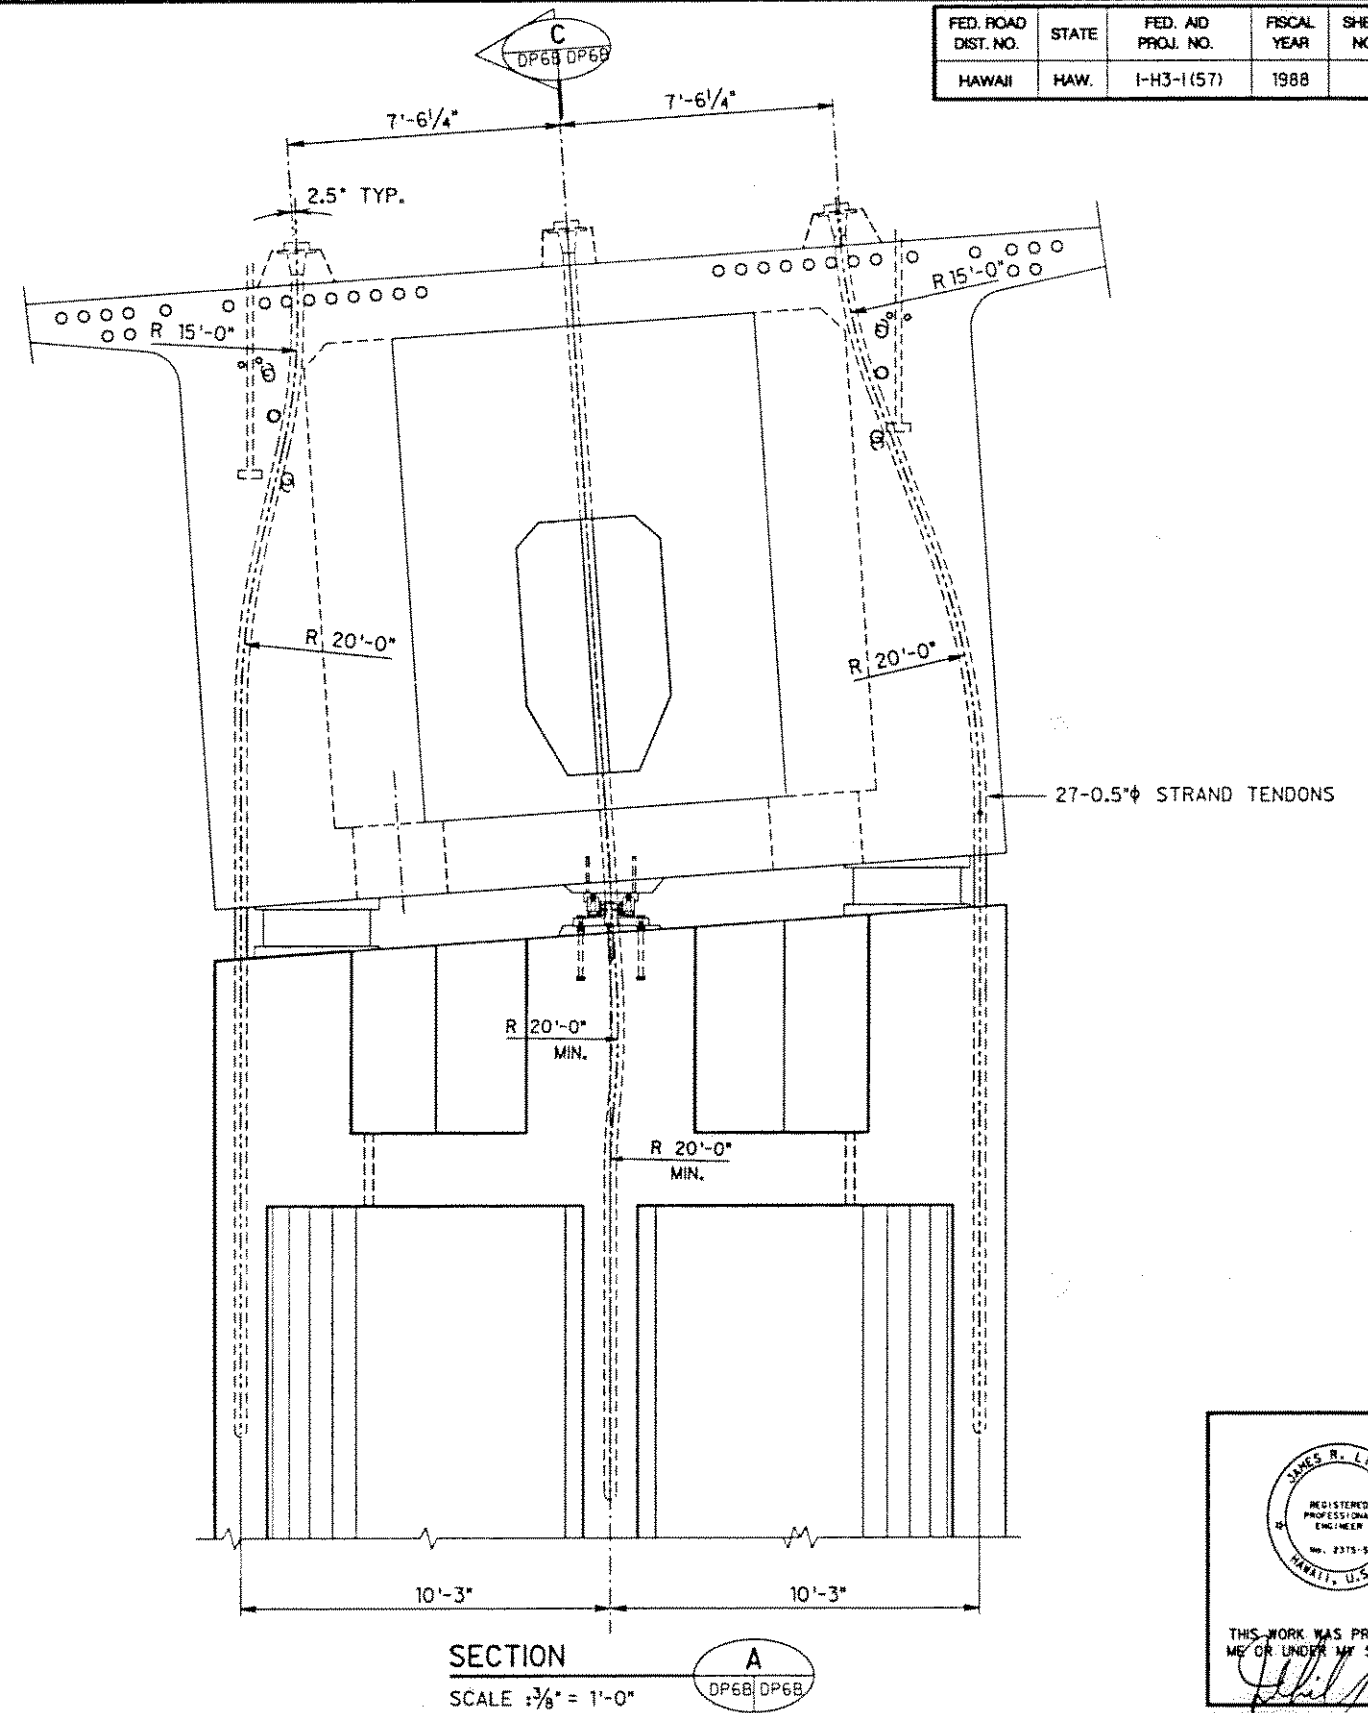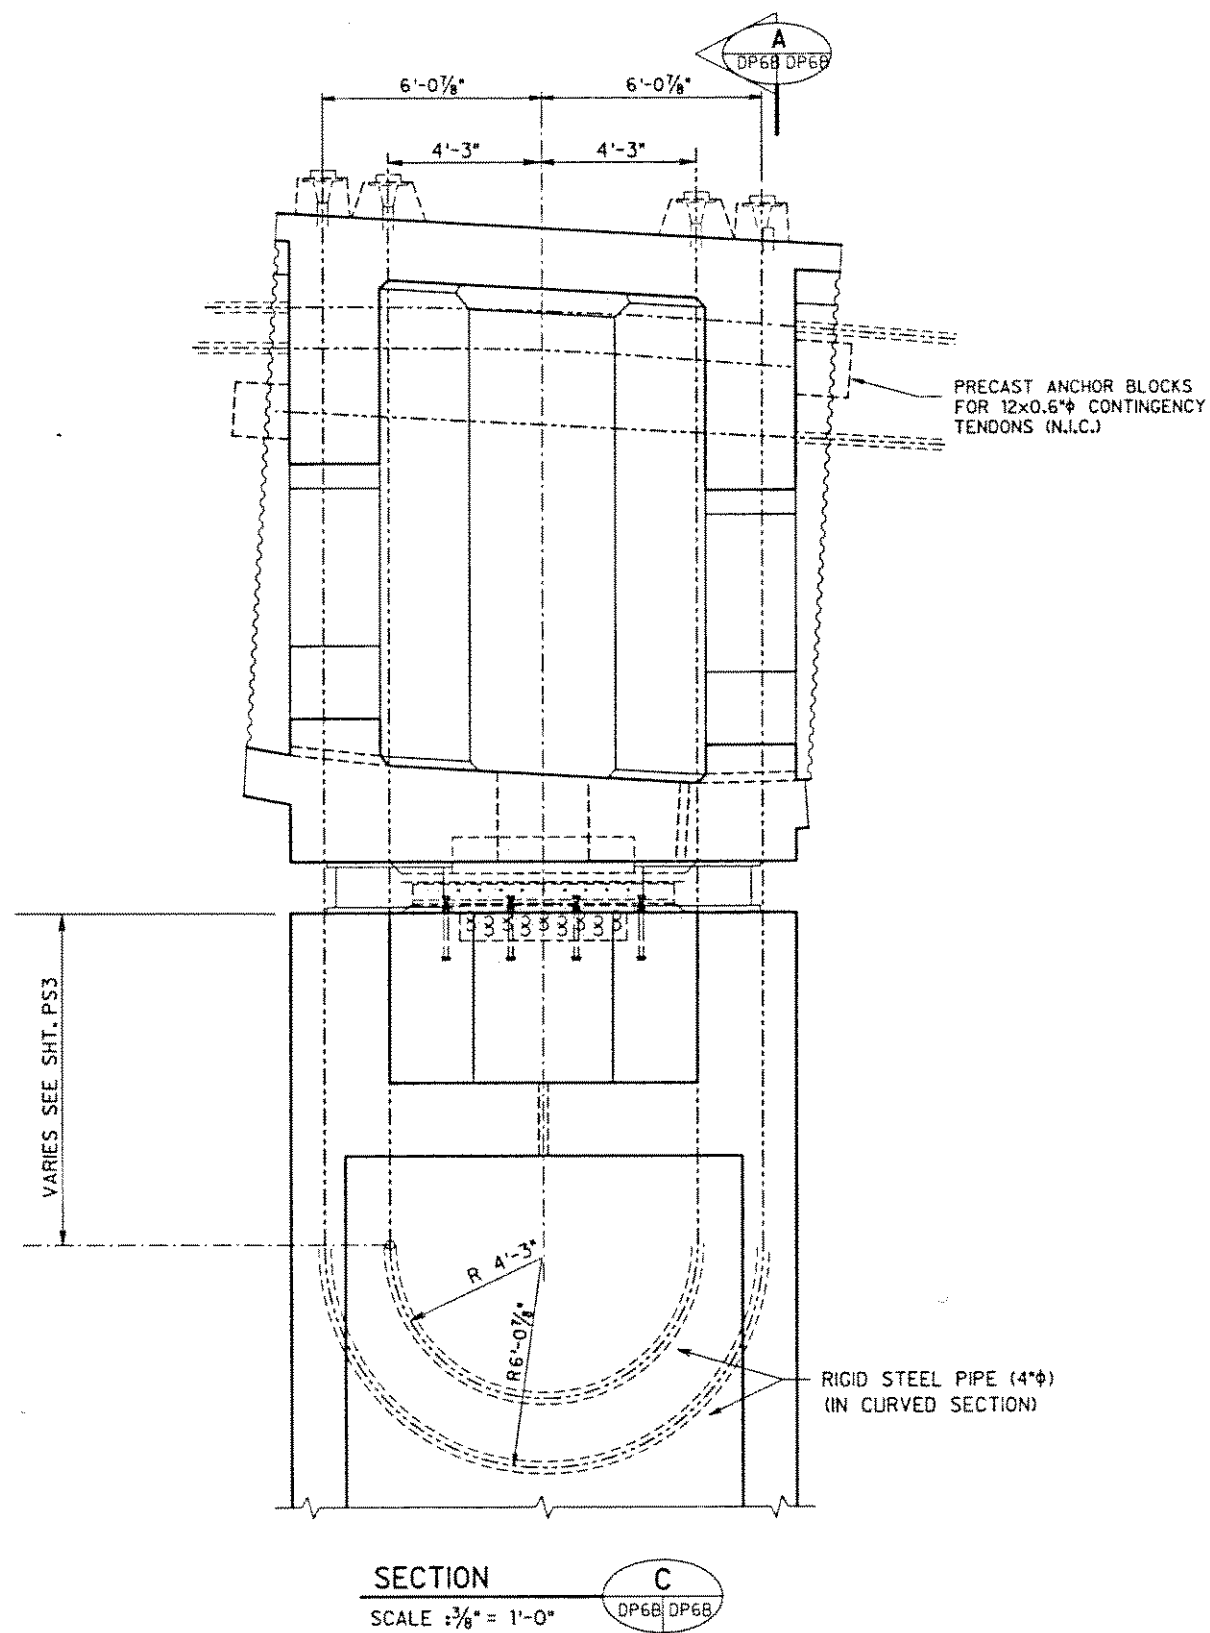

DESIGNED BY	DATE
DRAWN BY	
CHECKED BY	
NOTES	
NO.	

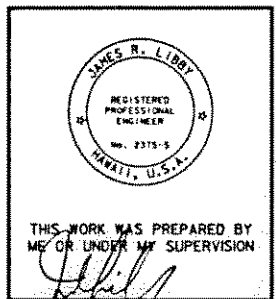

DATE	REVISION
J. MULLER INTERNATIONAL	Libby Engineers

STATE OF HAWAII
DEPARTMENT OF TRANSPORTATION
HIGHWAYS DIVISION

SLIDING PIER SEGMENT
P.T. DETAILS
TYPE II

INTERSTATE ROUTE H-3
F.A.I. PROJECT No. I-H3-1(57)
F.A.I. PROJECT No. I-H3-1(58)
SCALE: AS NOTED DATE: APR. 1991

SHEET No. DP6B OF SHEETS