
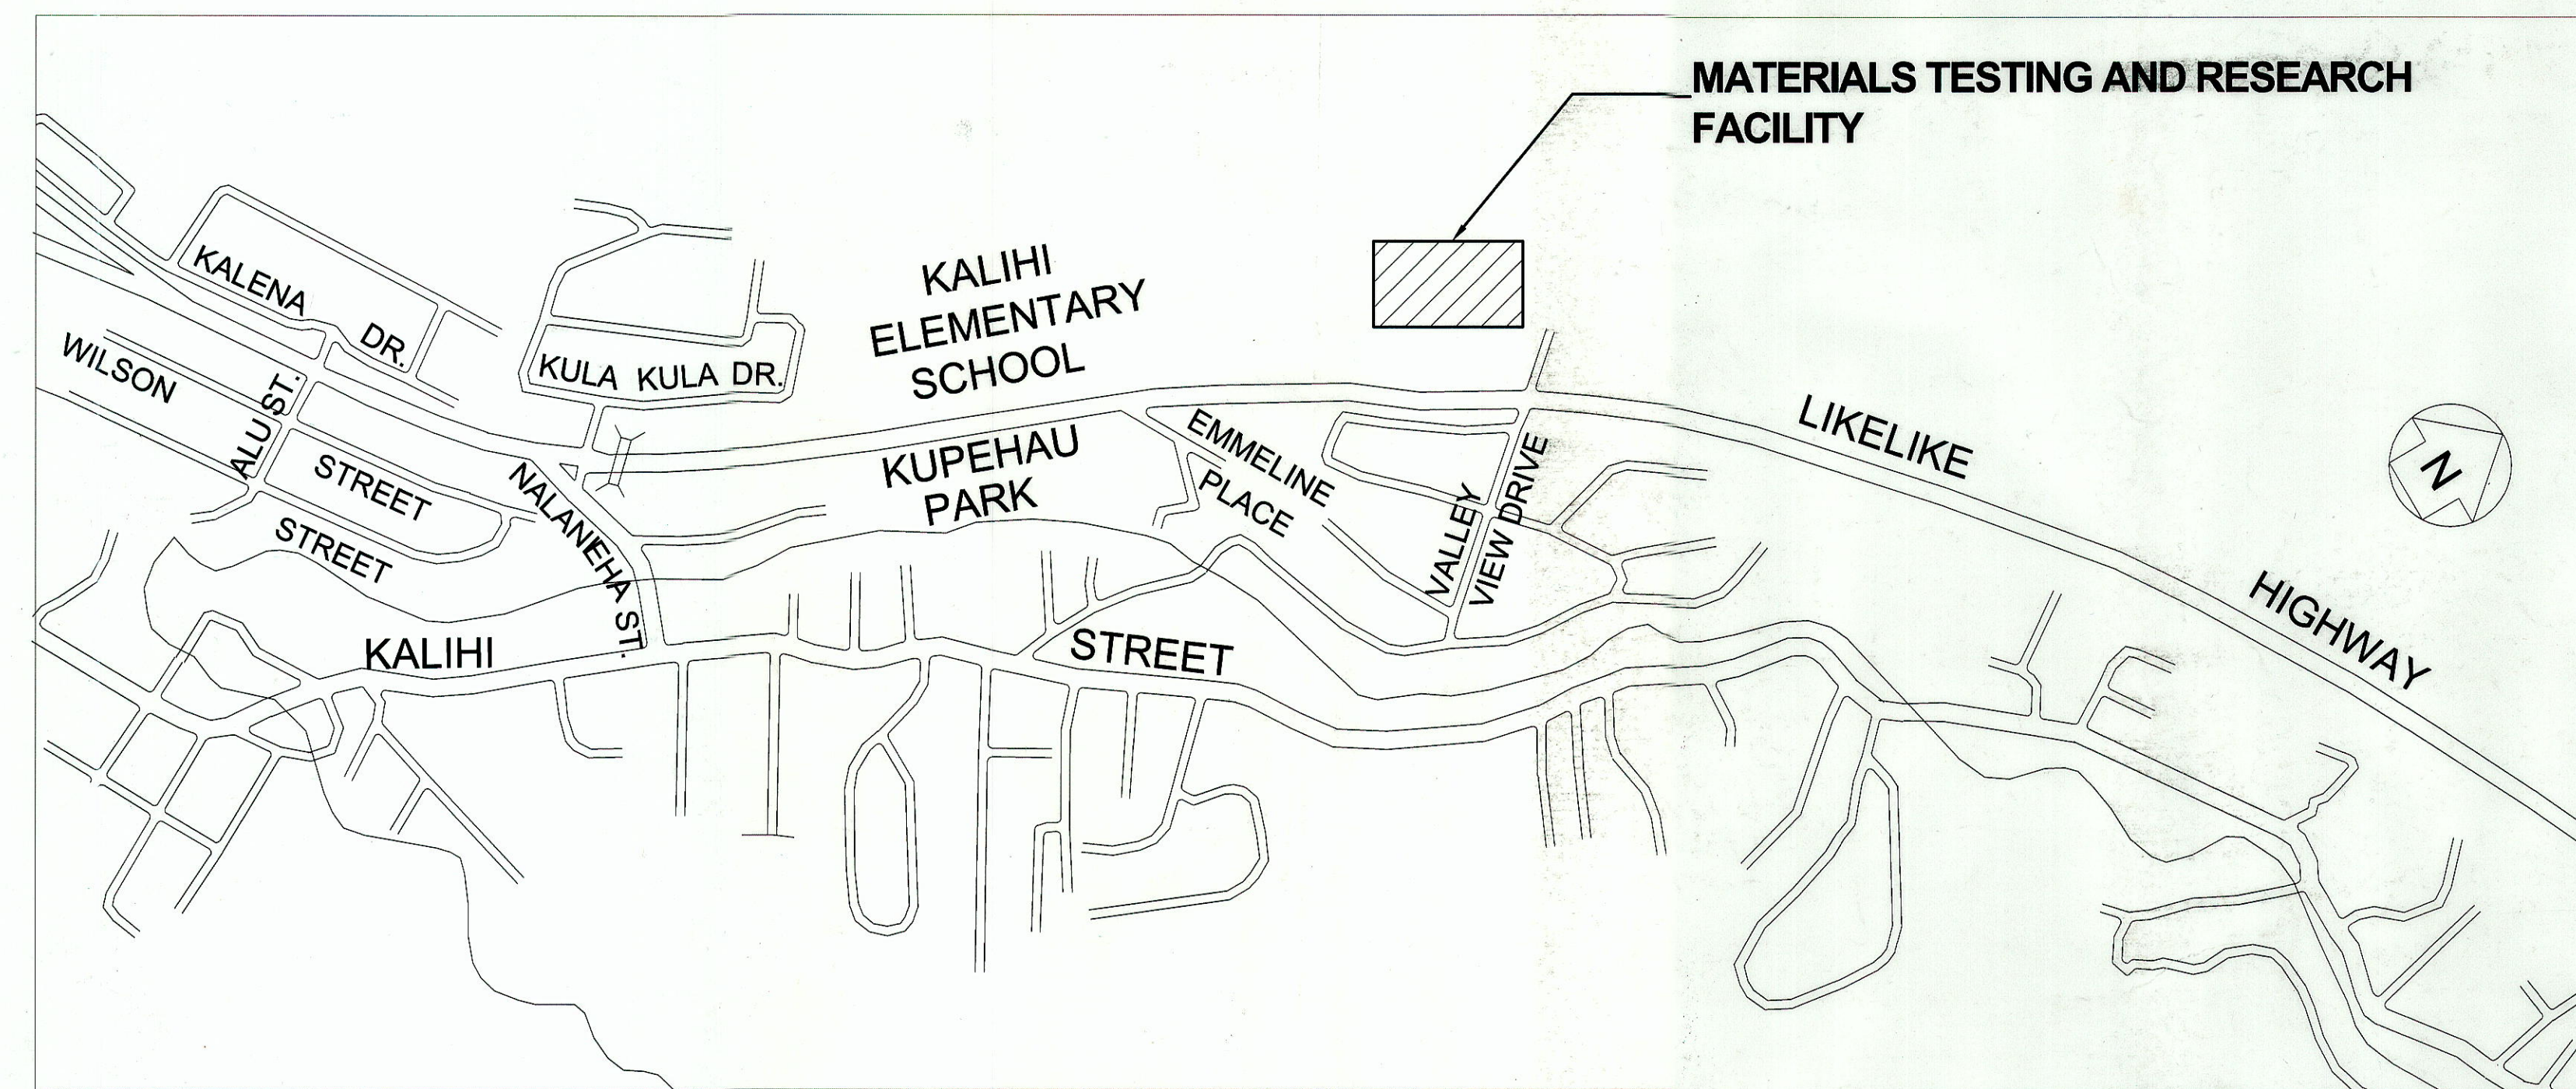


STATE OF HAWAII
 DEPARTMENT OF TRANSPORTATION
 HIGHWAYS DIVISION
 HONOLULU, HAWAII
"AS-BUILT"
 PLANS FOR
**MATERIALS TESTING AND RESEARCH
 FACILITY RENOVATION**
PROJECT NO. HWY-L-06-06
 DISTRICT OF HONOLULU
 ISLAND OF OAHU

FED. ROAD DIST. NO.	STATE	PROJ. NO.	FISCAL YEAR	SHEET NO.	TOTAL SHEETS
HAWAII	HAW.	HWY-L-06-06	2008	1	152

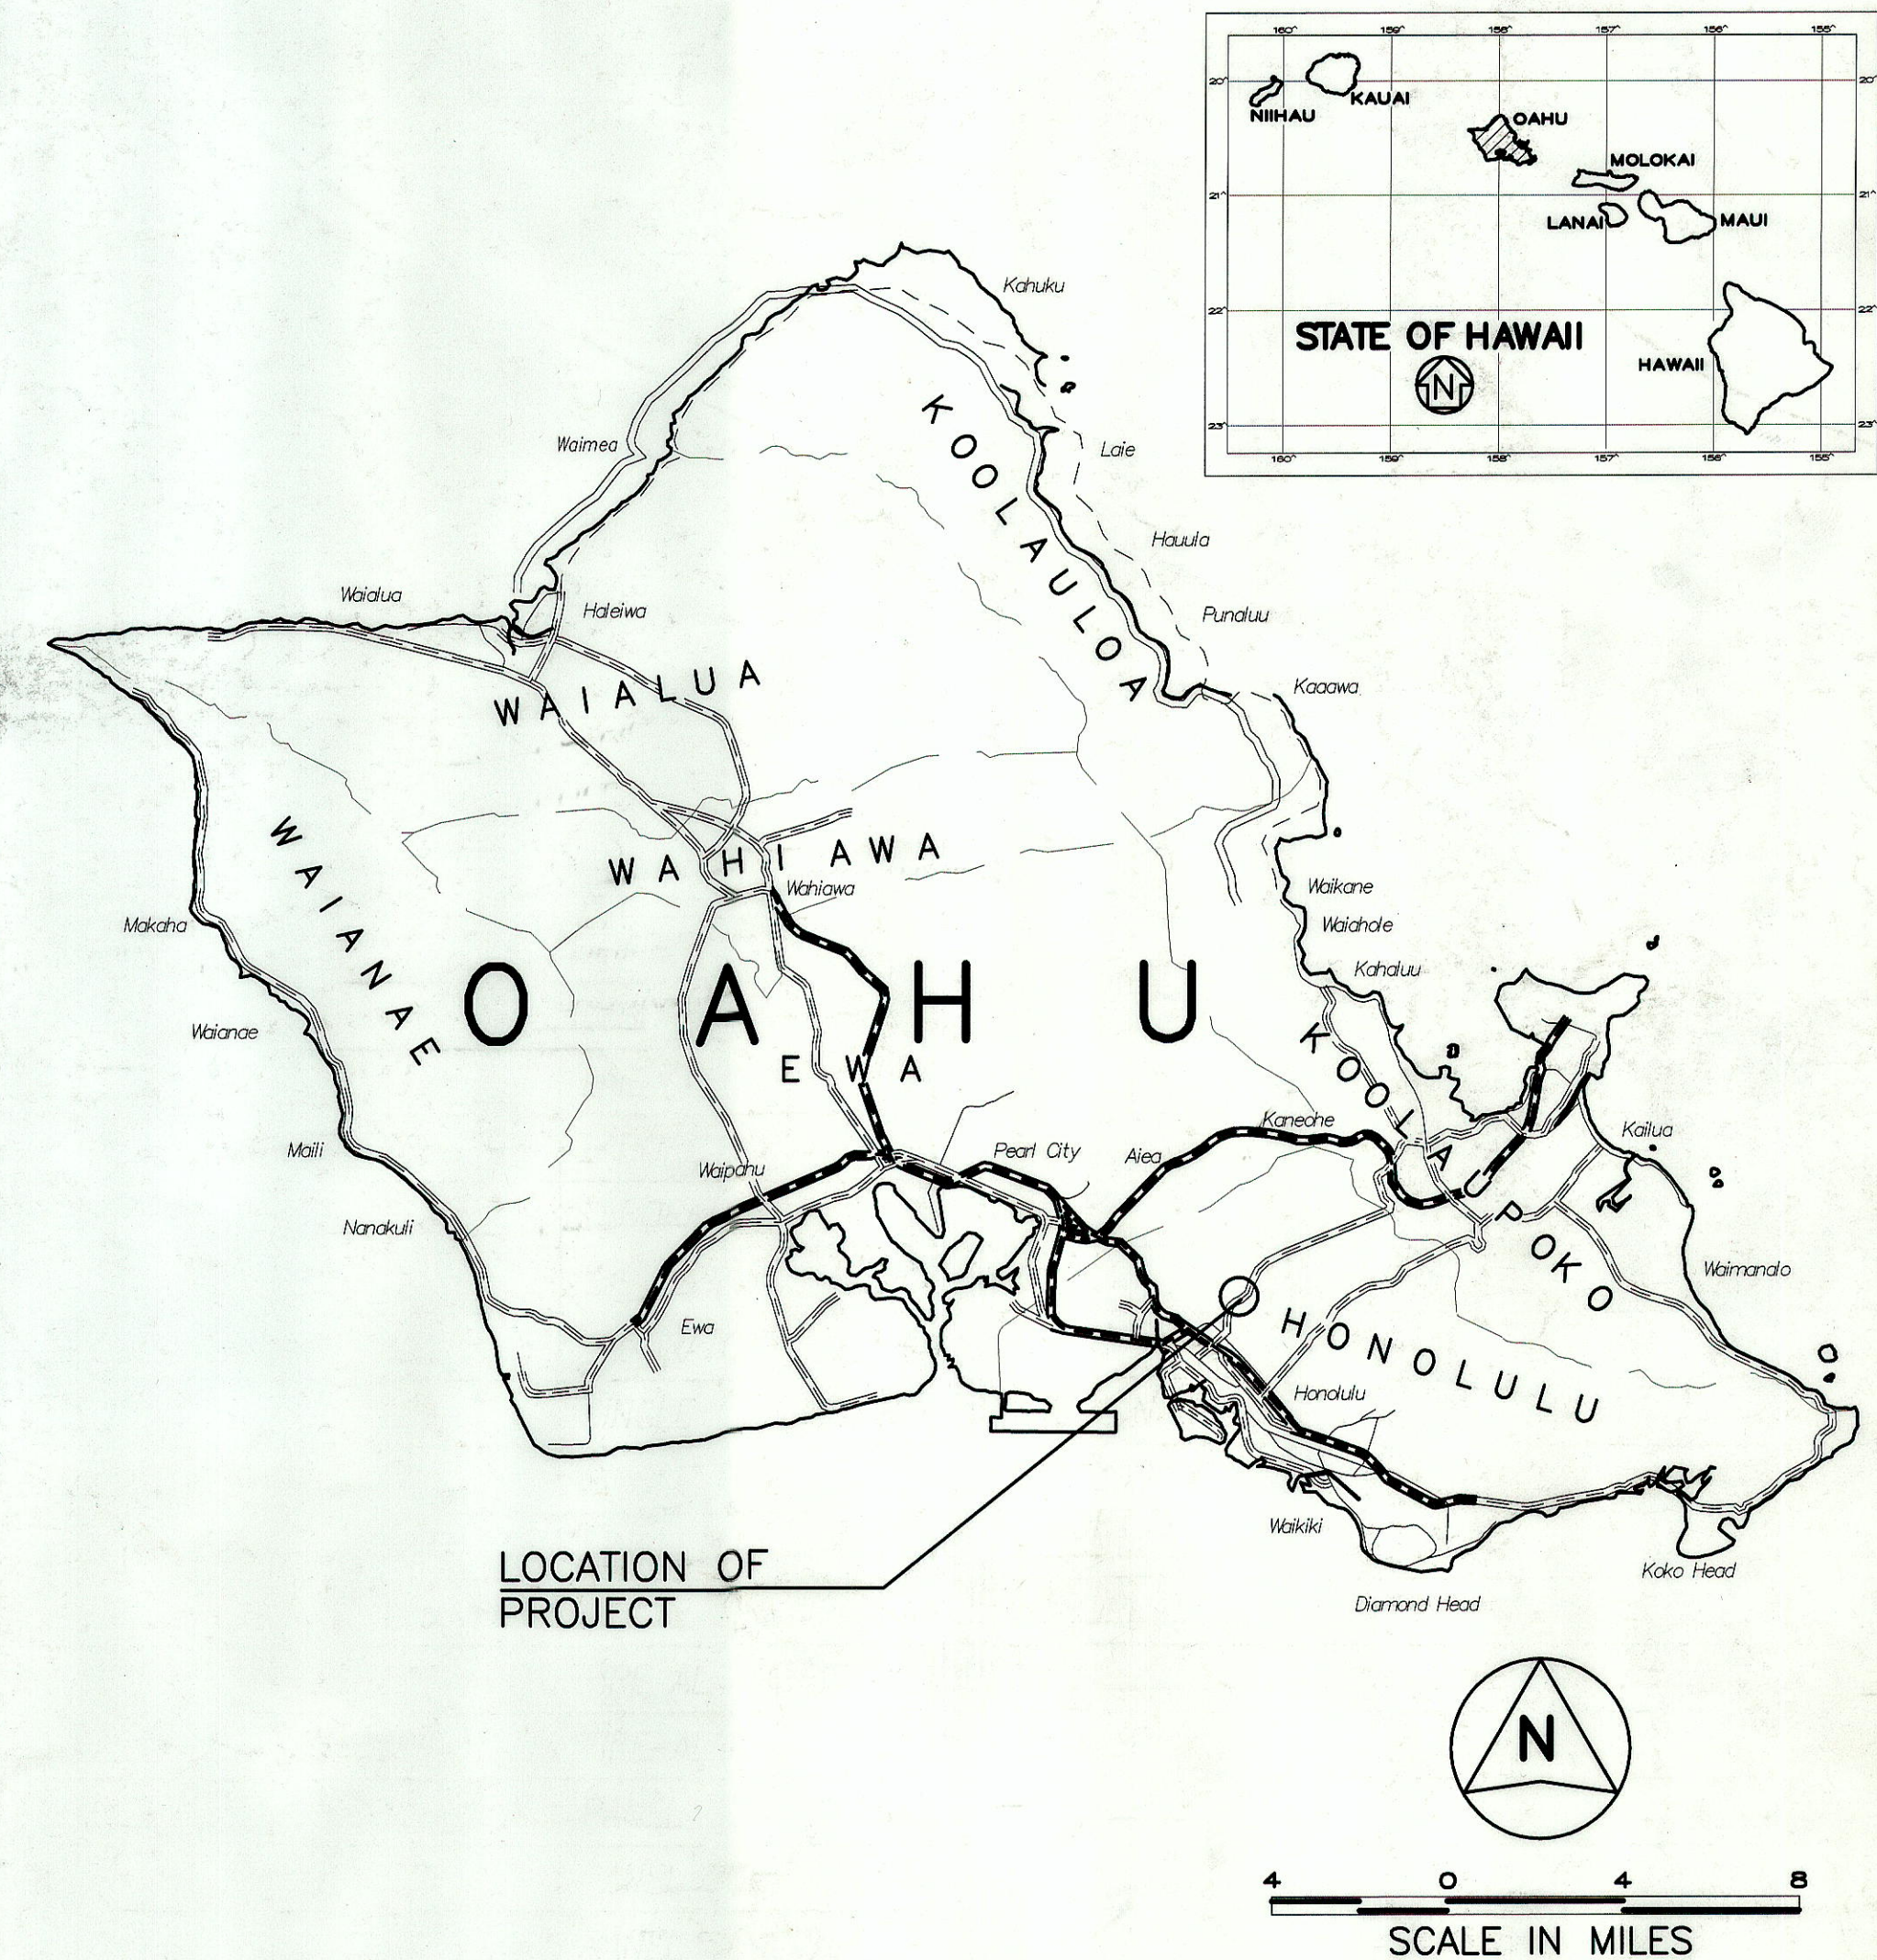

LOCATION PLAN
 NOT TO SCALE

CHANGES MADE DURING CONSTRUCTION HAVE BEEN INCORPORATED ON THESE PLANS EXCEPT CHANGES IN THE ORIGINAL THEORETICAL QUANTITIES. FOR ACTUAL QUANTITIES, REFER TO PROJECT LEDGER AND/OR COMPUTATION BOOK.

Kelvin Akazawa 7-20-16
 RESIDENT ENGINEER DATE

DEPARTMENT OF TRANSPORTATION
 STATE OF HAWAII
 APPROVED:
[Signature] 5-28-08
 DIR. OF TRANSPORTATION DATE

LOU CHAN & ASSOCIATES
 DESIGNED BY
 HWY-L
 MANAGED BY
 832-3403
 PHONE
 MAY 2008
 DATE