
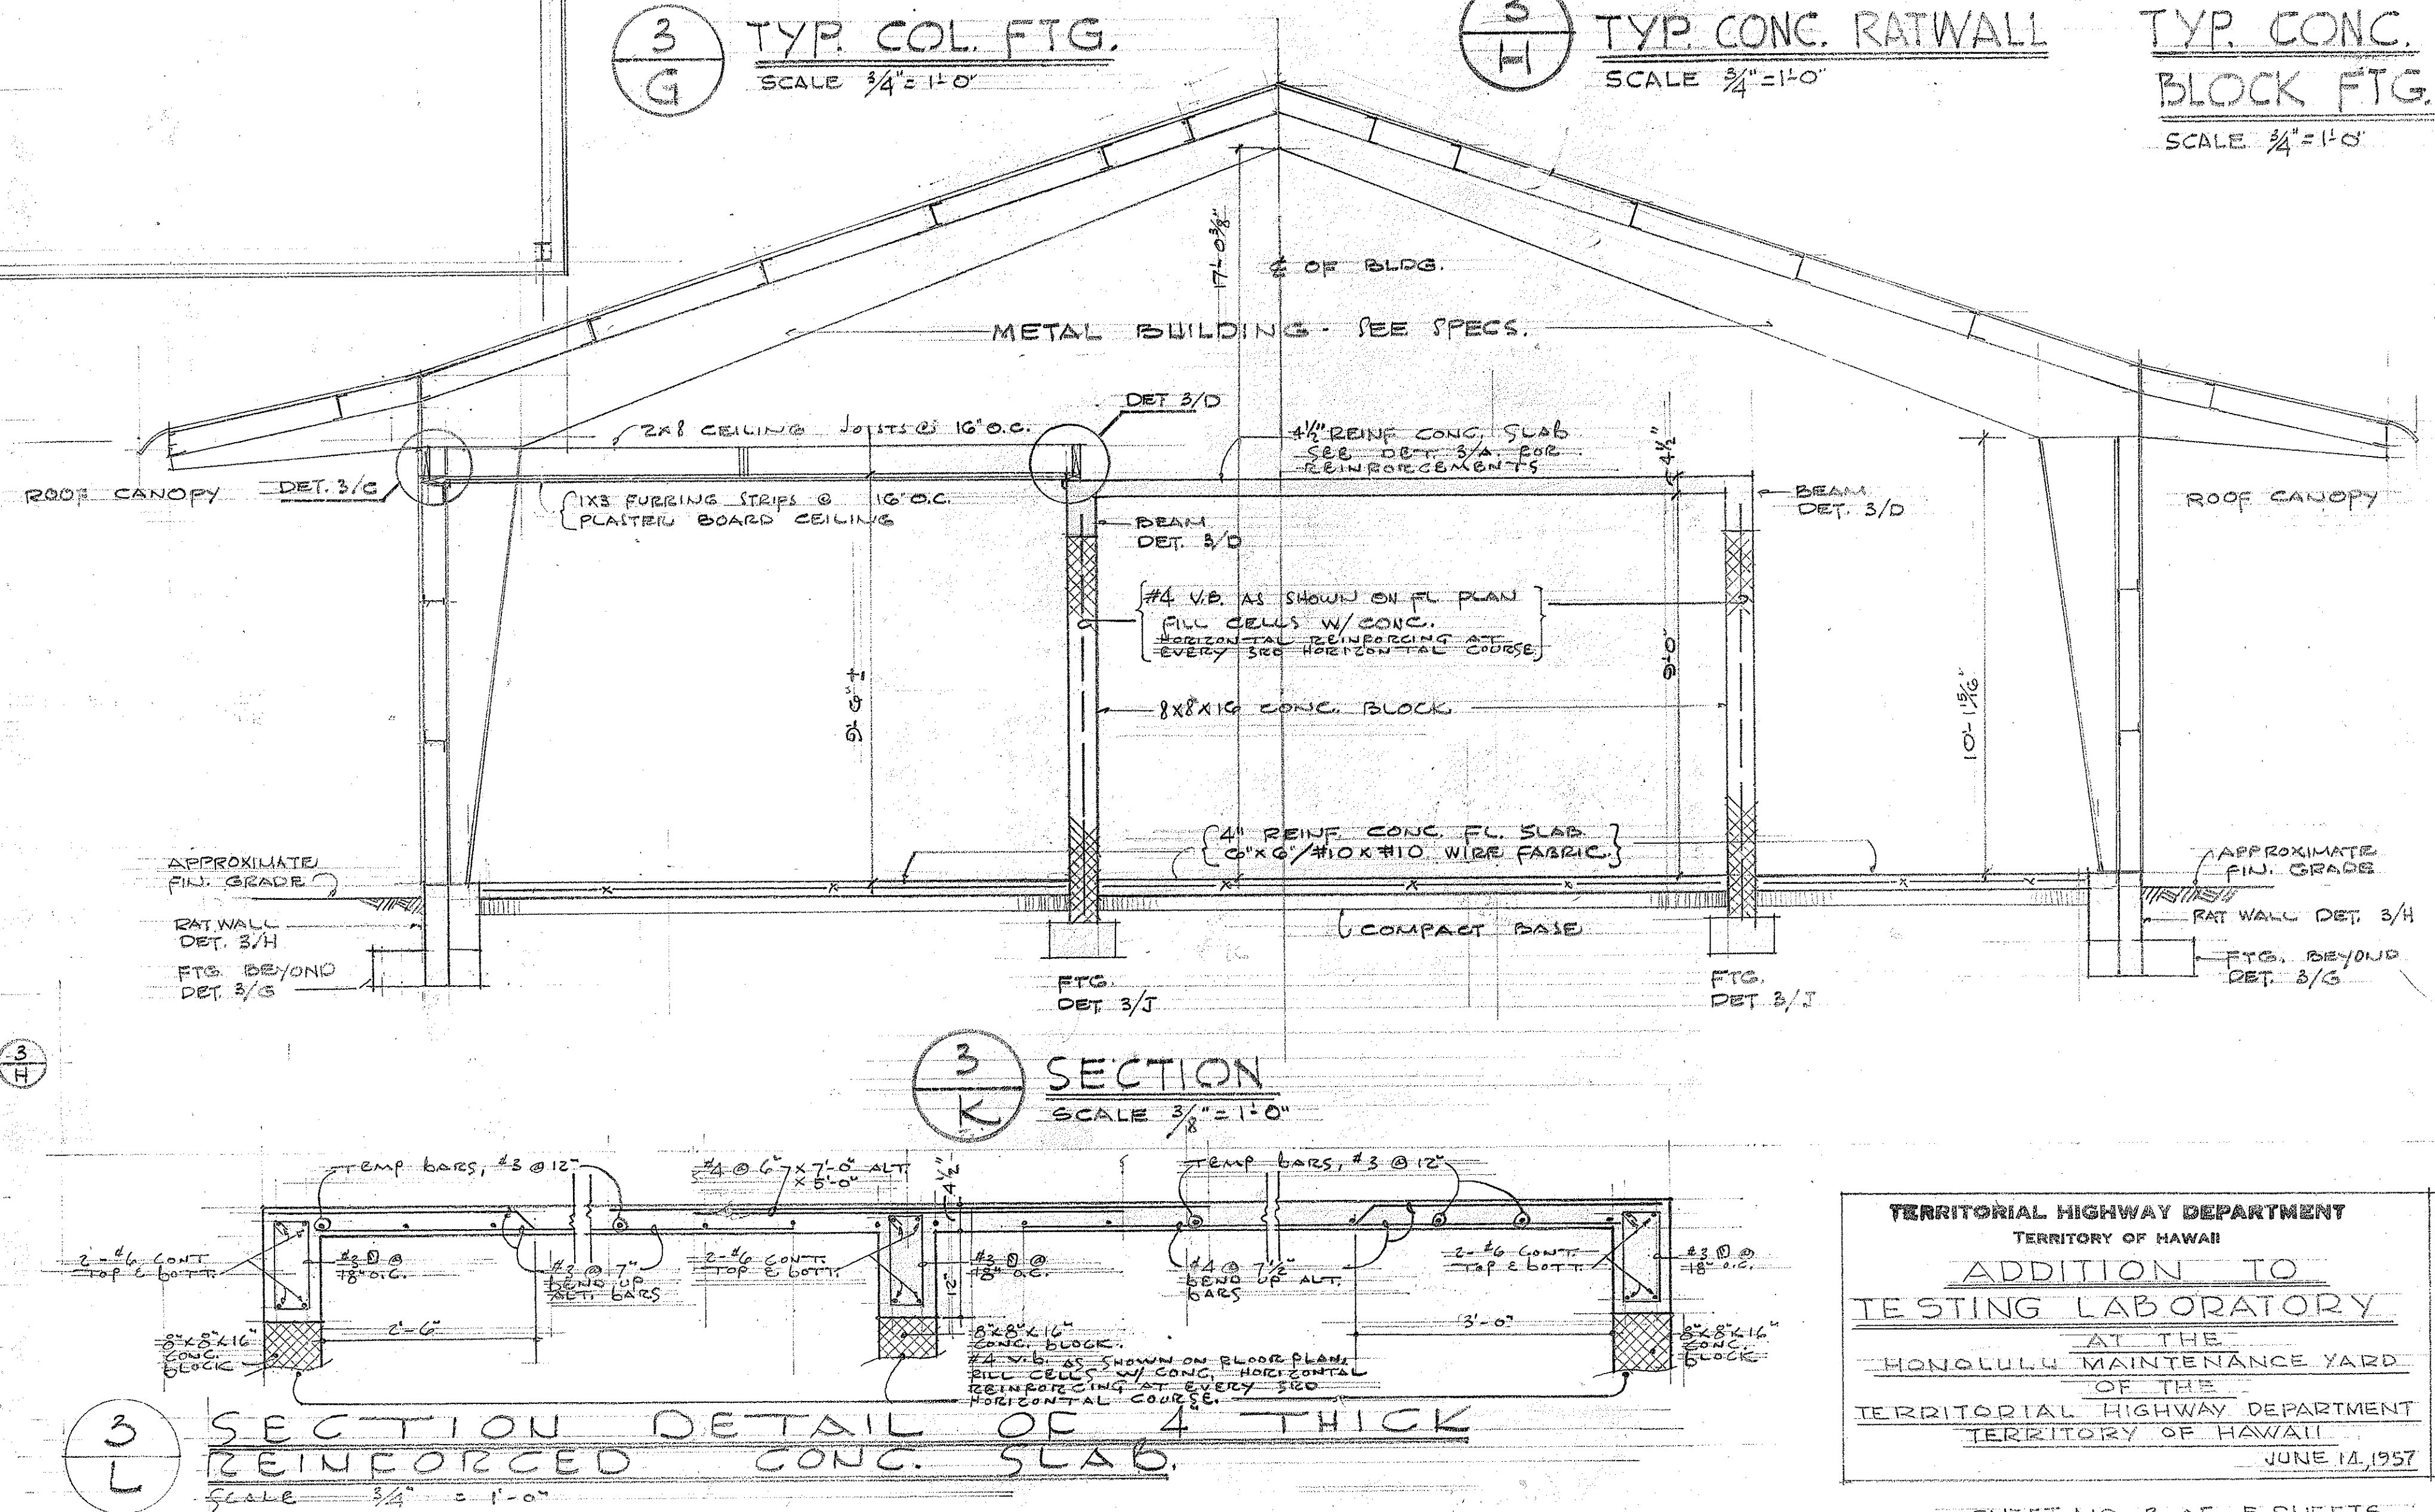


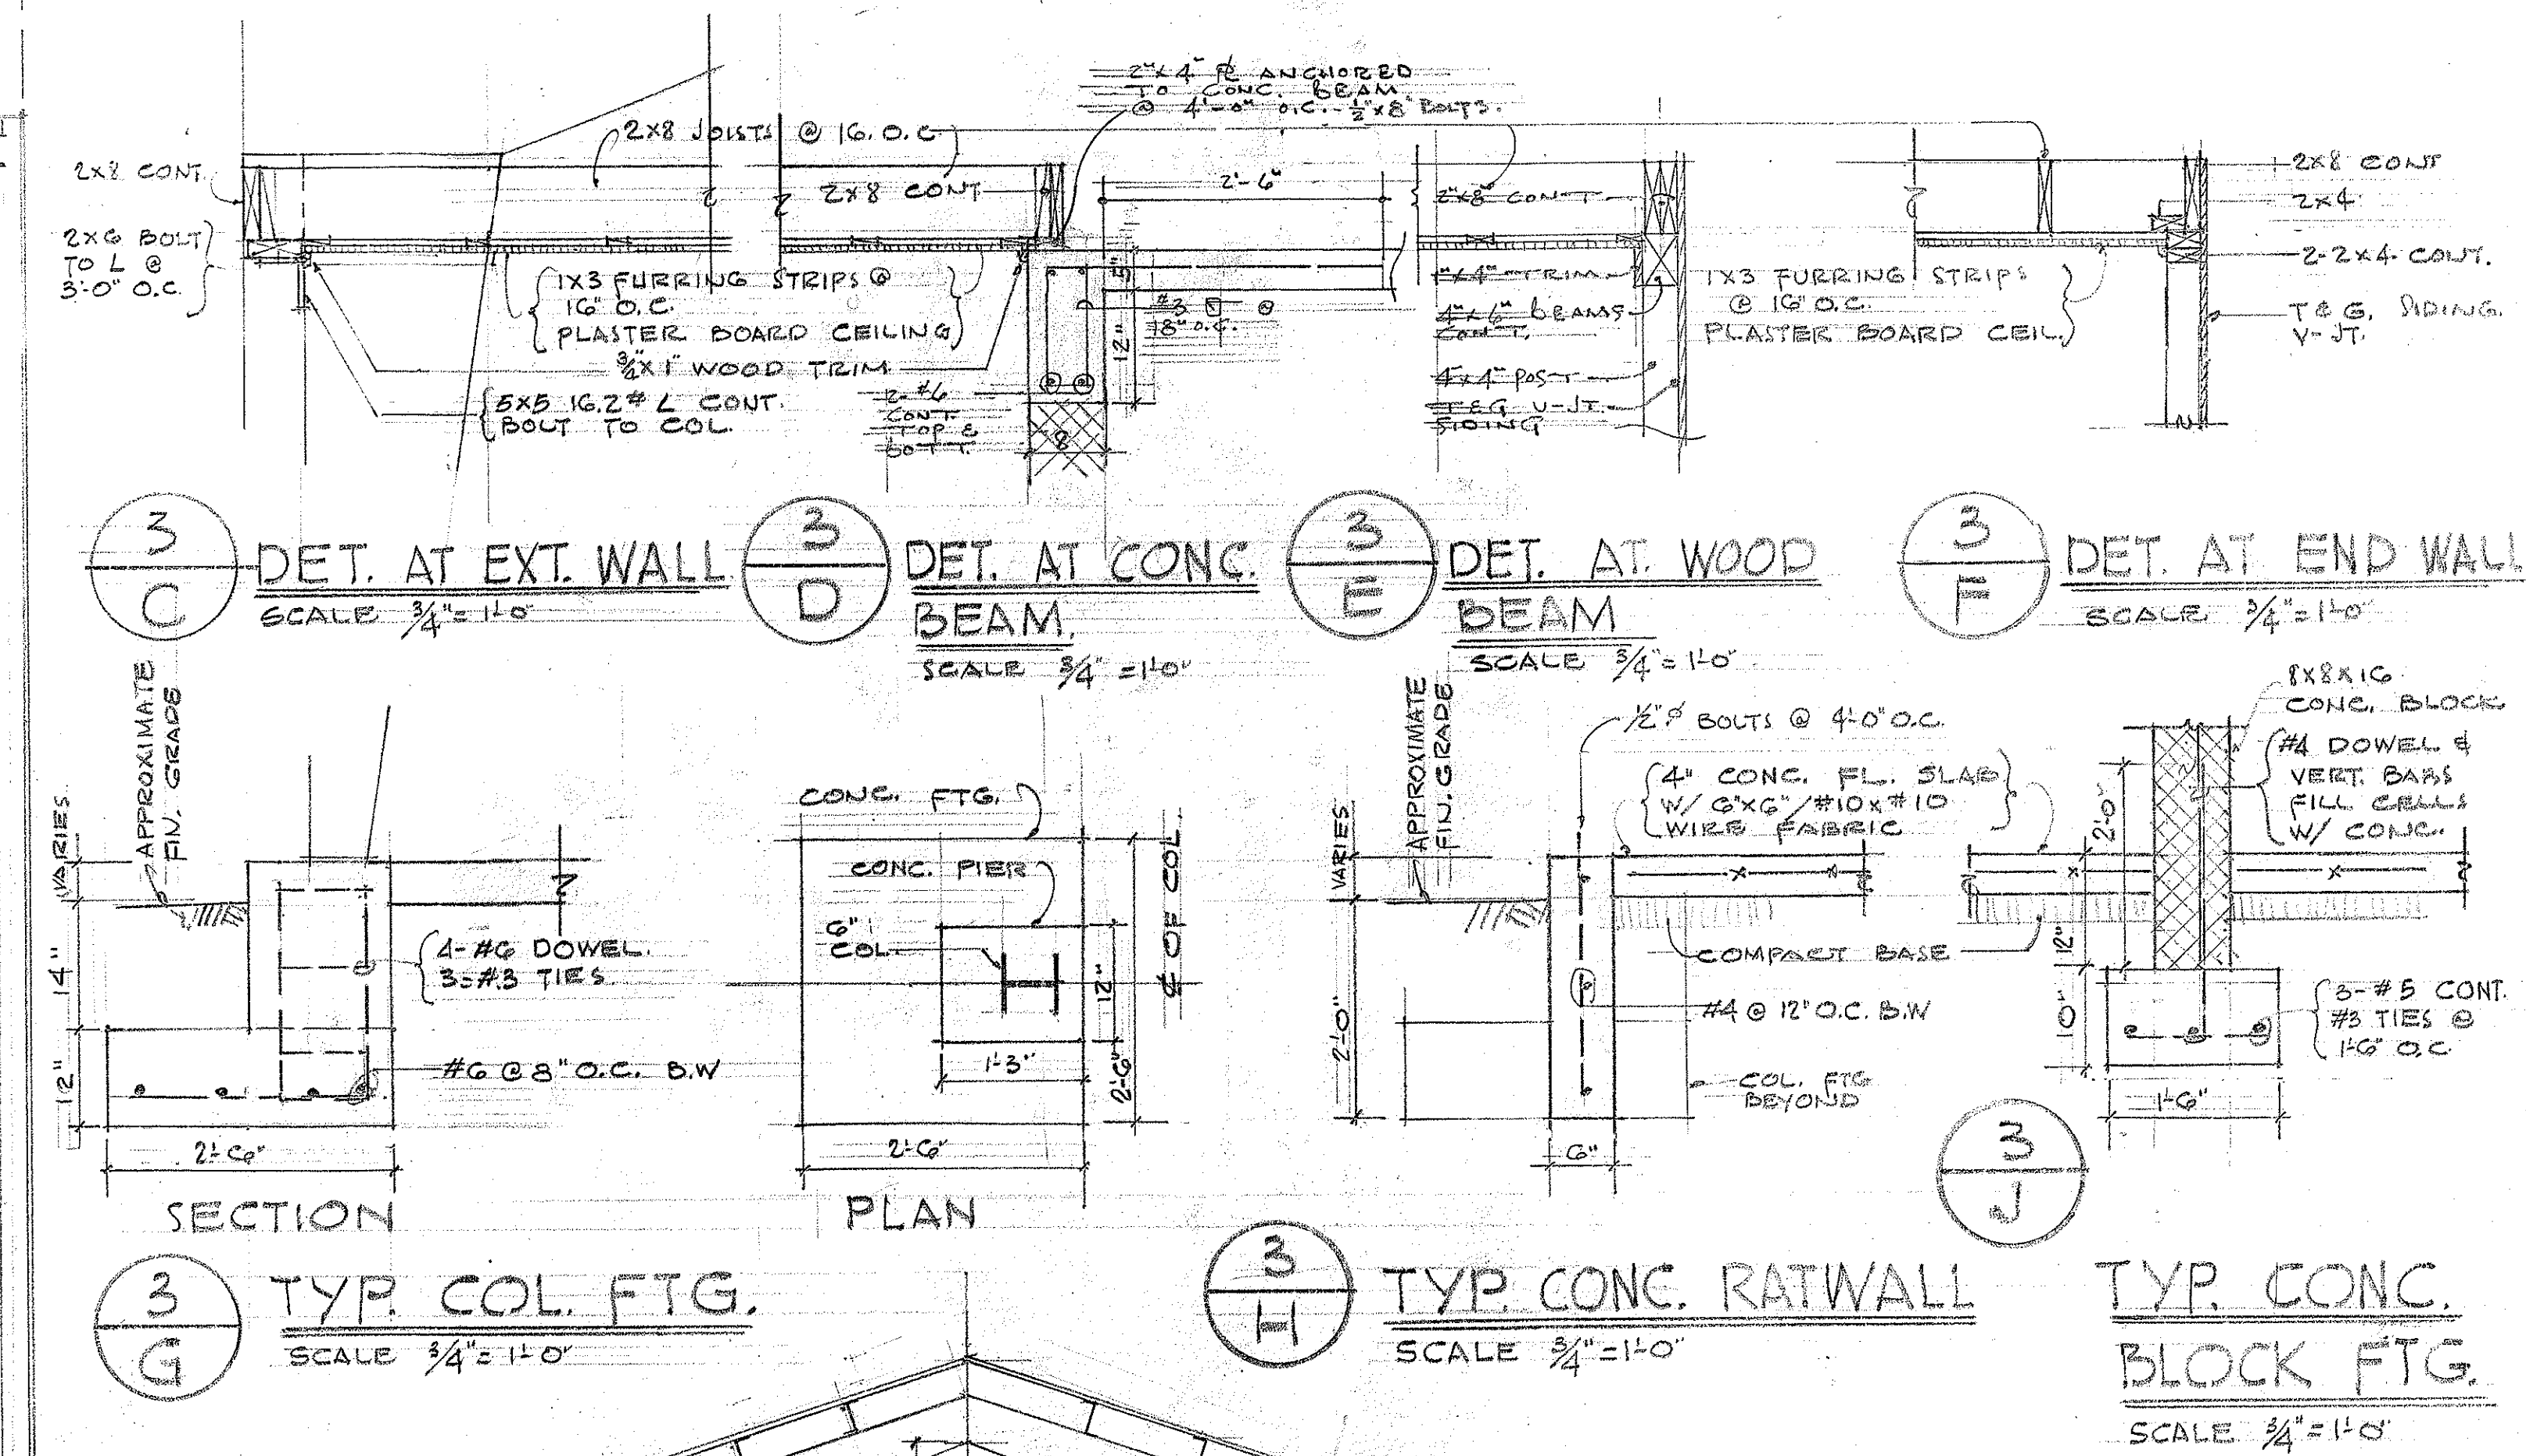

TERRITORIAL HIGHWAY DEPARTMENT
 TERRITORY OF HAWAII
ADDITION TO
TESTING LABORATORY
AT THE
HONOLULU MAINTENANCE YARD
OF THE
 TERRITORIAL HIGHWAY DEPARTMENT
 TERRITORY OF HAWAII
 JUNE 14, 1957

SHEET NO. 3 OF 5 SHEETS

D.P.W. JOB No 5923

4th Regt SCS Tropic, Hawaii SHJ NO. 1
Camp, Hawaii June 12, 1947