INDEX TO DRAWINGS SHEET NO. DESCRIPTION TITLE SHEET TYPICAL SECTIONS AND MISCELLANEOUS DETAILS PLAN DRAINAGE DITCH CROSS SECTIONS

STATE OF HAWAII

DEPARTMENT OF TRANSPORTATION HIGHWAYS DIVISION


HONOLULU, HAWAII


PLANS FOR

IMPROVEMENTS TO MATERIALS TESTING AND RESEARCH LABORATORY SITE AND FACILITY

PROJECT No. BD 70-418

DISTRICT OF HONOLULU ISLAND OF OAHU

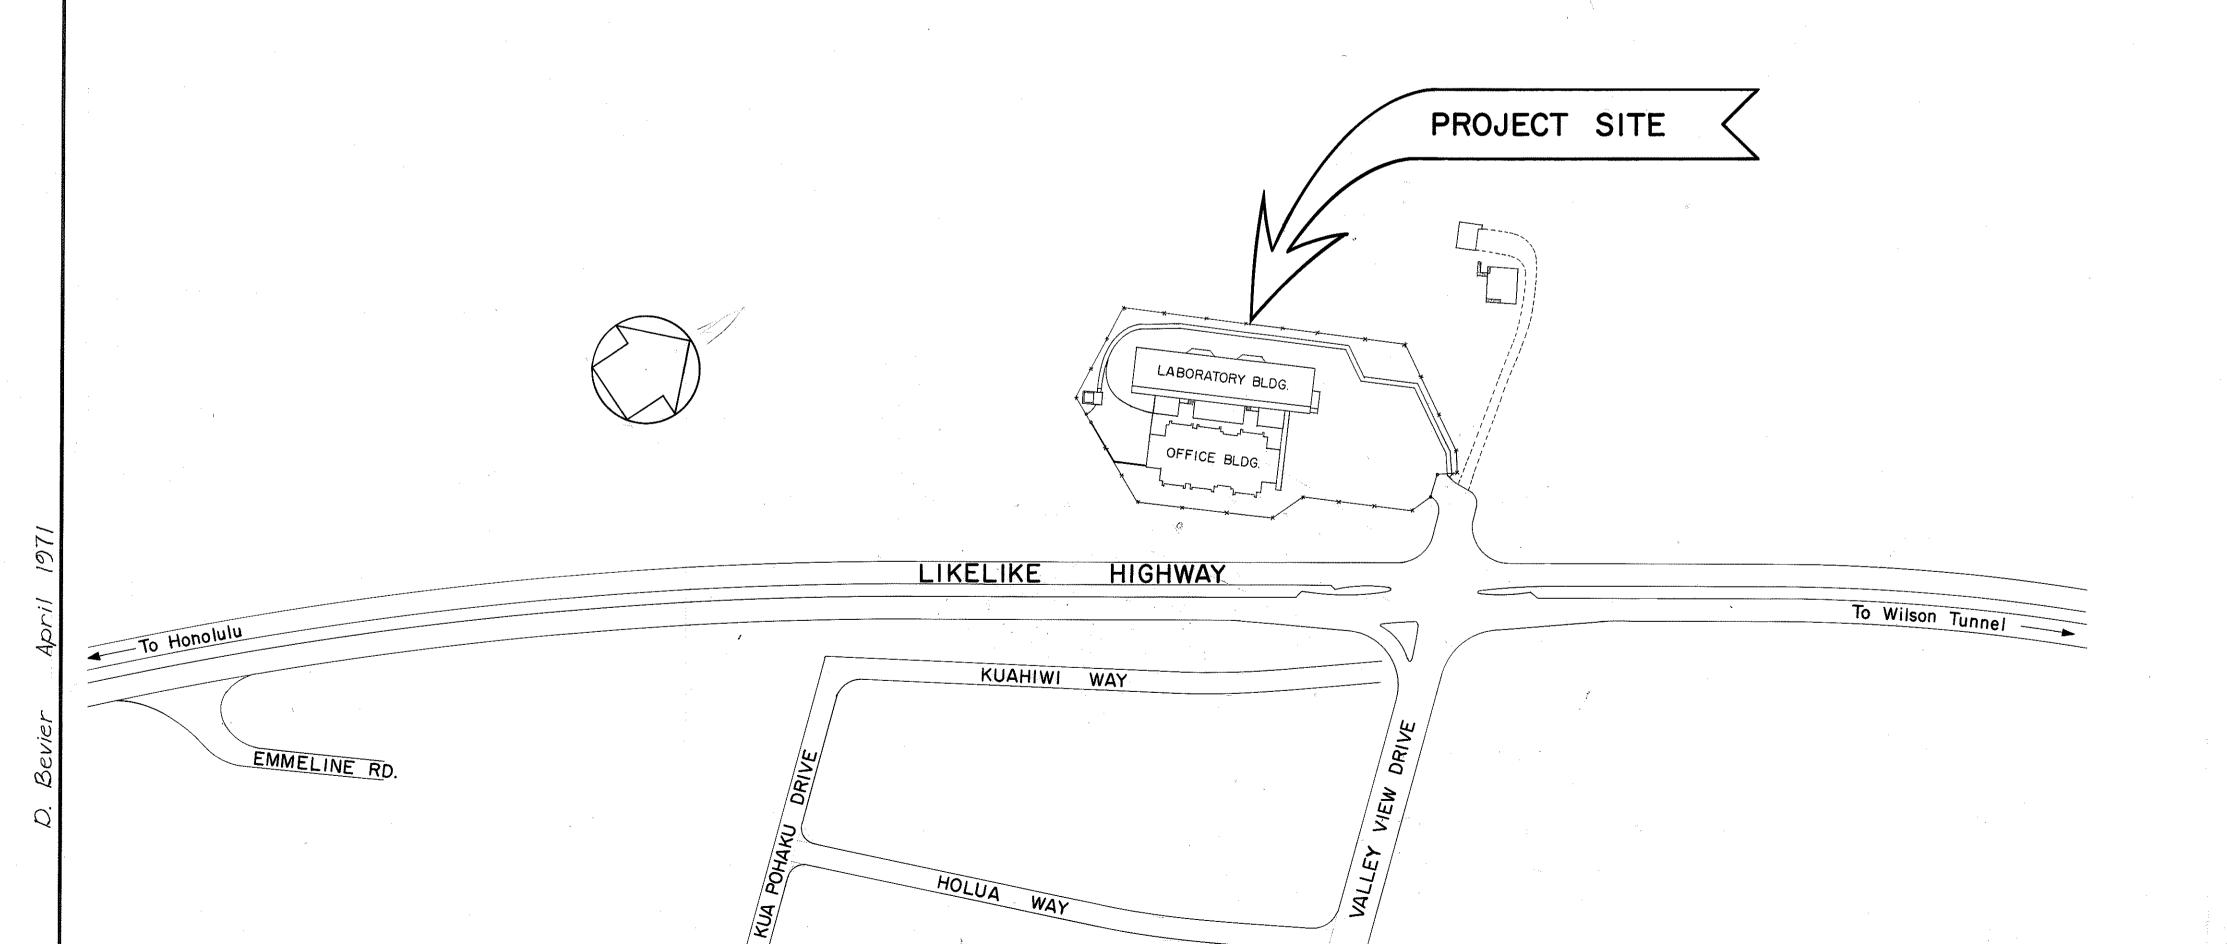

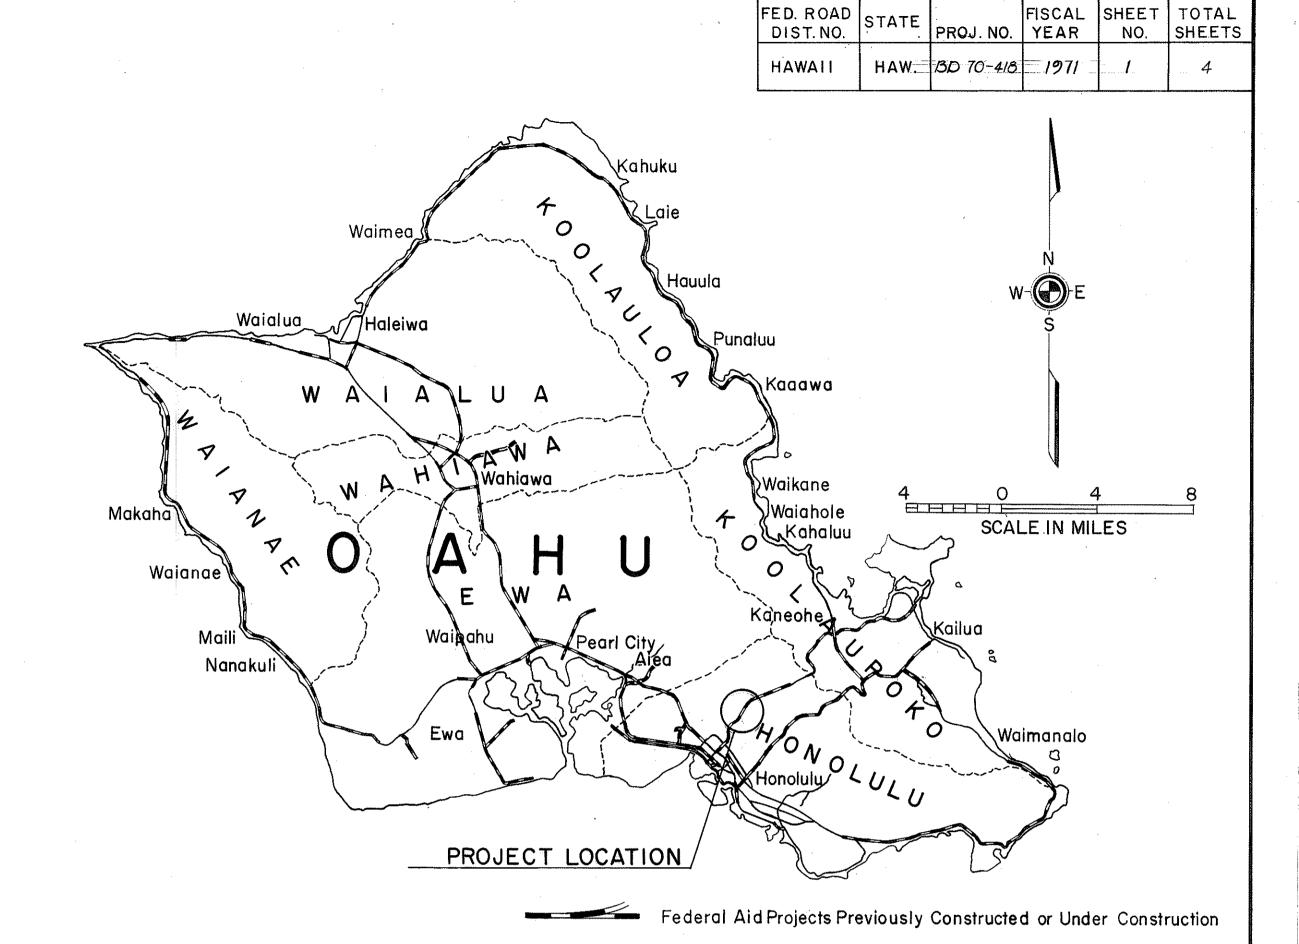

DEPARTMENT OF TRANSPORTATION STATE OF HAWAII APPROVED: