
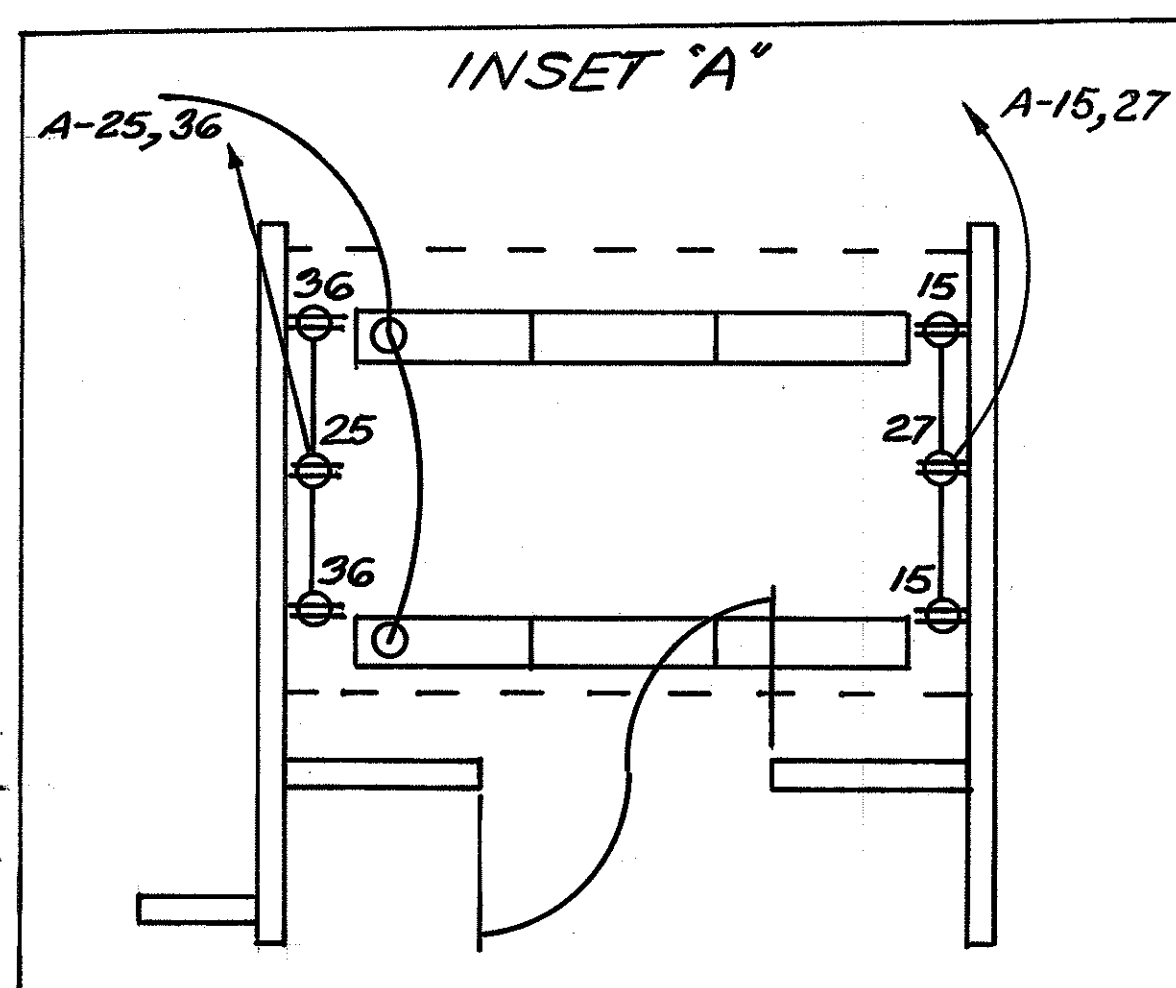
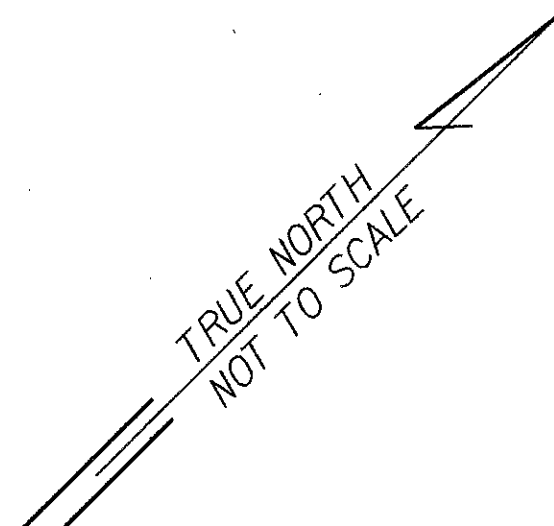


FED. ROAD DIST. NO.	STATE	PROJ. NO.	FISCAL YEAR	SHEET NO.	TOTAL SHEETS
HAWAII	HAW.	HWY-0-01-00M	2000	3	3

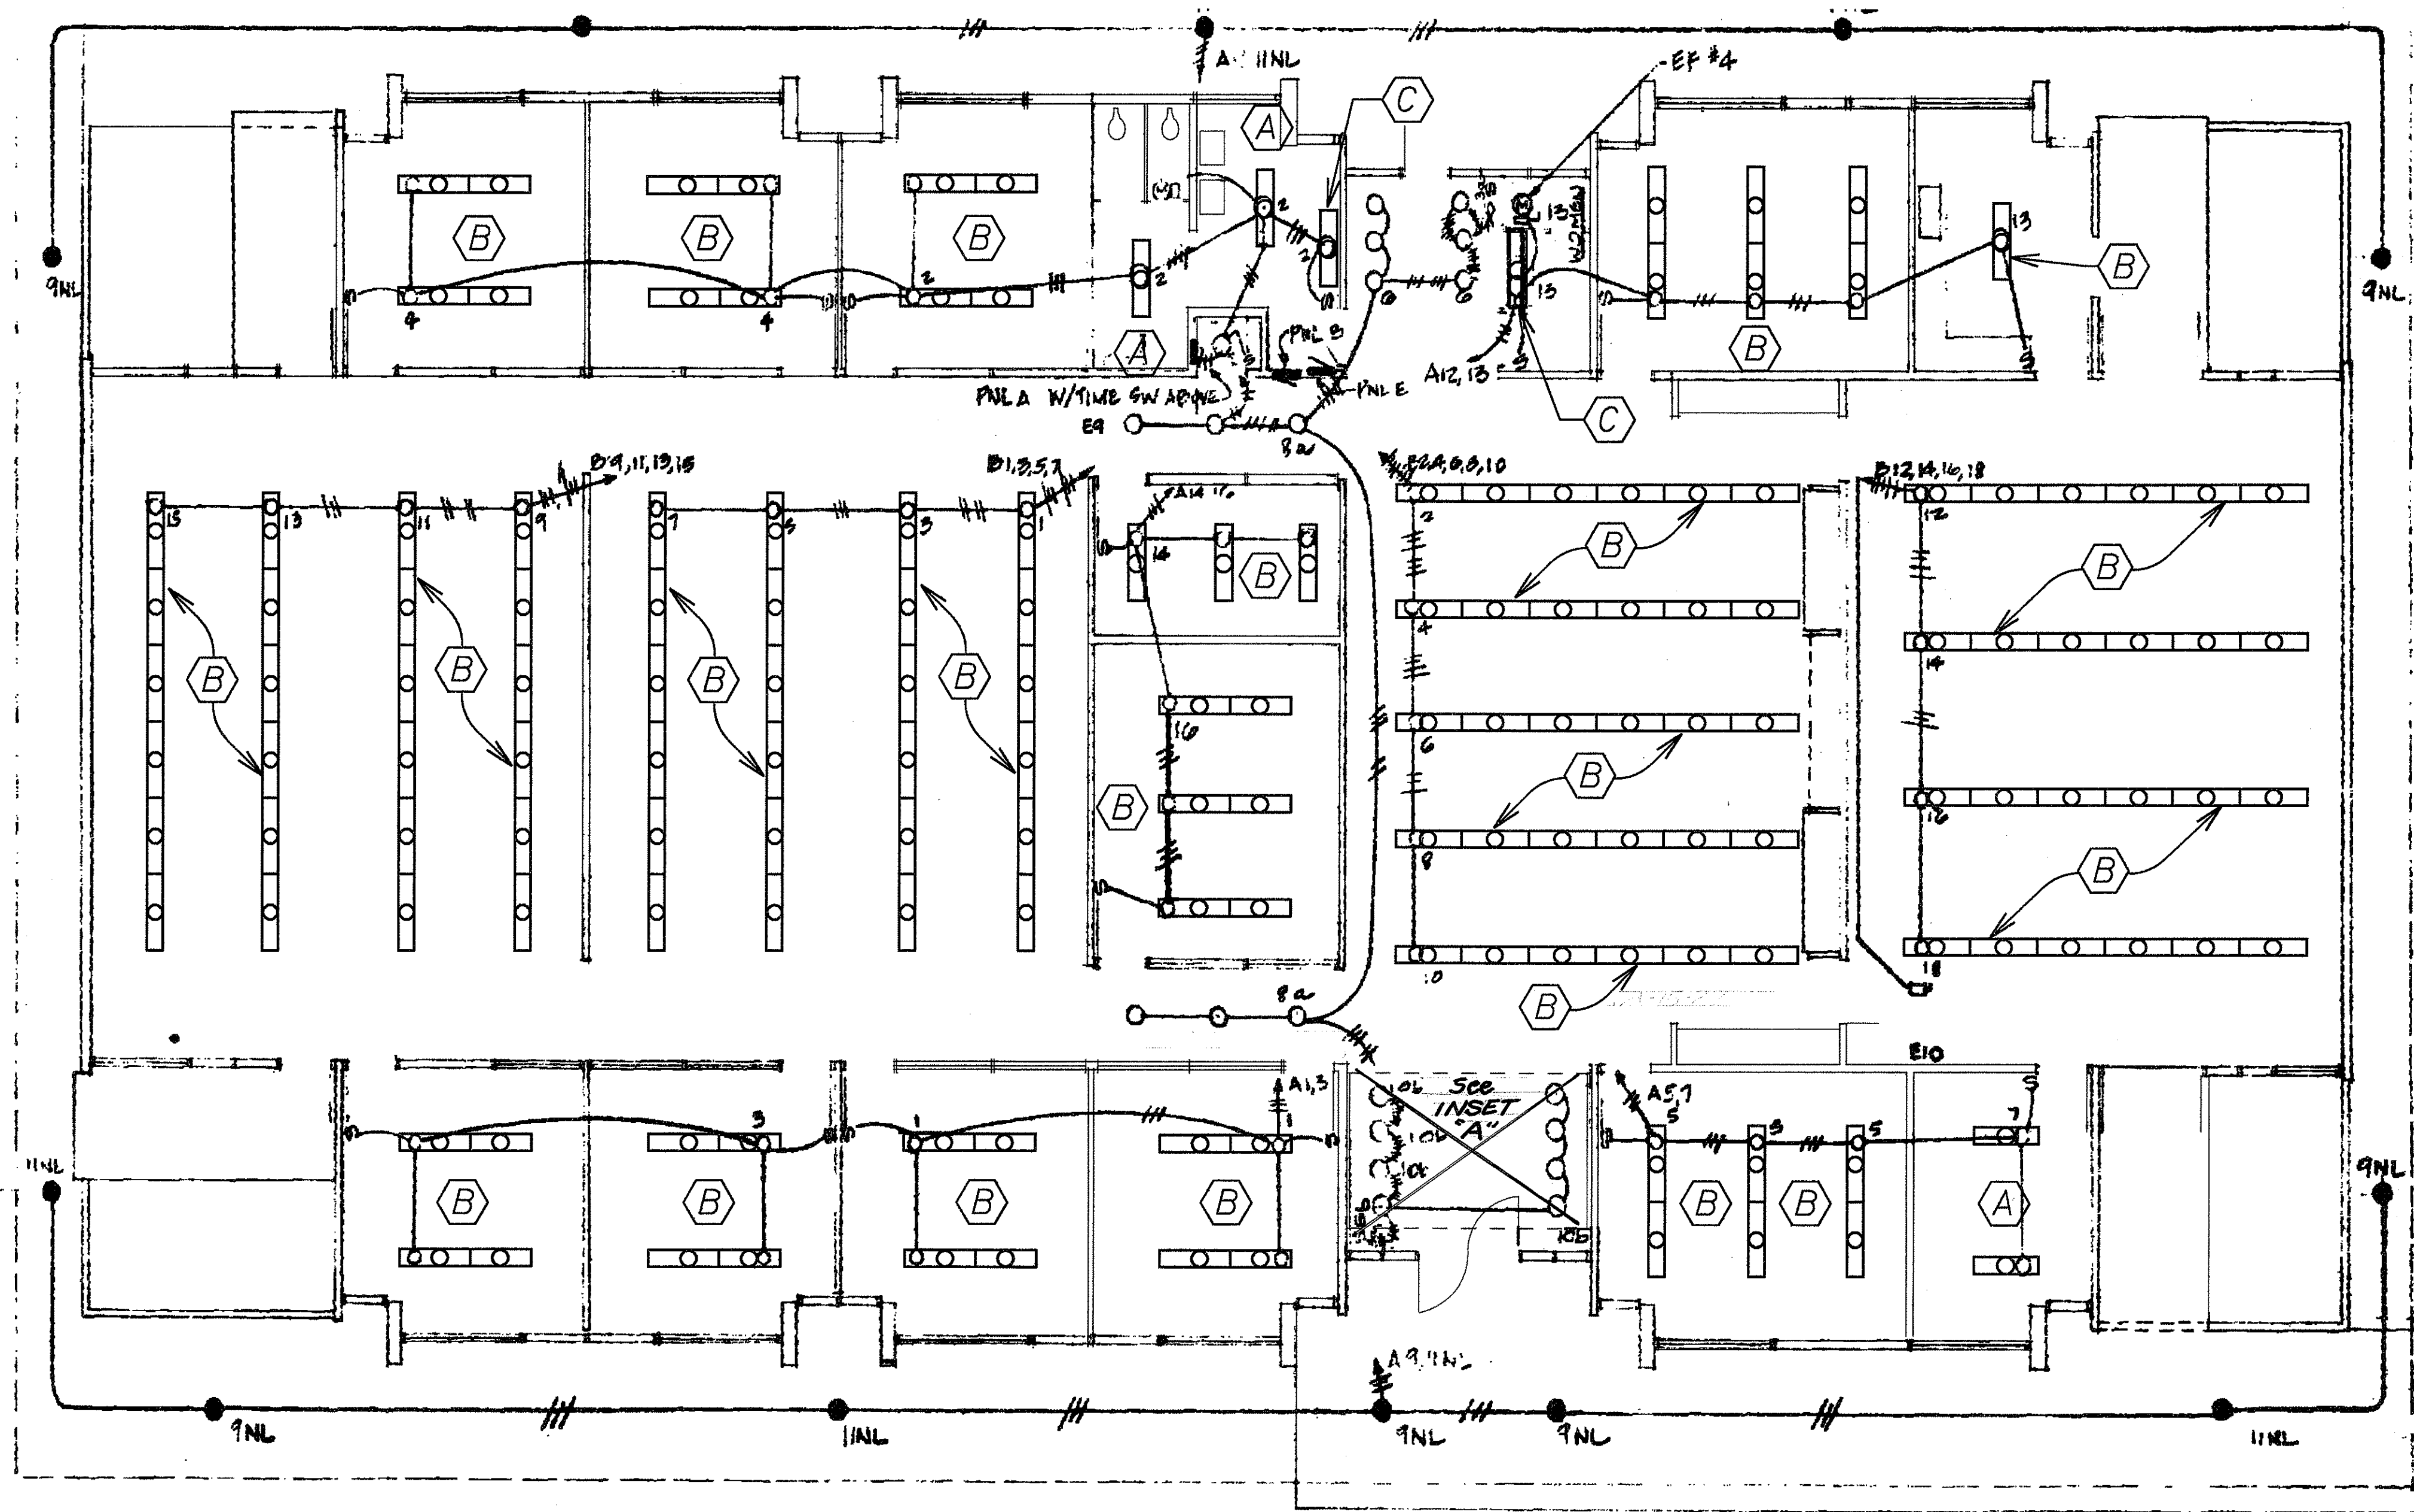

ORIGINAL PLAN	SURVEY PLOTTED BY	DATE
TRACED BY		
DESIGNED BY		
CHECKED BY		
IN.		

Likelike Highway

Parking

STATE OF HAWAII
DEPARTMENT OF TRANSPORTATION
HIGHWAYS DIVISION

ELECTRICAL RELAMPING PLAN

MATERIAL TESTING AND
RESEARCH BRNCH
Project No. HWY-0-01-00M

Not to Scale Date: May, 2000

SHEET No. 1 OF 1 SHEETS


"AS-BUILT"

FED. ROAD DIST. NO.	STATE	FED. AID PROJ. NO.	FISCAL YEAR	SHEET NO.	TOTAL SHEETS
HAWAII	HAW.	HWY-0-01-00M	2000	3S-1	3

ANALYTICAL CHEM./ASPHALT LAB.-17 EA.

RECEIVING AND PREPARATION-31 EA.

LABORATORY-28 EA.

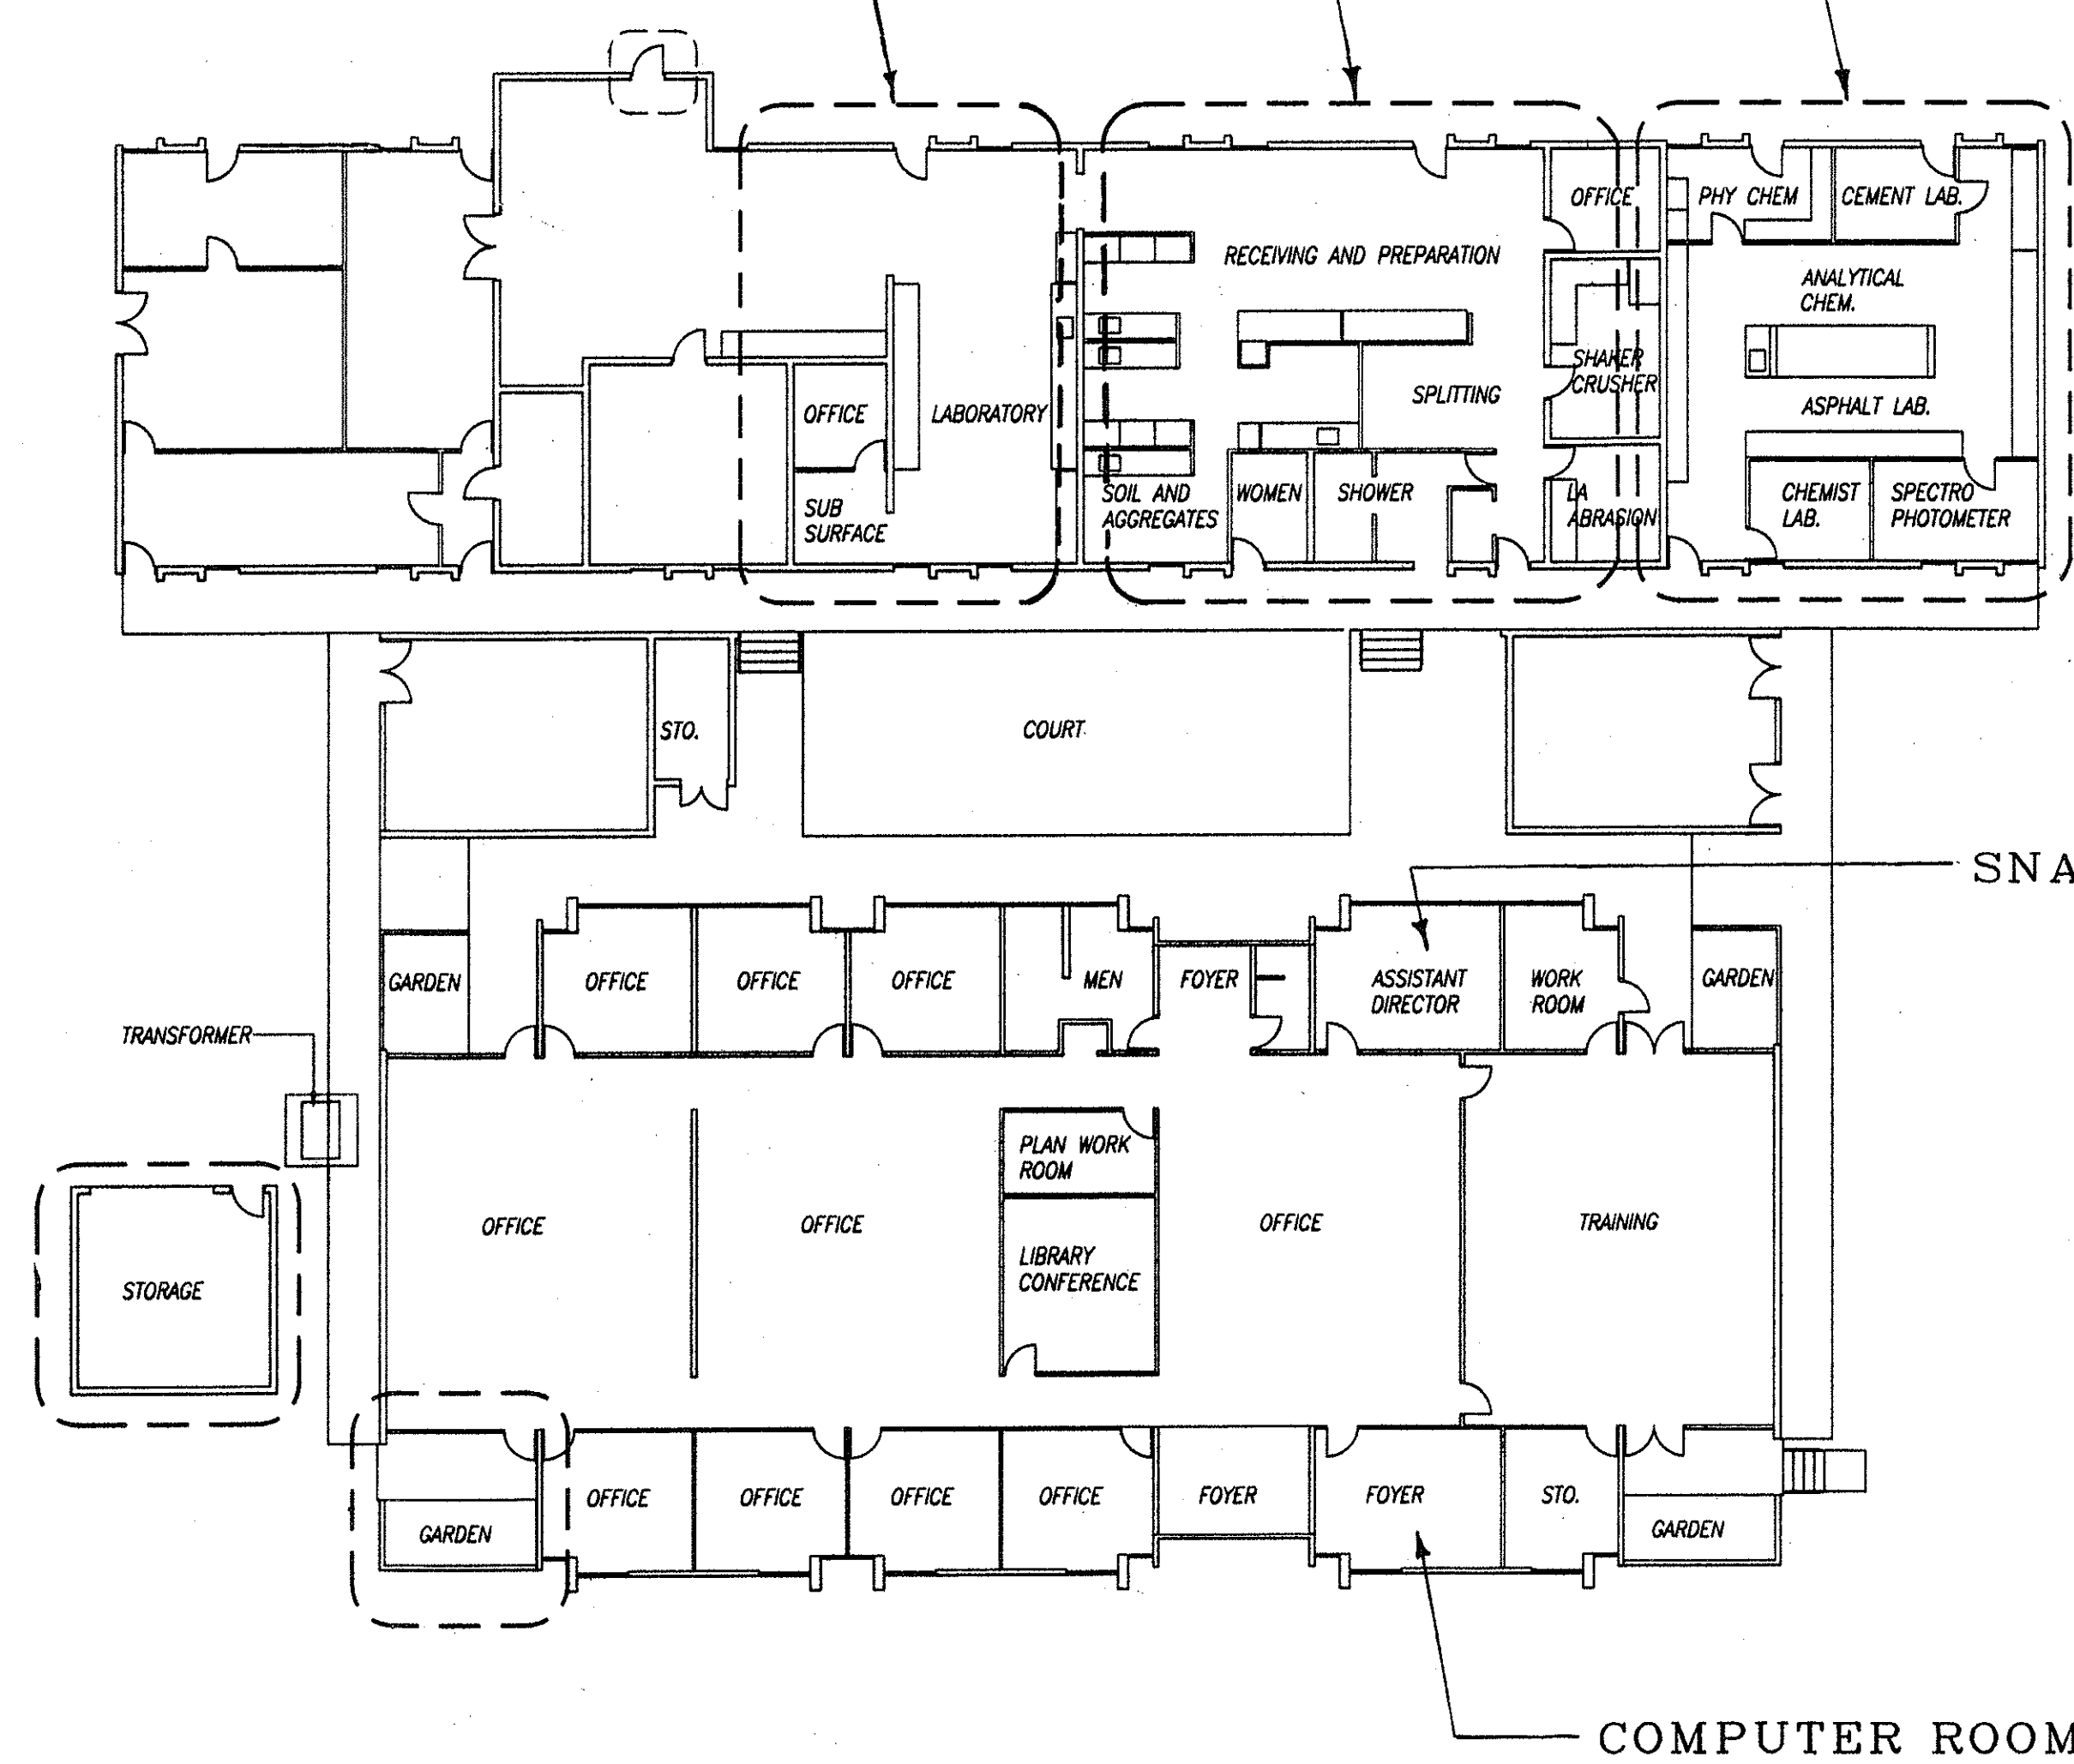

SNACK ROOM/WORK ROOM-1 EA.

COMPUTER ROOM-3 EA.

SUMMARY:

CONTRACT ITEMS: (ADDITIONAL)

CONTRACT ITEM NO. 628.0200-REMOVE FLUORESCENT FIXTURE

ANALYTICAL CHEM./ASPHALT LAB. _____ 17 EA.
WORK ROOM. _____ 1 EA.
FOYER (COMPUTER ROOM). _____ 3 EA.
TOTAL _____ 21 EA.

CONTRACT ITEM NO. 628.0220-TYPE B FIXTURE

ANALYTICAL CHEM./ASPHALT LAB. _____ 17 EA.
WORK ROOM. _____ 1 EA.
FOYER (COMPUTER ROOM). _____ 3 EA.
TOTAL _____ 21 EA.

EXTRA WORK ITEM

CONTRACT ITEM NO. 628.0400-ADDITIONAL TYPE B FIXTURE

RECEIVING AND PREPARATION _____ 31 EA.
LABORATORY _____ 28 EA.
TOTAL _____ 59 EA.

SURVEY PLOTTED BY	DATE
DRAWN BY	12/4/01
DESIGNED BY	
QUANTITIES BY	
CHECKED BY	

ORIGINAL PLAN	NOTE BOOK
PLAN	NOTE BOOK
PLAN	NOTE BOOK
PLAN	NOTE BOOK
PLAN	NOTE BOOK

THIS SHEET PREPARED DURING "AS-BUILT POSTING"

STATE OF HAWAII
DEPARTMENT OF TRANSPORTATION
HIGHWAYS DIVISION

ELECTRICAL RELAMPING PLAN

MATERIAL TESTING
AND RESEARCH BRANCH
Project No. HWY-0-01-00M

Date: May, 2000

SHEET No. 1 OF 1 SHEETS