




FED. ROAD DIST. NO.	STATE	PROJ. NO.	FISCAL YEAR	SHEET NO.	TOTAL SHEETS
HAWAII	HAW.	HWY-0-05-76	1979	6	6

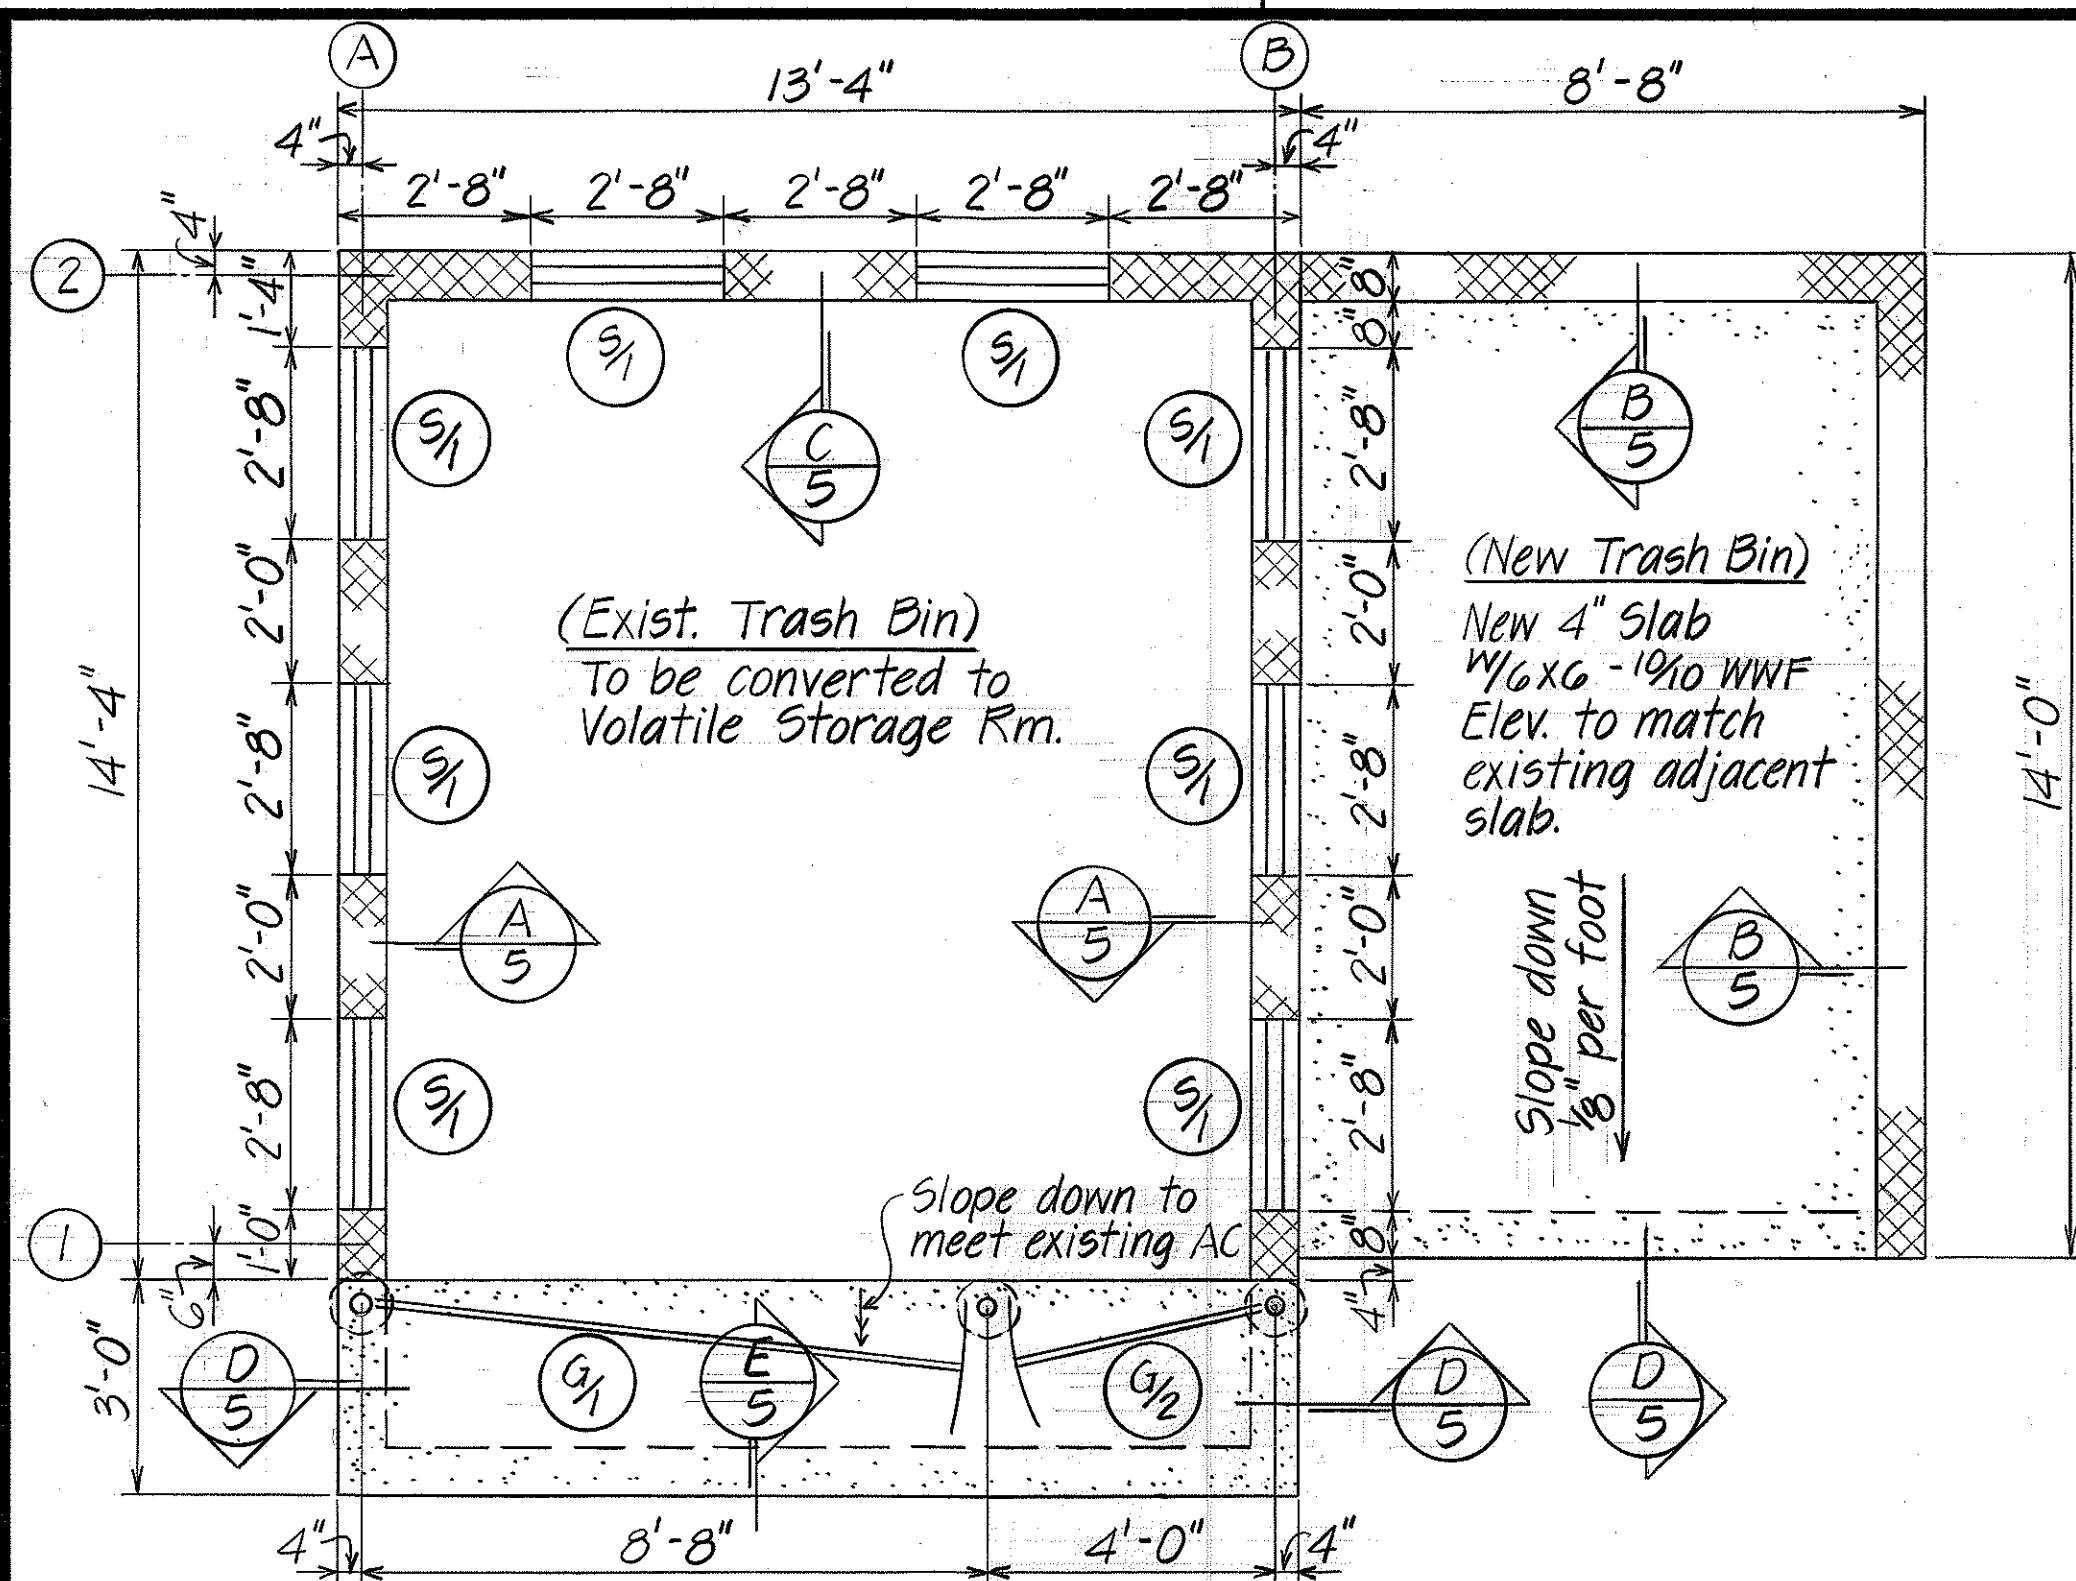


FLOOR PLAN Scale: 3/8" = 1'-0"

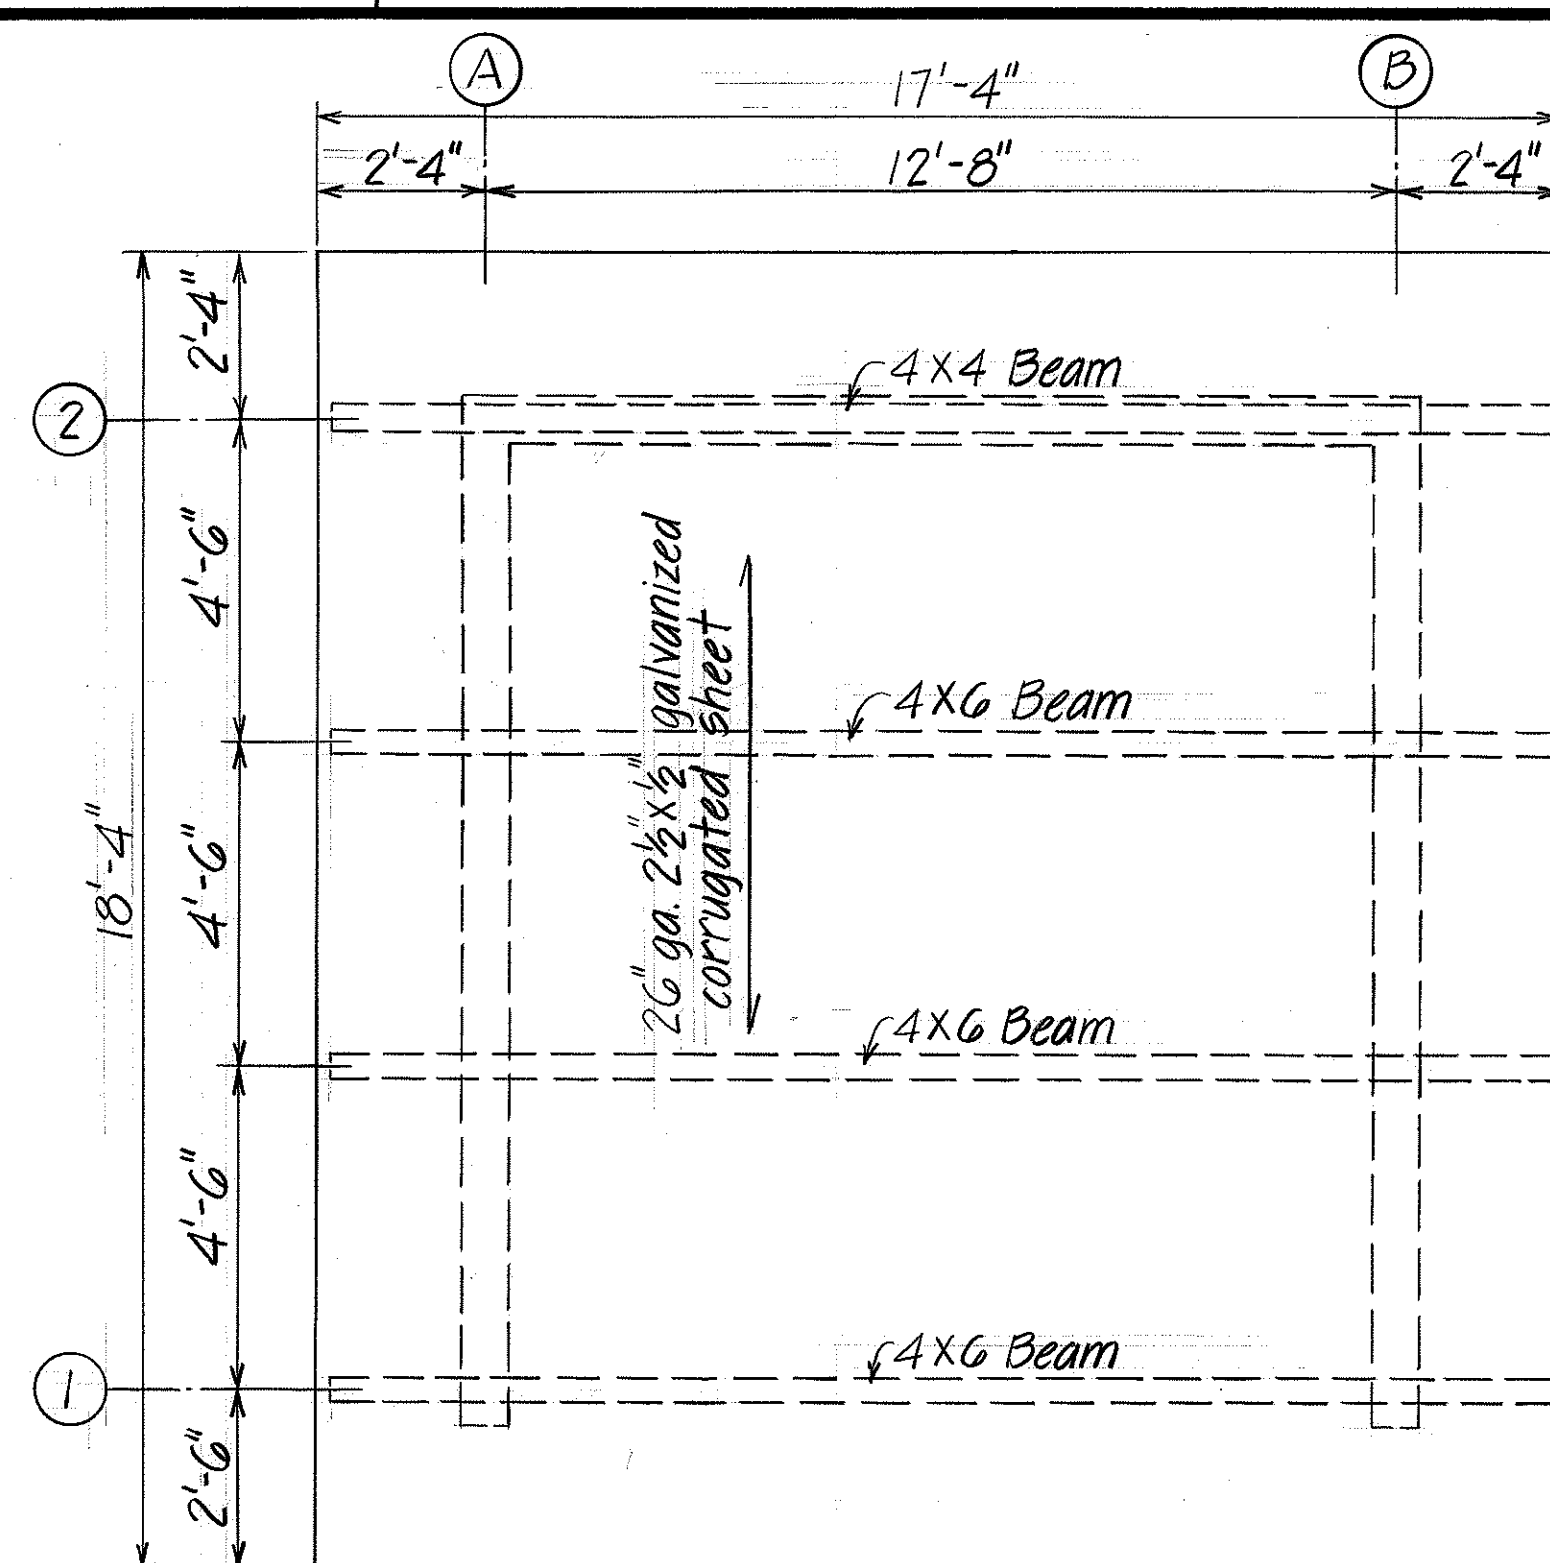


ROOF FRAMING PLAN Scale: 3/8" = 1'-0"

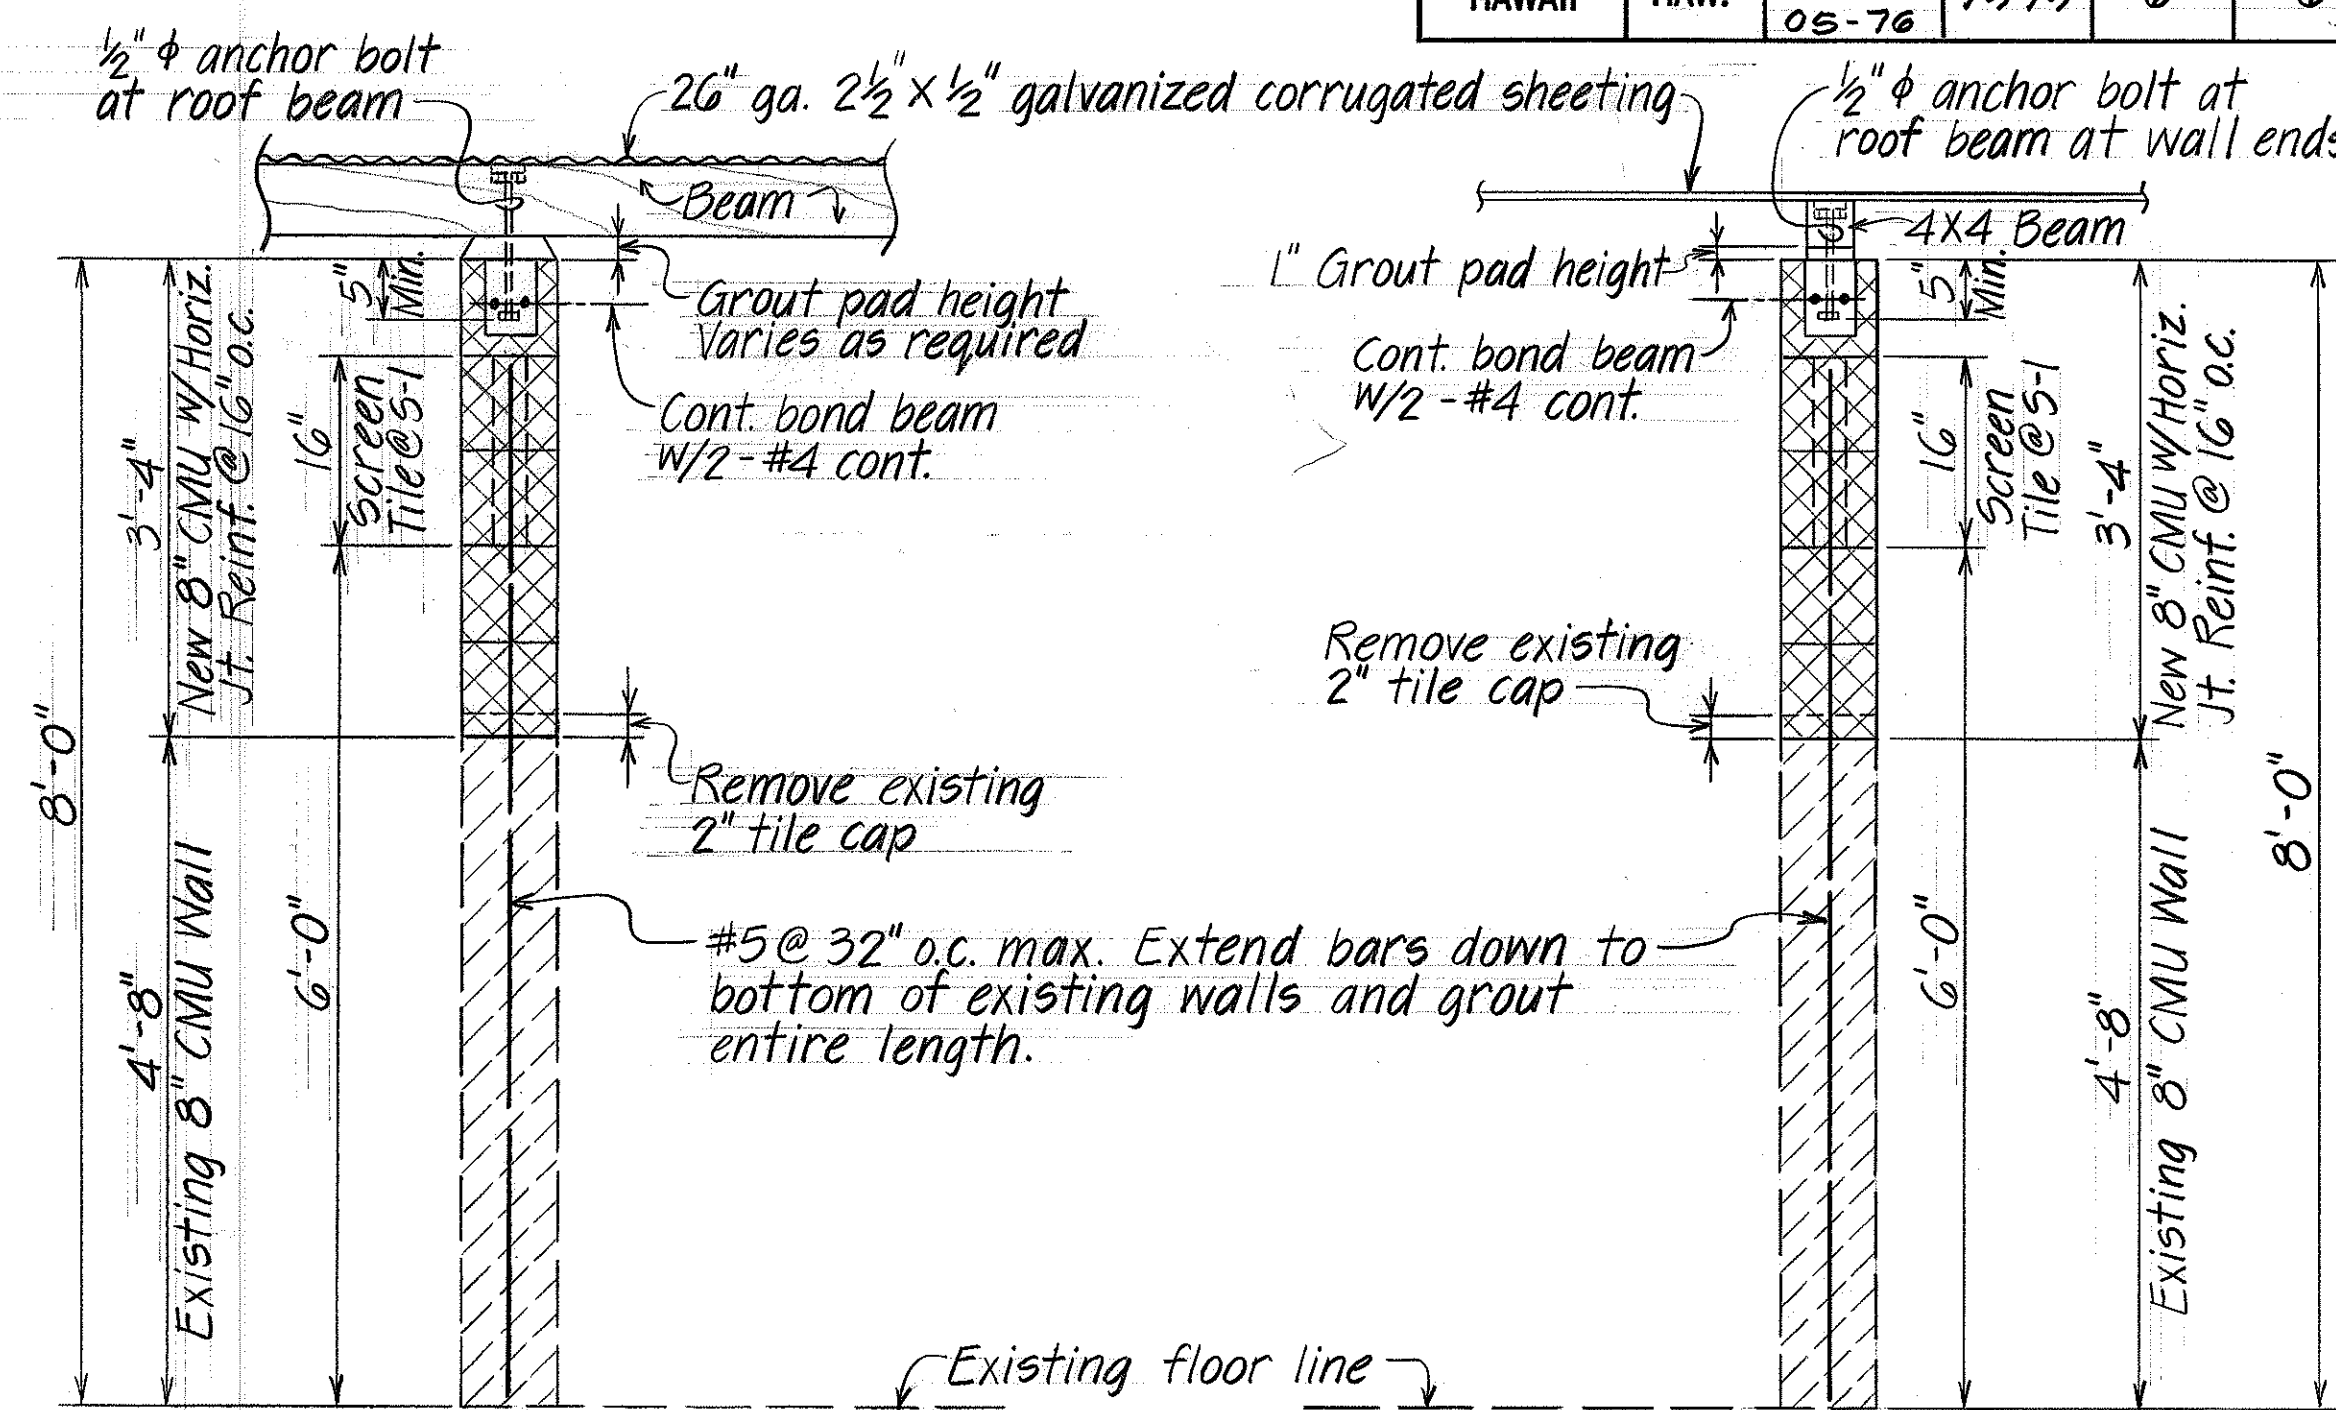

TYPICAL SECTION A-C Scale: 3/4" = 1'-0" SECTION C-C

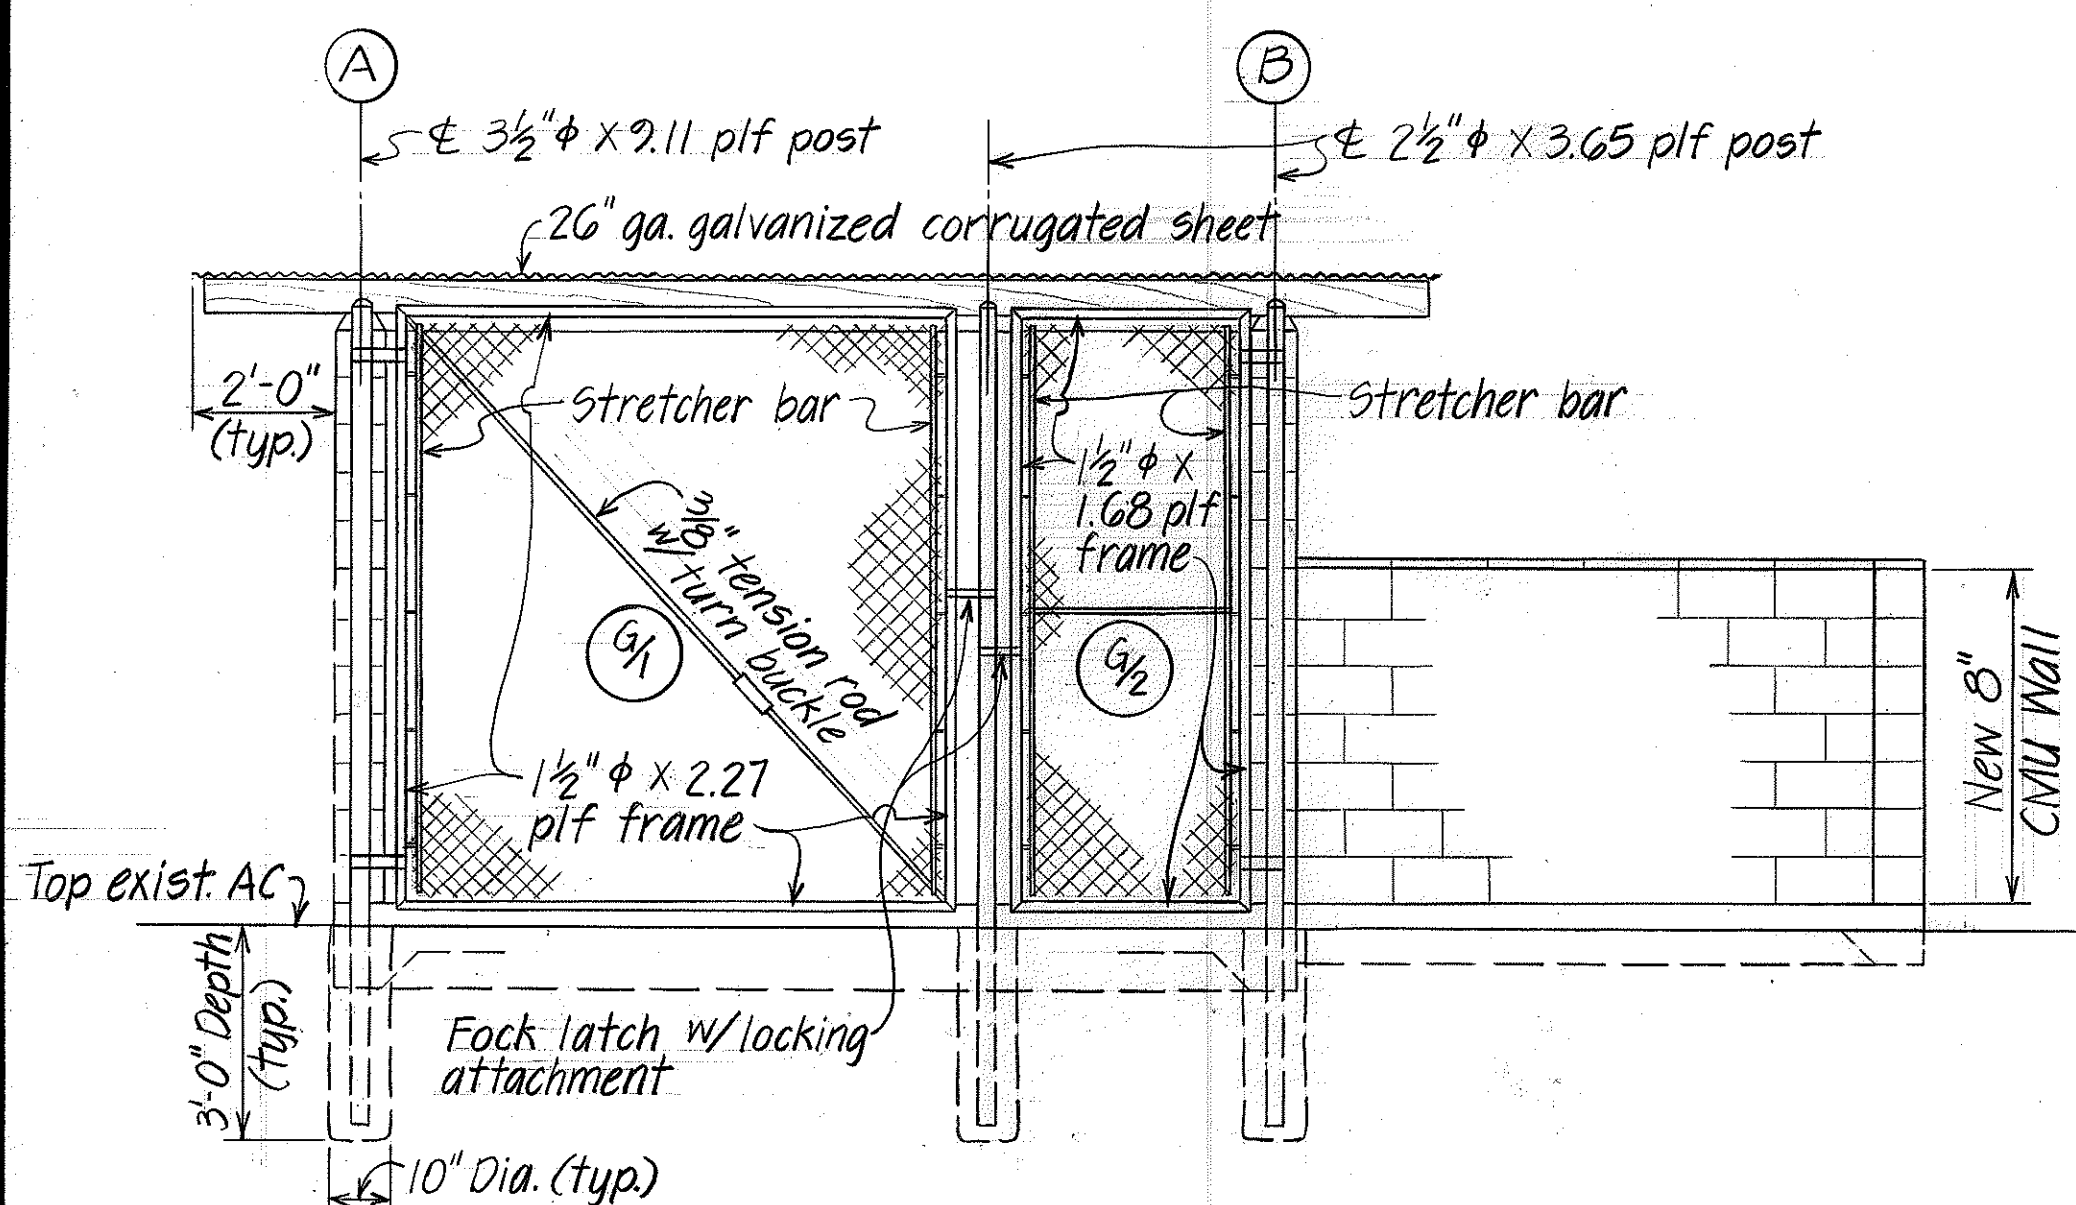


FRONT ELEVATION Scale: 3/8" = 1'-0"

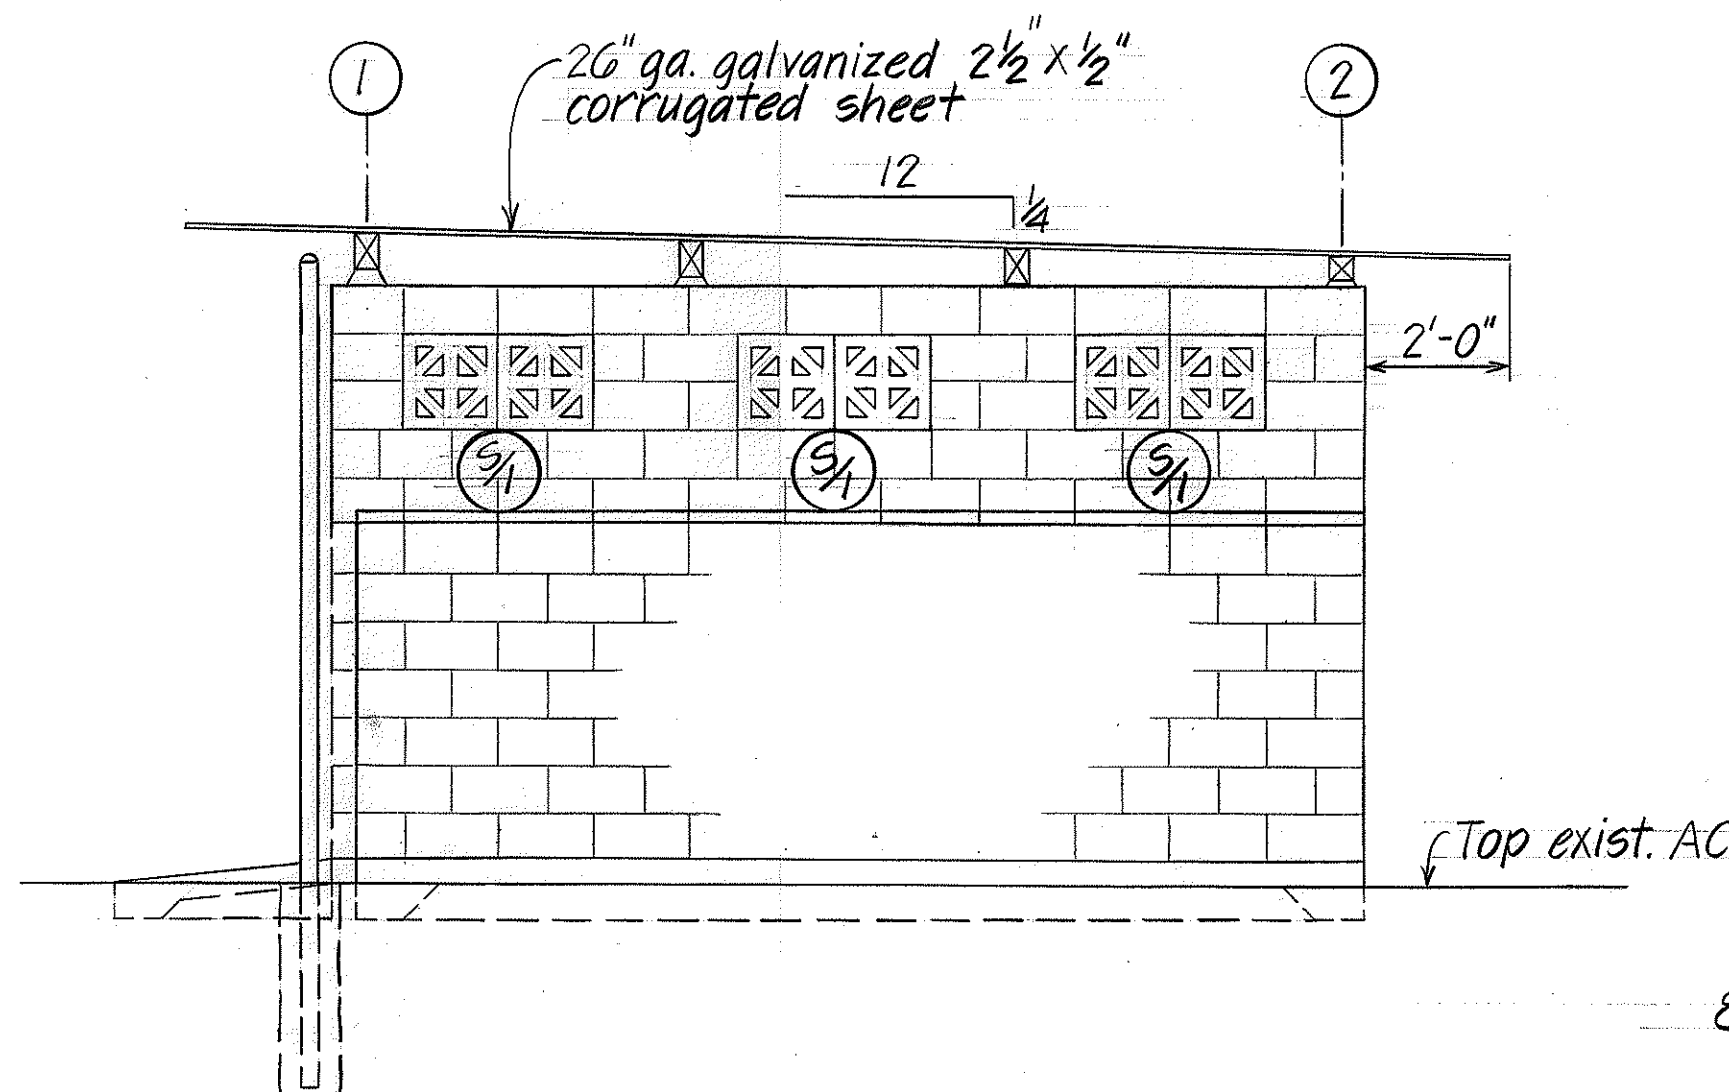


RIGHT SIDE ELEVATION Scale: 3/8" = 1'-0"

(Left Side Elevation - Opposite Hand Except For Trash Bin)

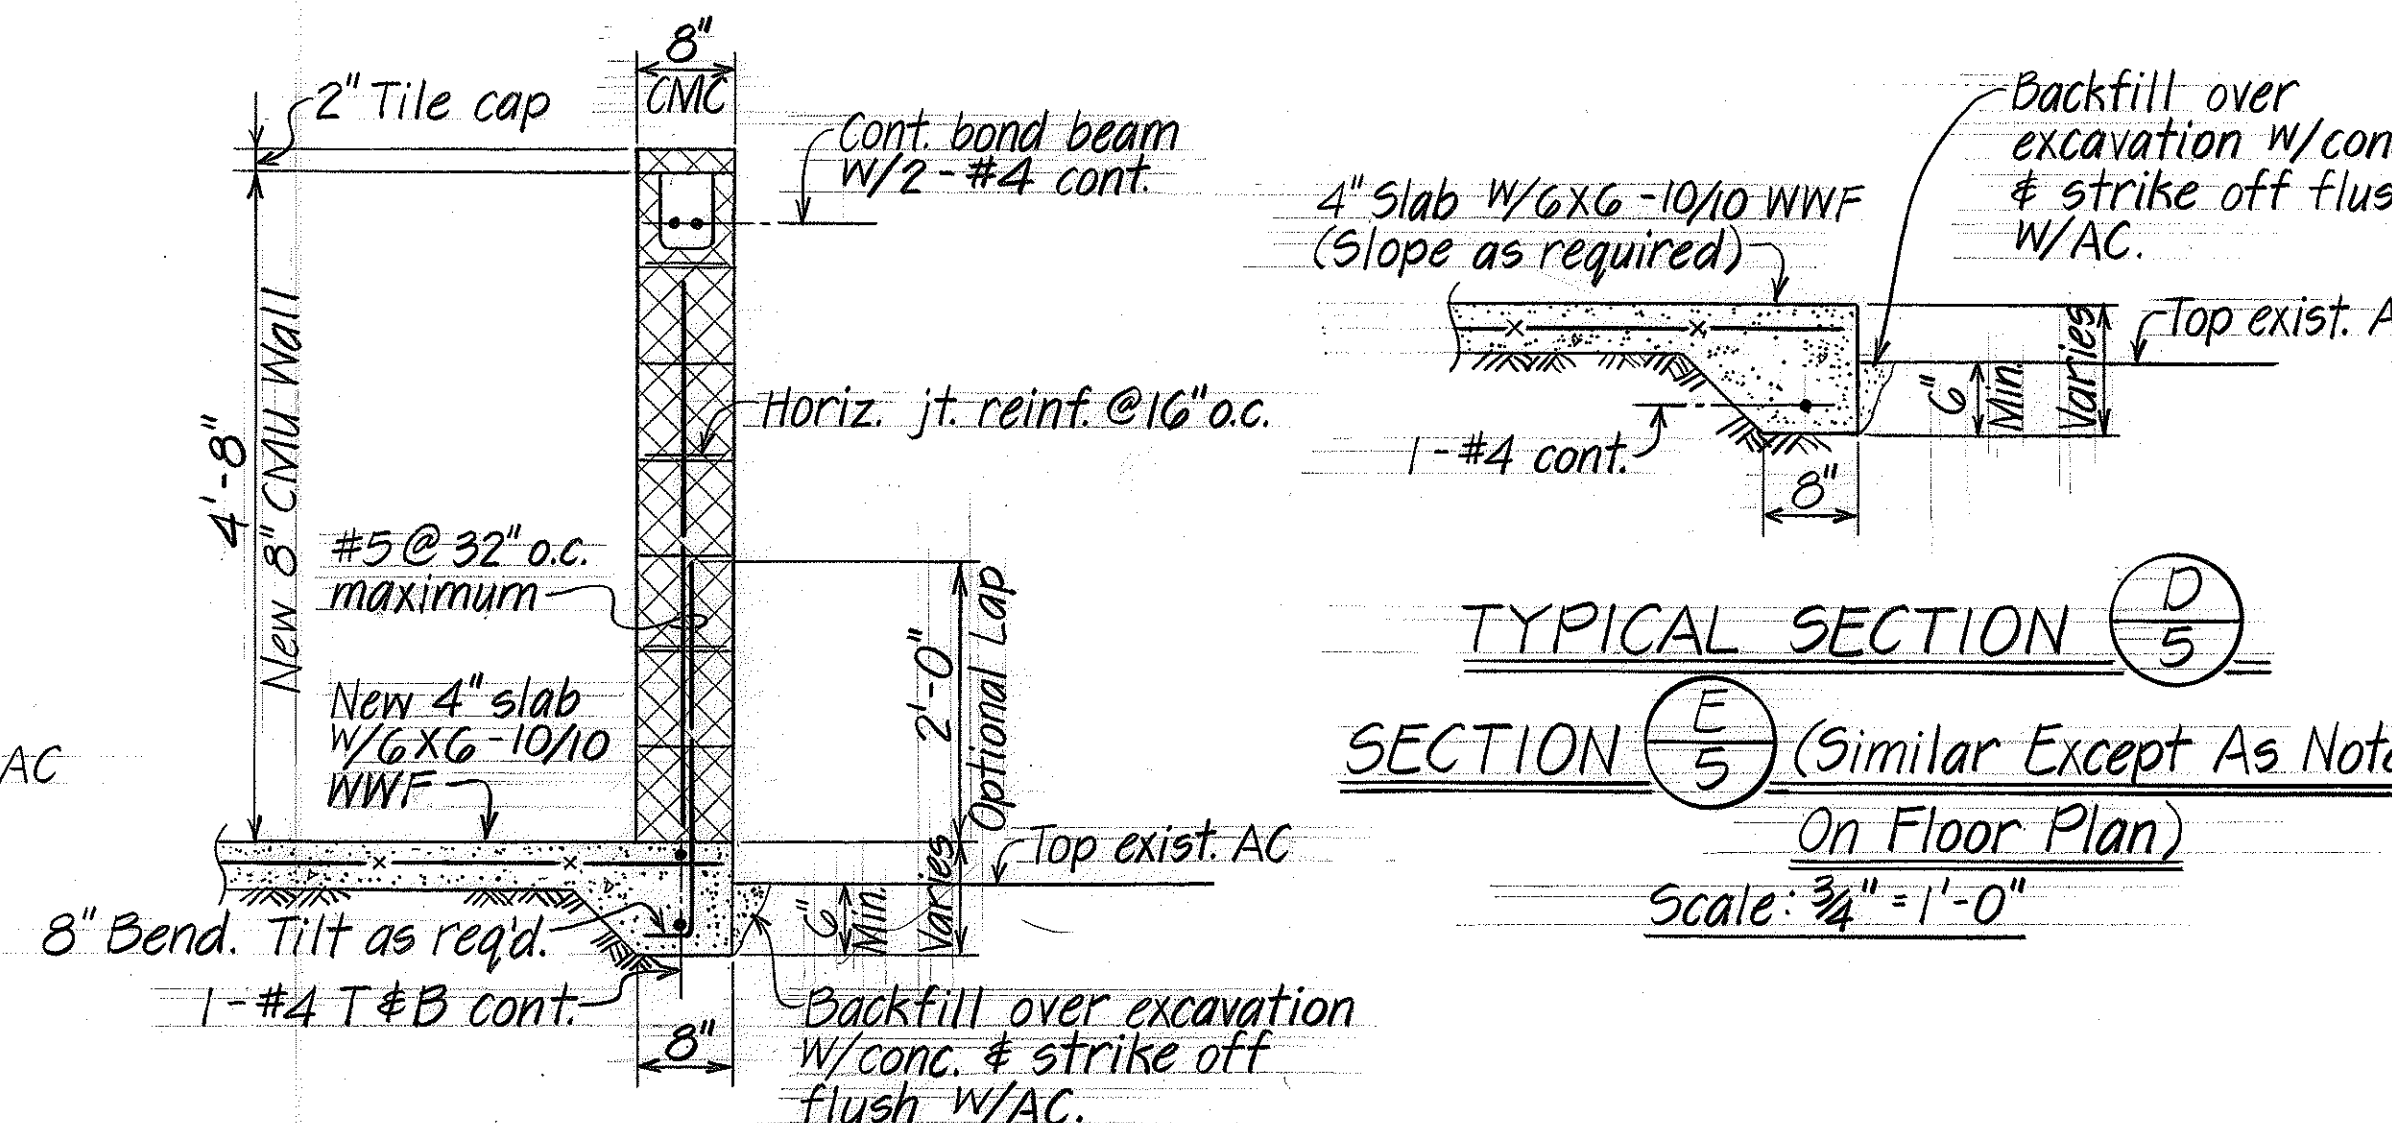

TYPICAL SECTION D-E Scale: 3/4" = 1'-0" SECTION E-E (Similar Except As Noted On Floor Plan)

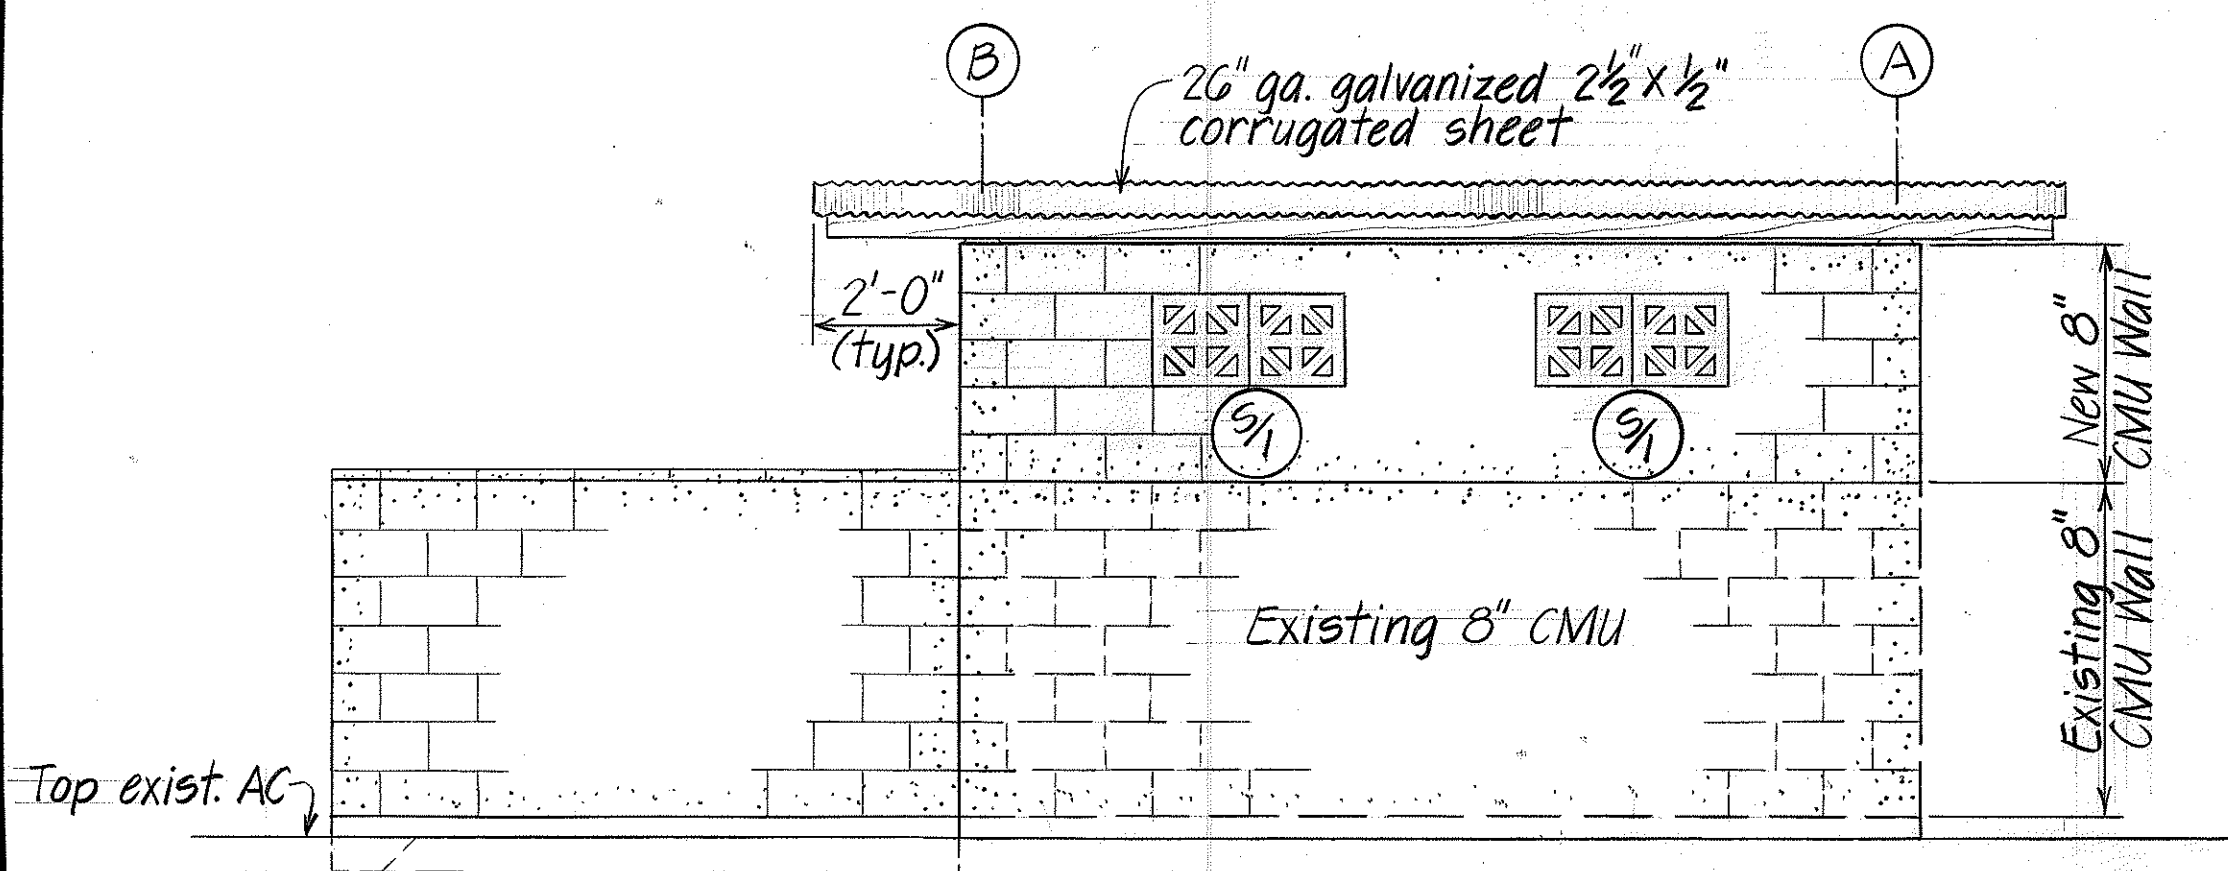

BACK ELEVATION Scale: 3/8" = 1'-0"

TYPICAL SECTION B-C Scale: 3/4" = 1'-0"

STATE OF HAWAII
DEPARTMENT OF TRANSPORTATION
LAND TRANSPORTATION FACILITIES DIVISION
**VOLATILE STORAGE ROOM
AND TRASH BIN STORAGE
MATERIALS LABORATORY**
PROJ. NO. HWY-0-05-76
Scale: As Noted Date: March 1979
SHEET NO. 5 OF 5 SHEETS