

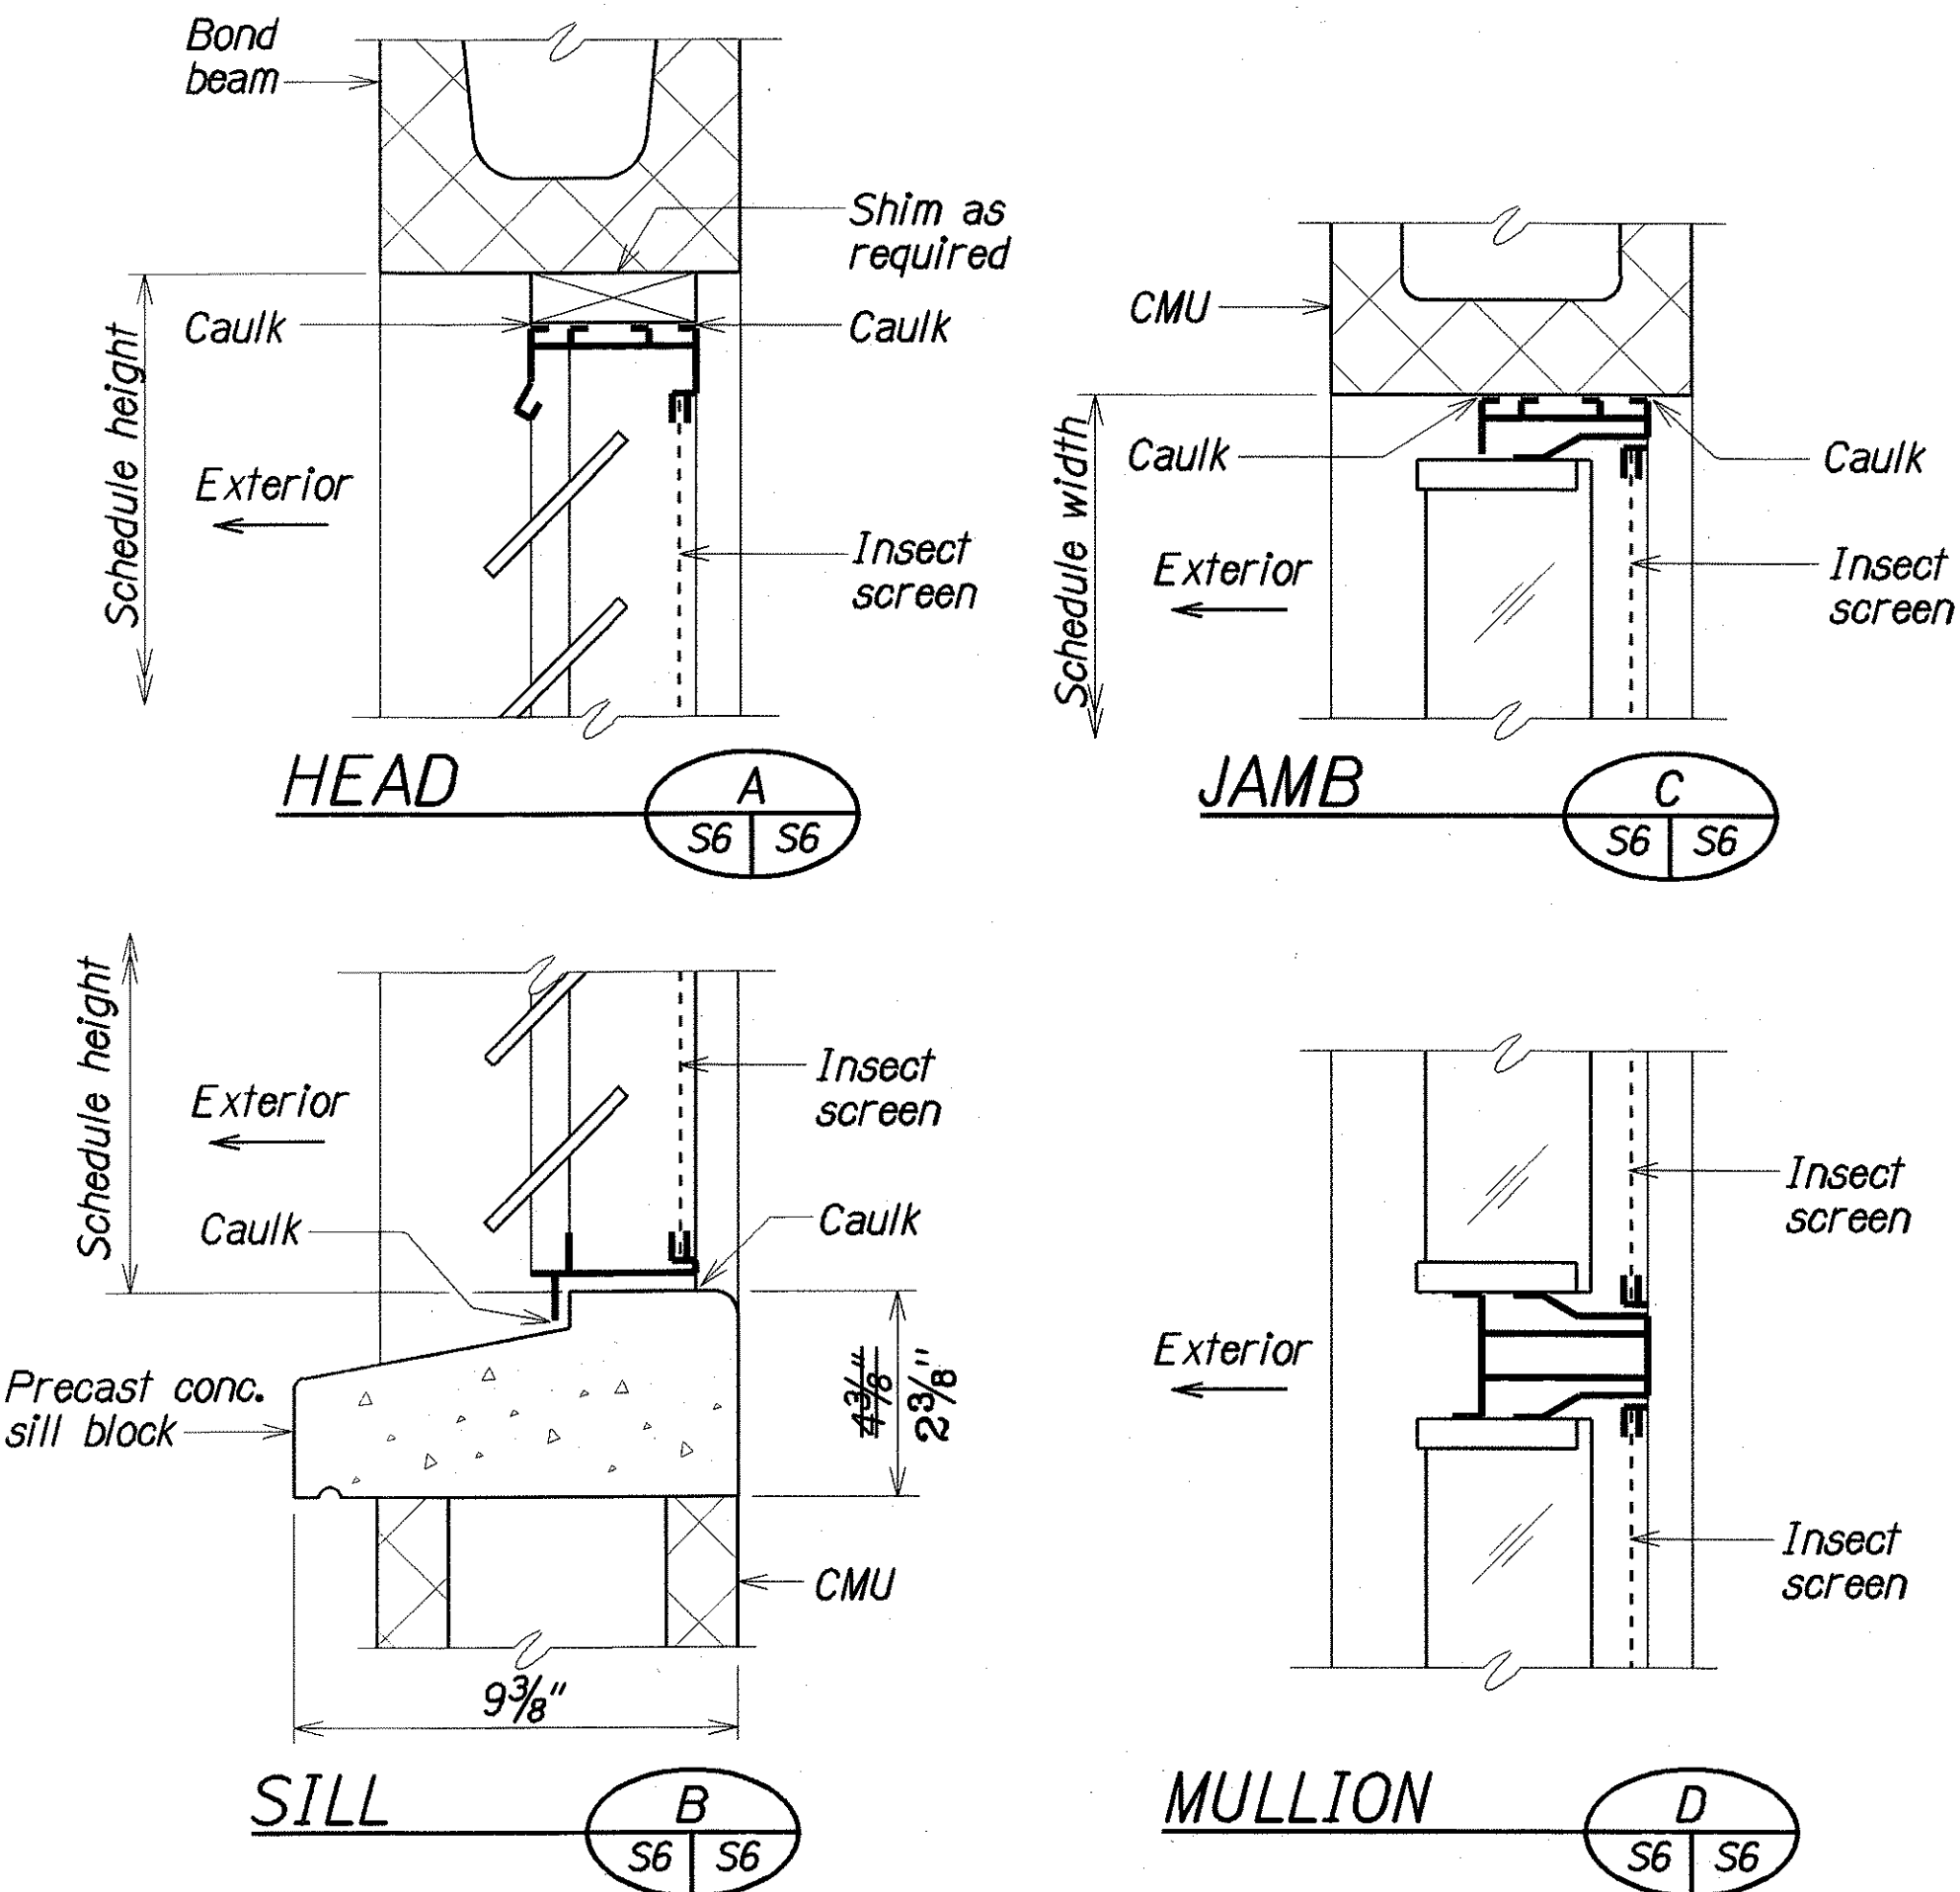
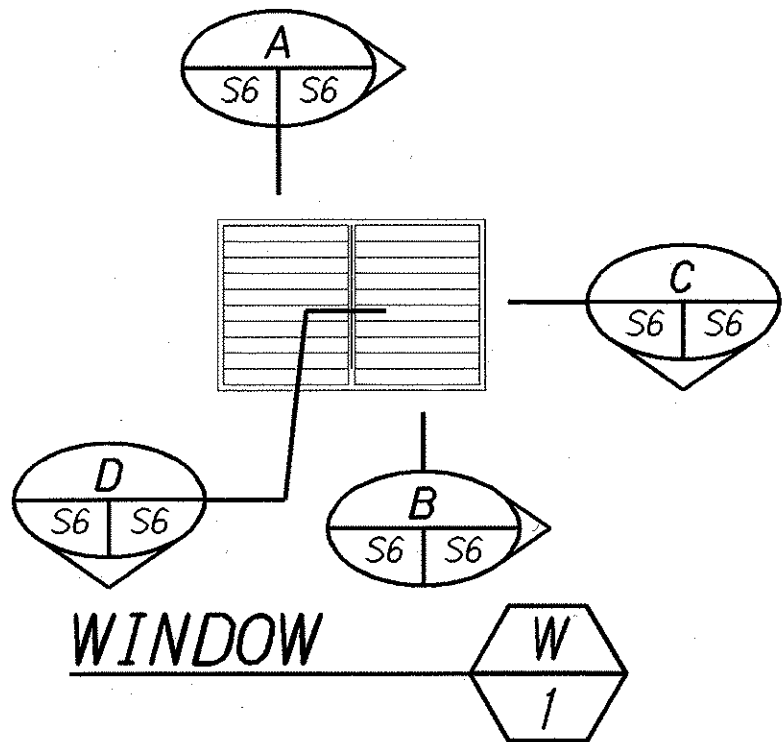


FED. ROAD DIST. NO.	STATE	PROJ. NO.	FISCAL YEAR	SHEET NO.	TOTAL SHEETS
HAWAII	HAW.	HWY-0-09-91	1997	7	7

WINDOW SCHEDULE				
NO.	SIZE	OPENING	MATERIAL	REMARKS
W 1	5'-4" x 3'-4"	5'-4" x 3'-4"	Aluminum Frame w/ Obs. Glass Jalousie	Mullion Required. See D S6 S6

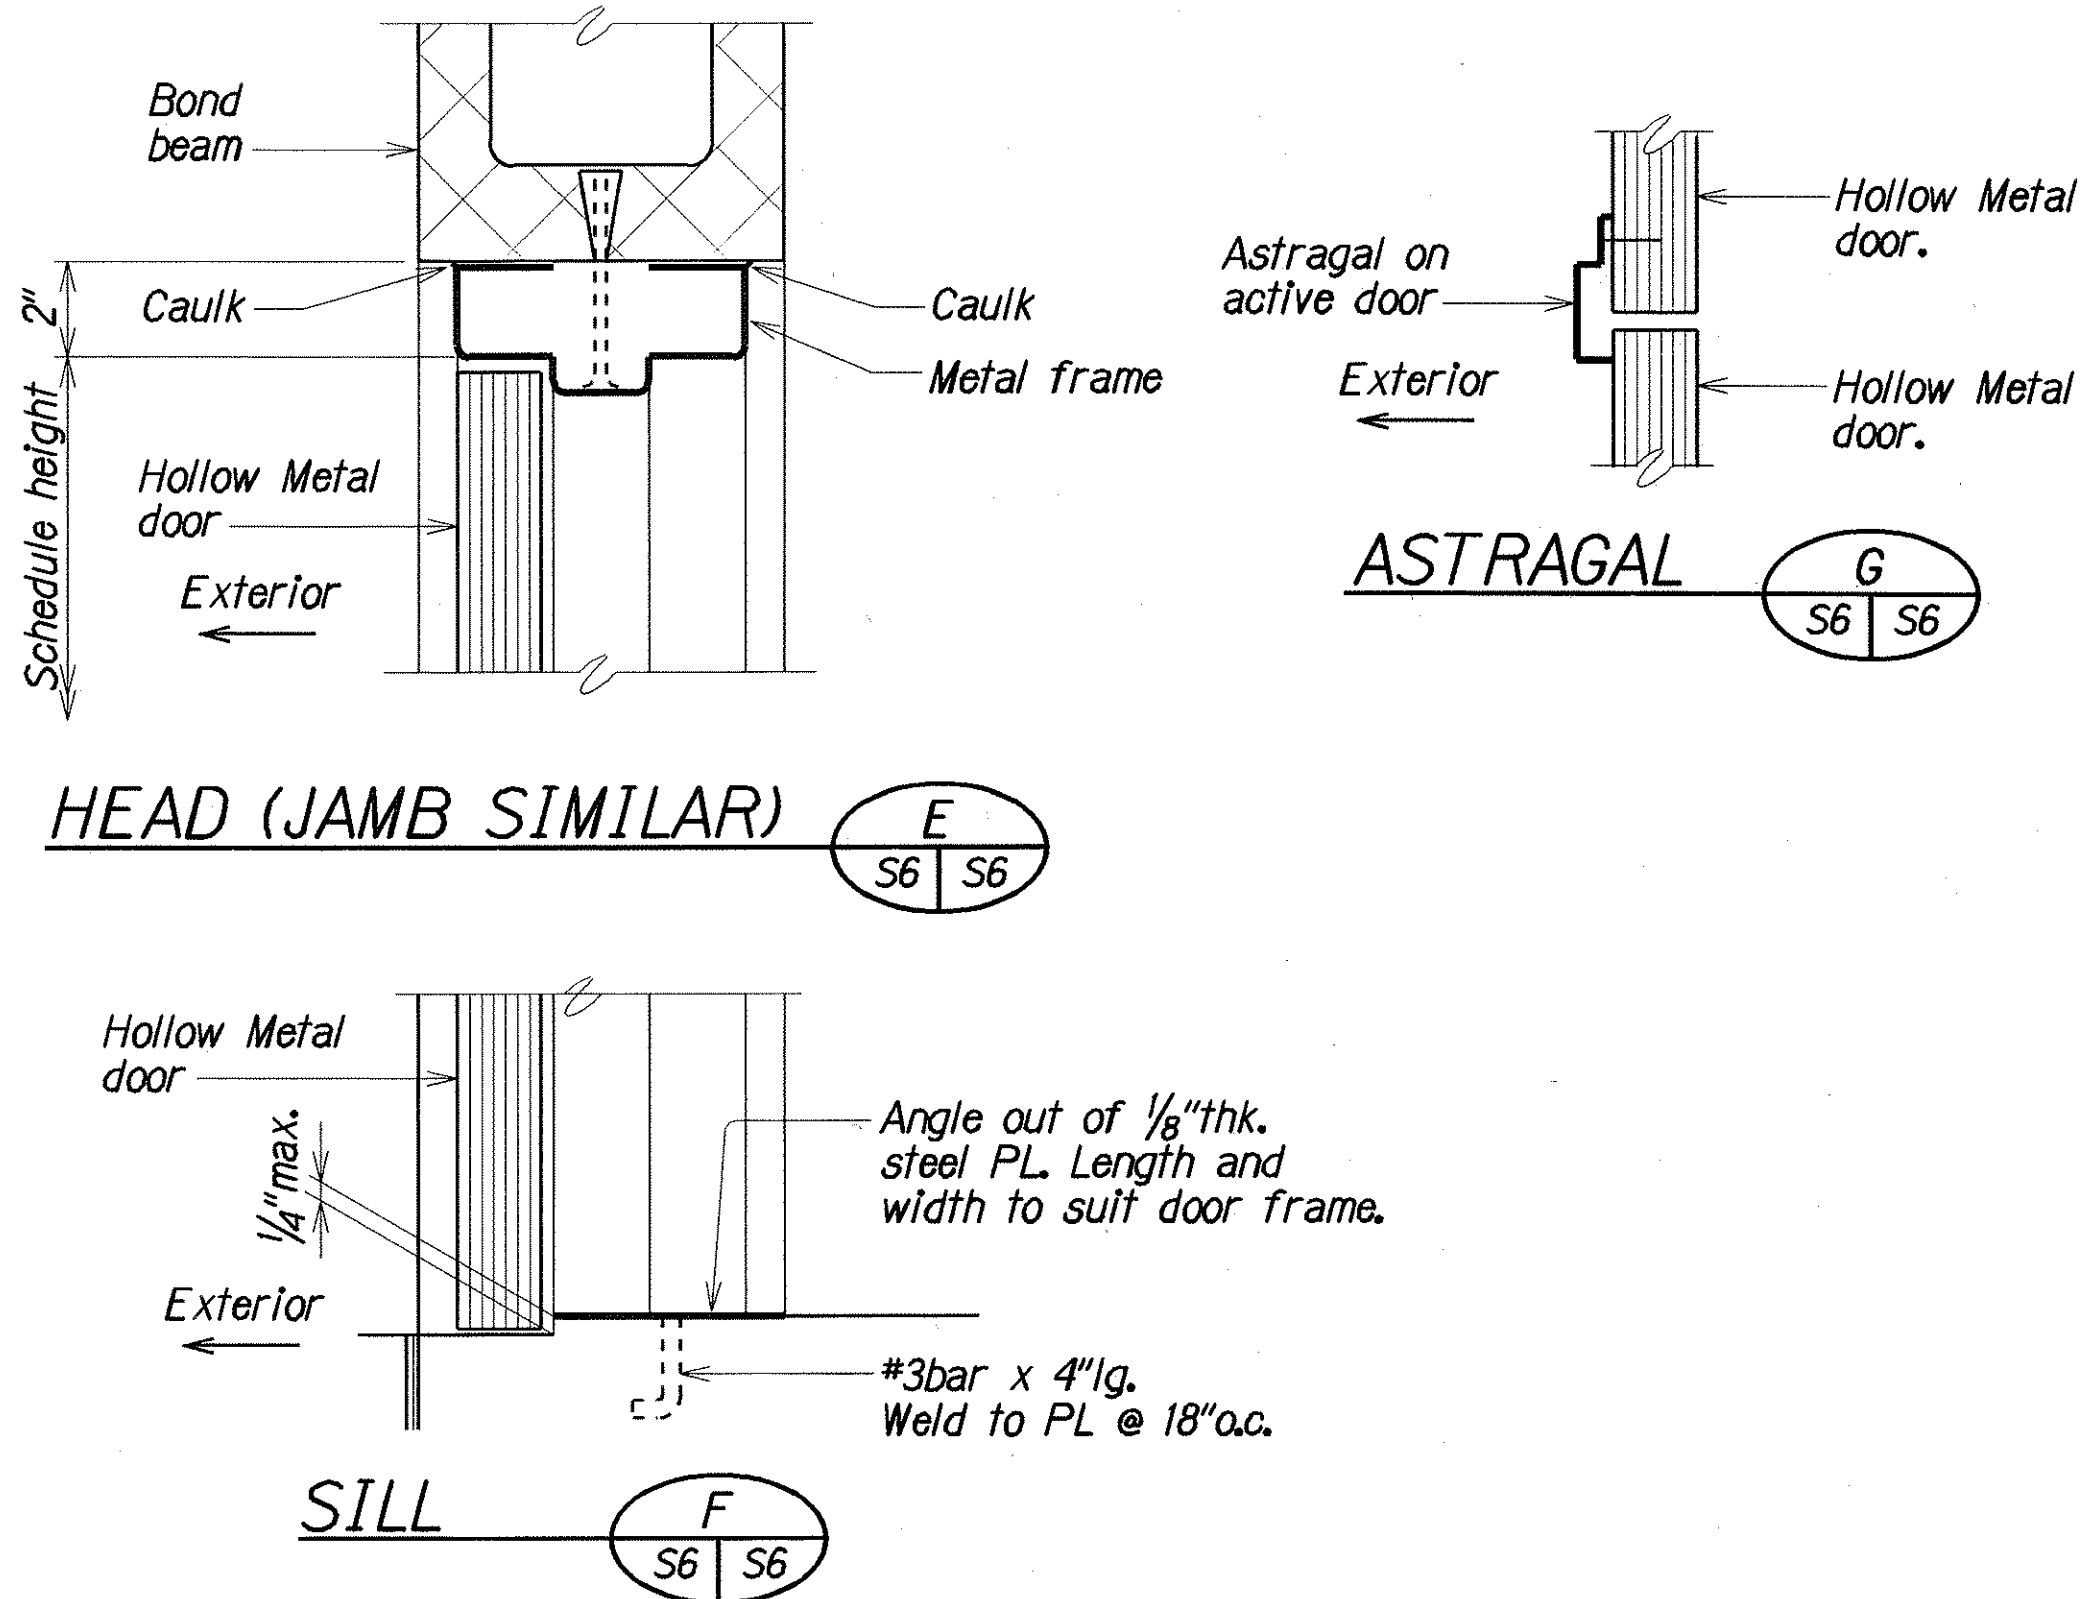

DOOR SCHEDULE							
NO.	SIZE (WxH)	R.O. (WxH)	THK	TYPE	CORE	MATERIAL	REMARKS
D 1	5'-8" x 7'-0"	6'-0 1/2" x 7'-4"	1 3/4"	A	Honeycomb	Metal	Double Metal Door W/Dead Bolt
D 2	3'-0" x 7'-0"	3'-4 1/2" x 7'-4"	1 3/4"	B	Honeycomb	Metal	Metal Door W/Dead Bolt
D 3	12'-0" x 10'-0"	11'-4" x 9'-4"	--	--	--	Metal	Roll-Up Door

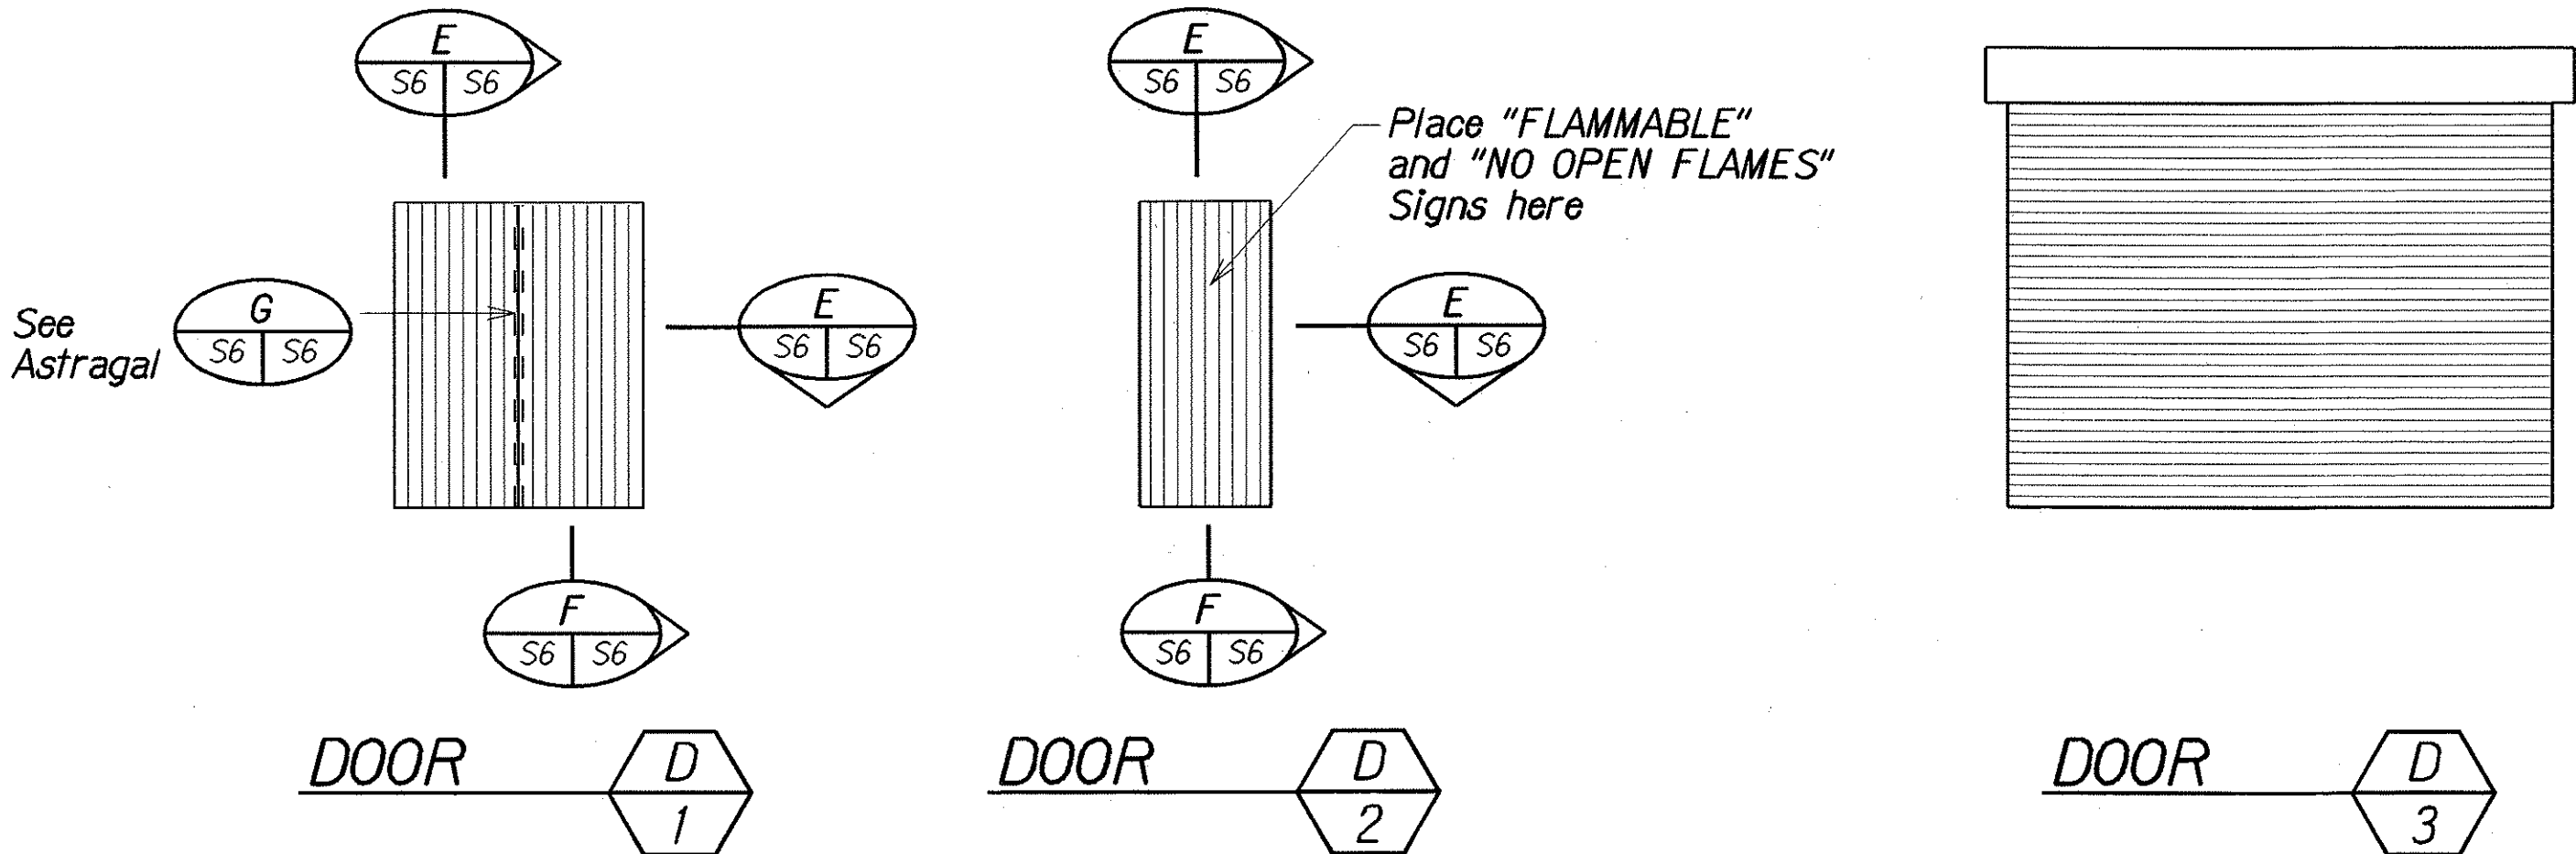

DOOR AND WINDOW SCHEDULES

Not to Scale

LEGEND FOR AS-BUILT POSTINGS

	Squiggly line for as-built deletion
	Double line for as-built deletion
Roadway	Text for as-built posting

STATE OF HAWAII
DEPARTMENT OF TRANSPORTATION
HIGHWAYS DIVISION

DOOR AND WINDOW SCHEDULES

MATERIAL TESTING LAB,
CONSTRUCT HAZARDOUS WASTE STORAGE SHED
Project No. HWY-0-09-91

Scale: As Noted

Date: Mar, 1997

SHEET No. S6 OF 6 SHEETS

"AS-BUILT"