

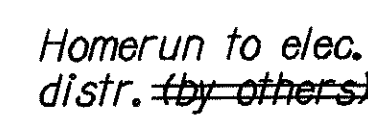
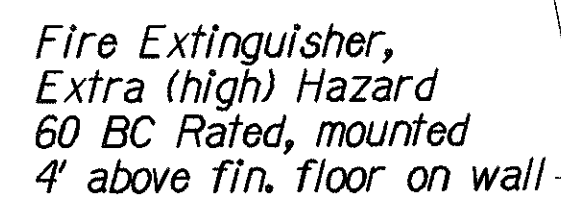


Note:
For plywood connection,
use 8d galv. common
nails 6" o.c. at edges; 12" o.c.
along interior supports

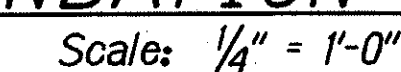

LEGEND FOR
AS-BUILT POSTINGS

- | | |
|---|-------------------------------------|
|  | Squiggly line for as-built deletion |
| 100.00 | Double line for as-built deletion |
| Roadway | Text for as-built posting |

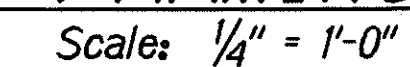

Scale: As Noted

Date: Mar, 1997

SHEET No. 52 OF 6 SHEETS