	INDEX TO DRAWINGS
SHEET NO.	DESCRIPTION
1	TITLE SHEET
2	LOCATION AND LAYOUT PLANS
	GENERAL NOTES, EST. QUANTITIES
3	FLOOR, ROOF FRAMING AND
	FOUNDATION PLANS
4	TYPICAL SECTION AND LIMITS OF
	STRUCTURE EXCAVATION & BACKFILL
5	DETAILS
6	EXTERIOR ELEVATIONS
7	DOOR AND WINDOW SCHEDULES

STATE OF HAWAII

DEPARTMENT OF TRANSPORTATION

HIGHWAYS DIVISION HONOLULU, HAWAII

"AS-BUILT"
PLANS FOR


MATERIAL TESTING LABORATORY


CONSTRUCT HAZARDOUS WASTE STORAGE SHED

PROJECT NO. HWY-O-09-91

2530 LIKELIKE HIGHWAY HONOLULU, HAWAII TAX MAP KEY 1–4–22:14

DISTRICT OF HONOLULU ISLAND OF OAHU

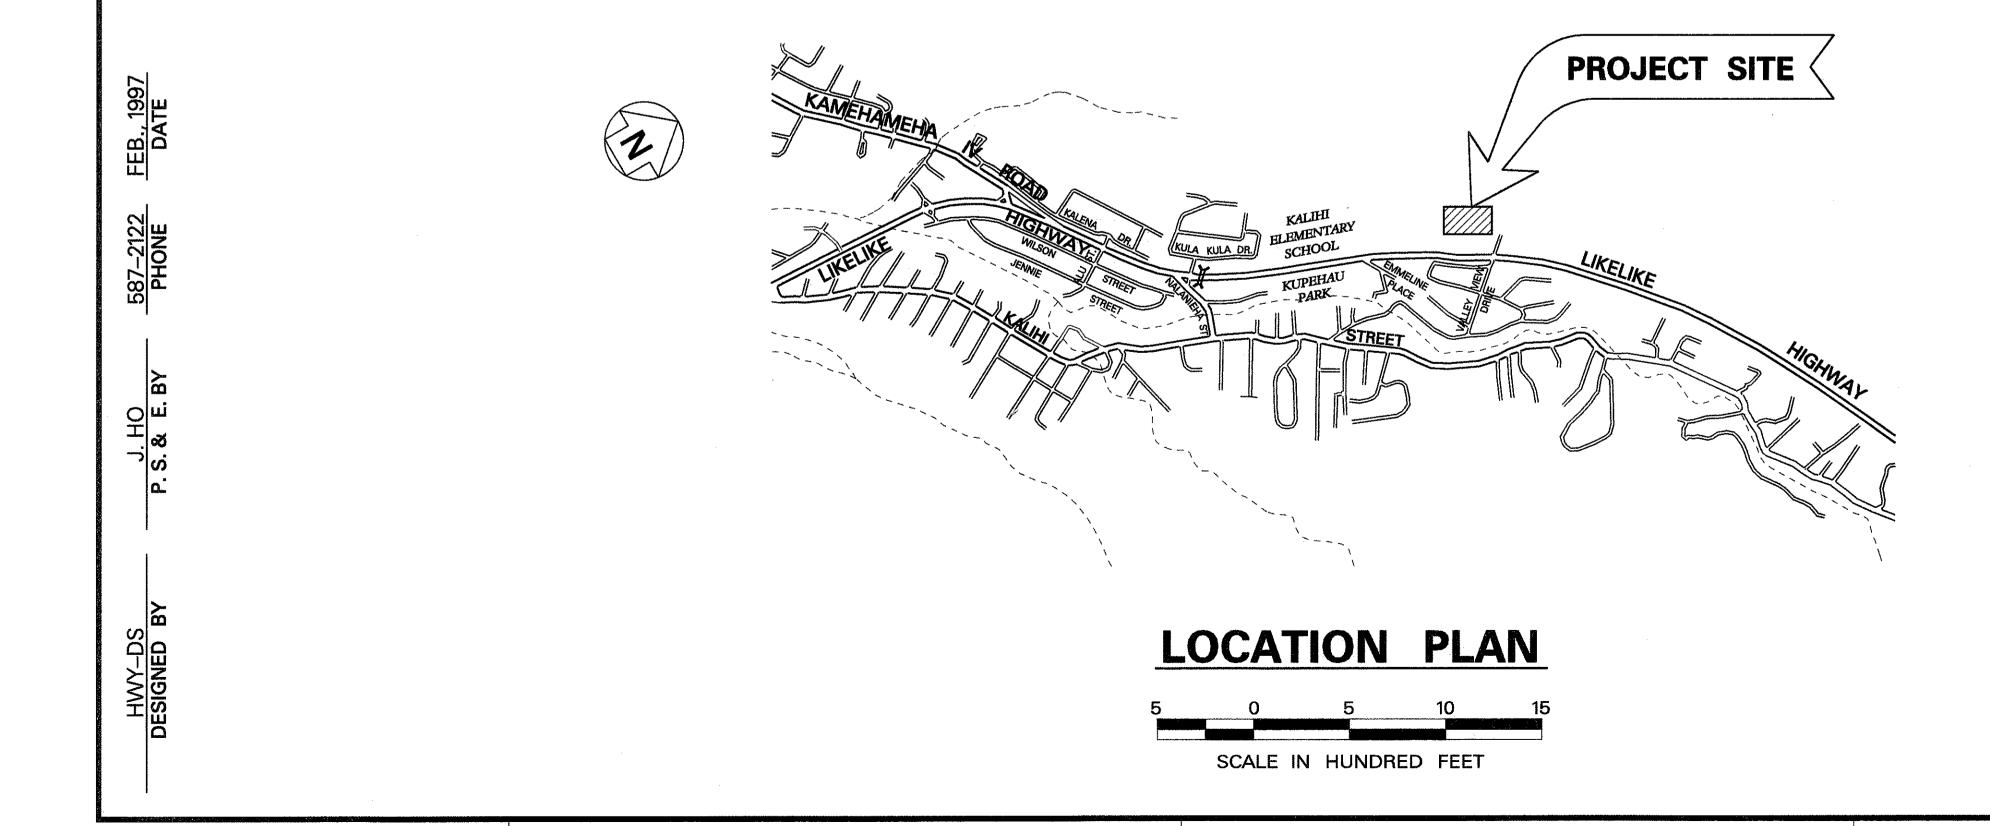

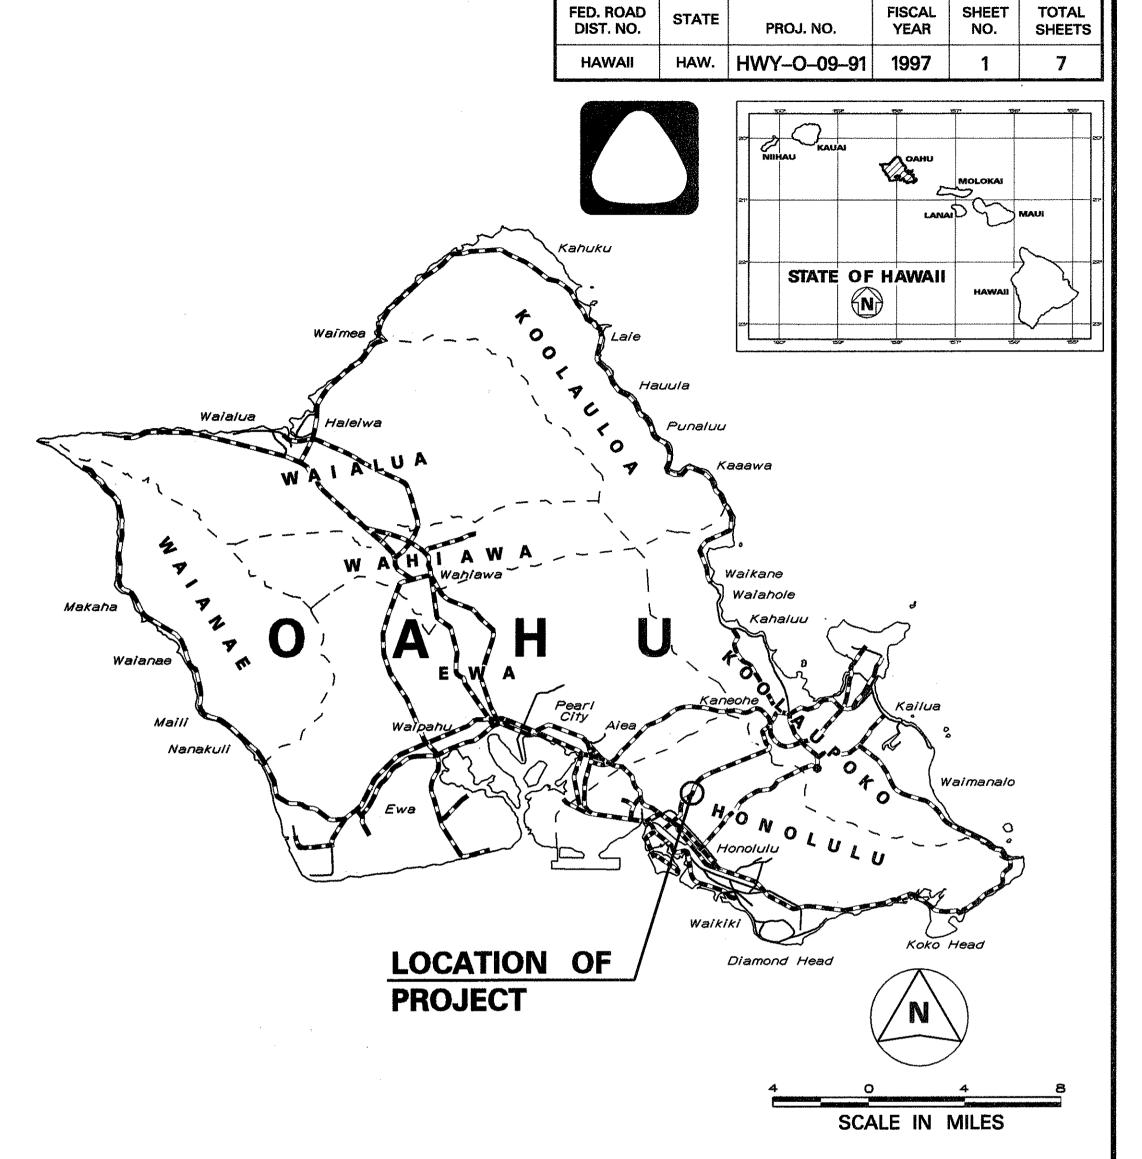

OR UNDER CONSTRUCTION

MILE POST 2.92 TO MILE POST 2.94

CHANGES WADE DURING CONSTRUCTION HAVE BEEN INCORPORATED ON THESE PLANS EXCEPT CHANGES IN THE ORIGINAL THEORETICAL QUANTITIES. FOR ACTUAL QUANTITIES, REFER TO PROJECT LEDGER AND/OR COMPUTATION BOOK.

Kelvin akagawa 12-10-0

DEPARTMENT OF TRANSPORTATION
STATE OF HAWAII

APPROVED:

| Lags | Jayochid | 3 / 24/97

DIR. OF TRANSPORTATION DATE

1