
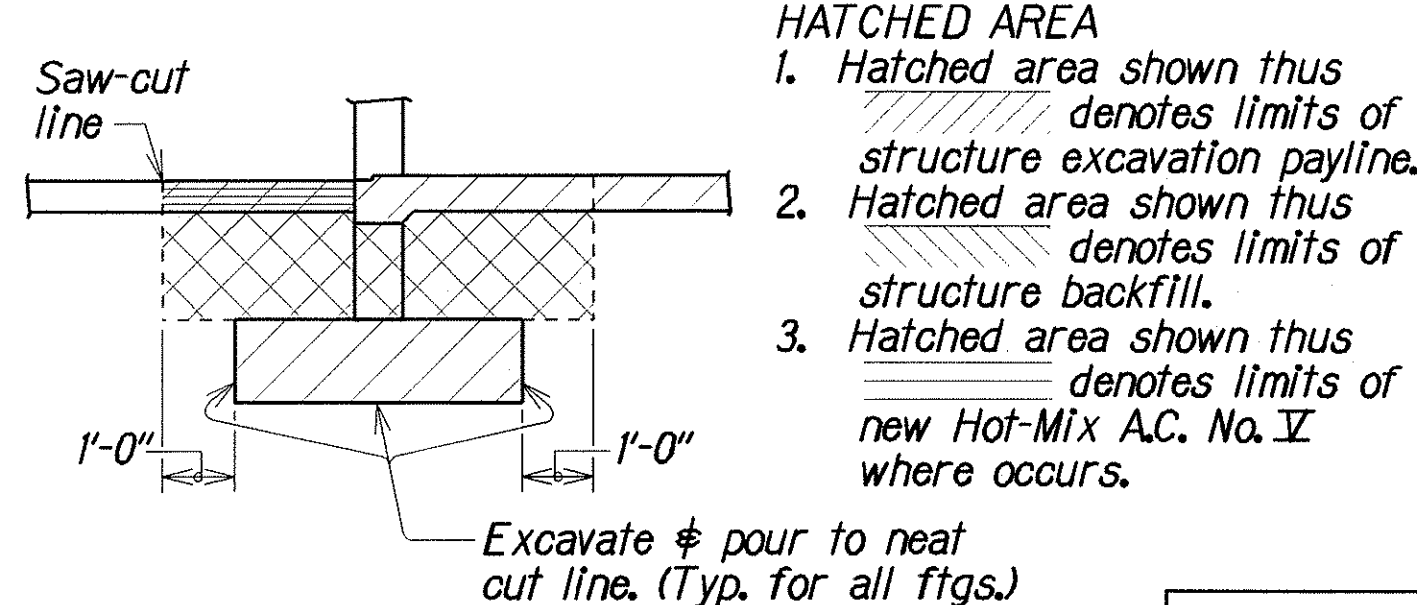
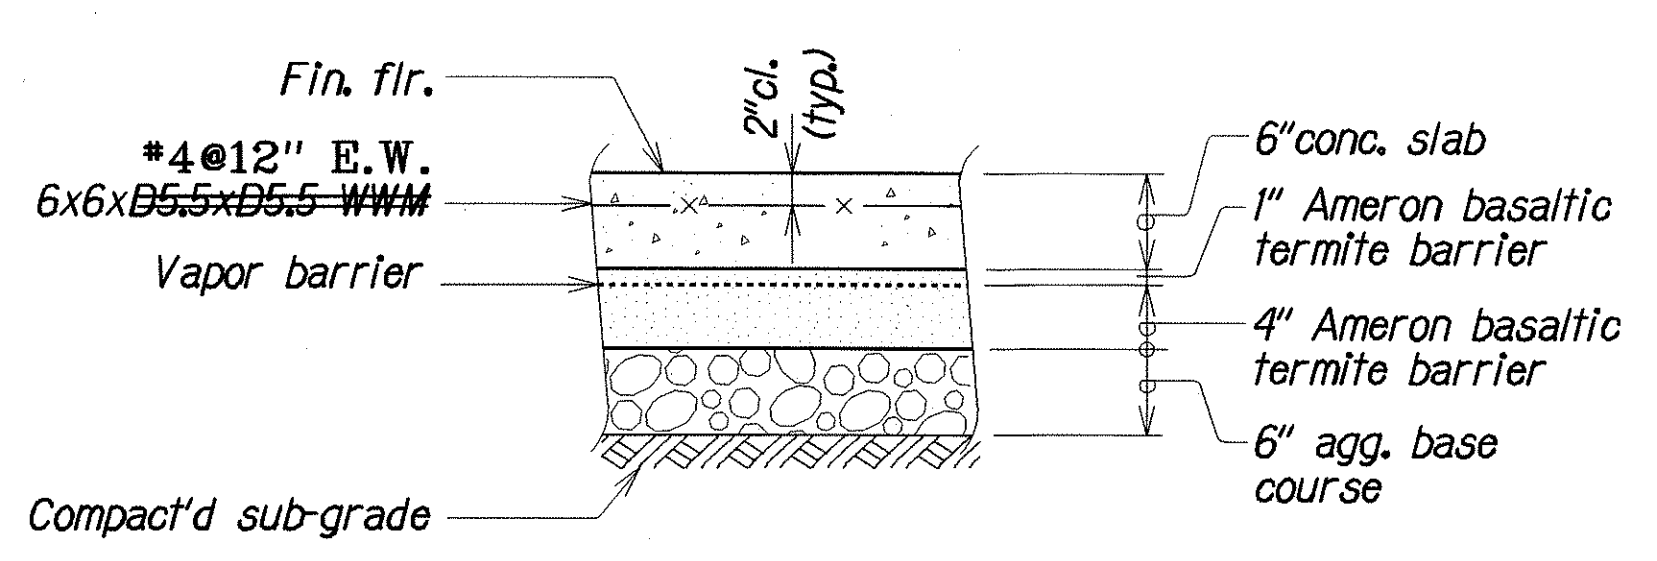


FED. ROAD DIST. NO.	STATE	PROJ. NO.	FISCAL YEAR	SHEET NO.	TOTAL SHEETS
HAWAII	HAW.	HWY-0-09-91	1997	4	7

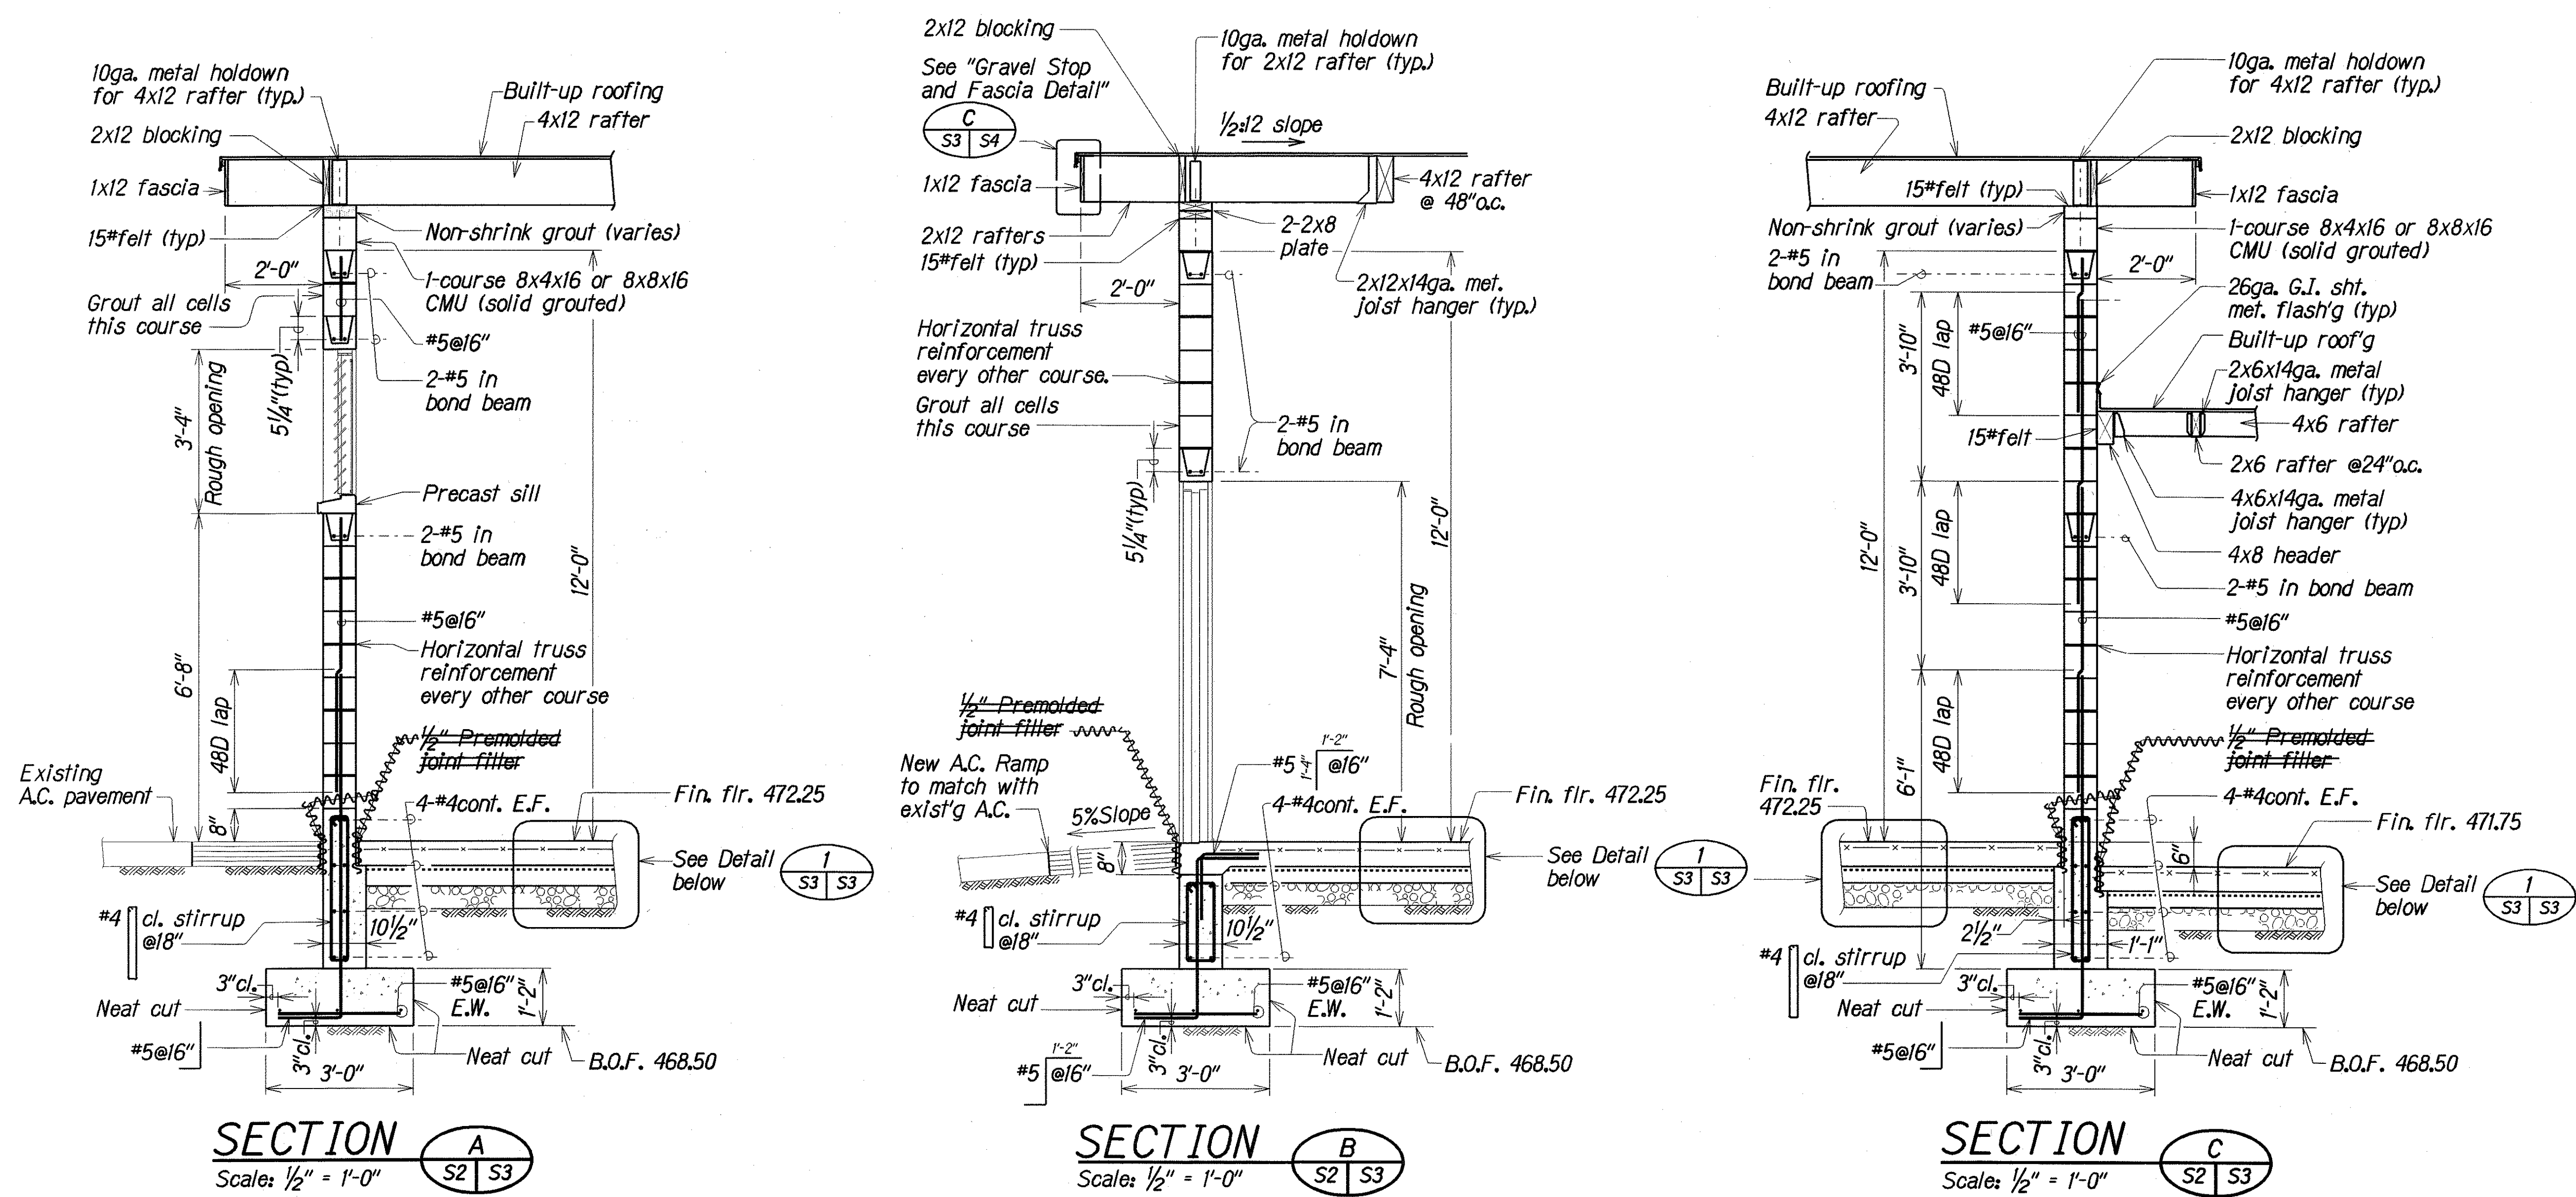

LIMITS OF STRUCTURE EXCAVATION AND BACKFILL
Not to Scale

LEGEND FOR AS-BUILT POSTINGS	
	Squiggly line for as-built deletion
	Double line for as-built deletion
Roadway	Text for as-built posting

STATE OF HAWAII
DEPARTMENT OF TRANSPORTATION
HIGHWAYS DIVISION

TYPICAL SECTIONS AND LIMITS OF STRUCTURAL EXCAVATION AND BACKFILL
MATERIAL TESTING LAB,
CONSTRUCT HAZARDOUS WASTE STORAGE SHED
Project No. HWY-0-09-91
Scale: As Noted

Date: Mar, 1997
SHEET No. S3 OF 6 SHEETS

ORIGINAL PLAN	DATE	DESIGNED BY	CHECKED BY
	MAR 1997	KSG	JFU
NOTE BOOK			
QUANTITIES BY			
CHECKED BY			

"AS-BUILT"