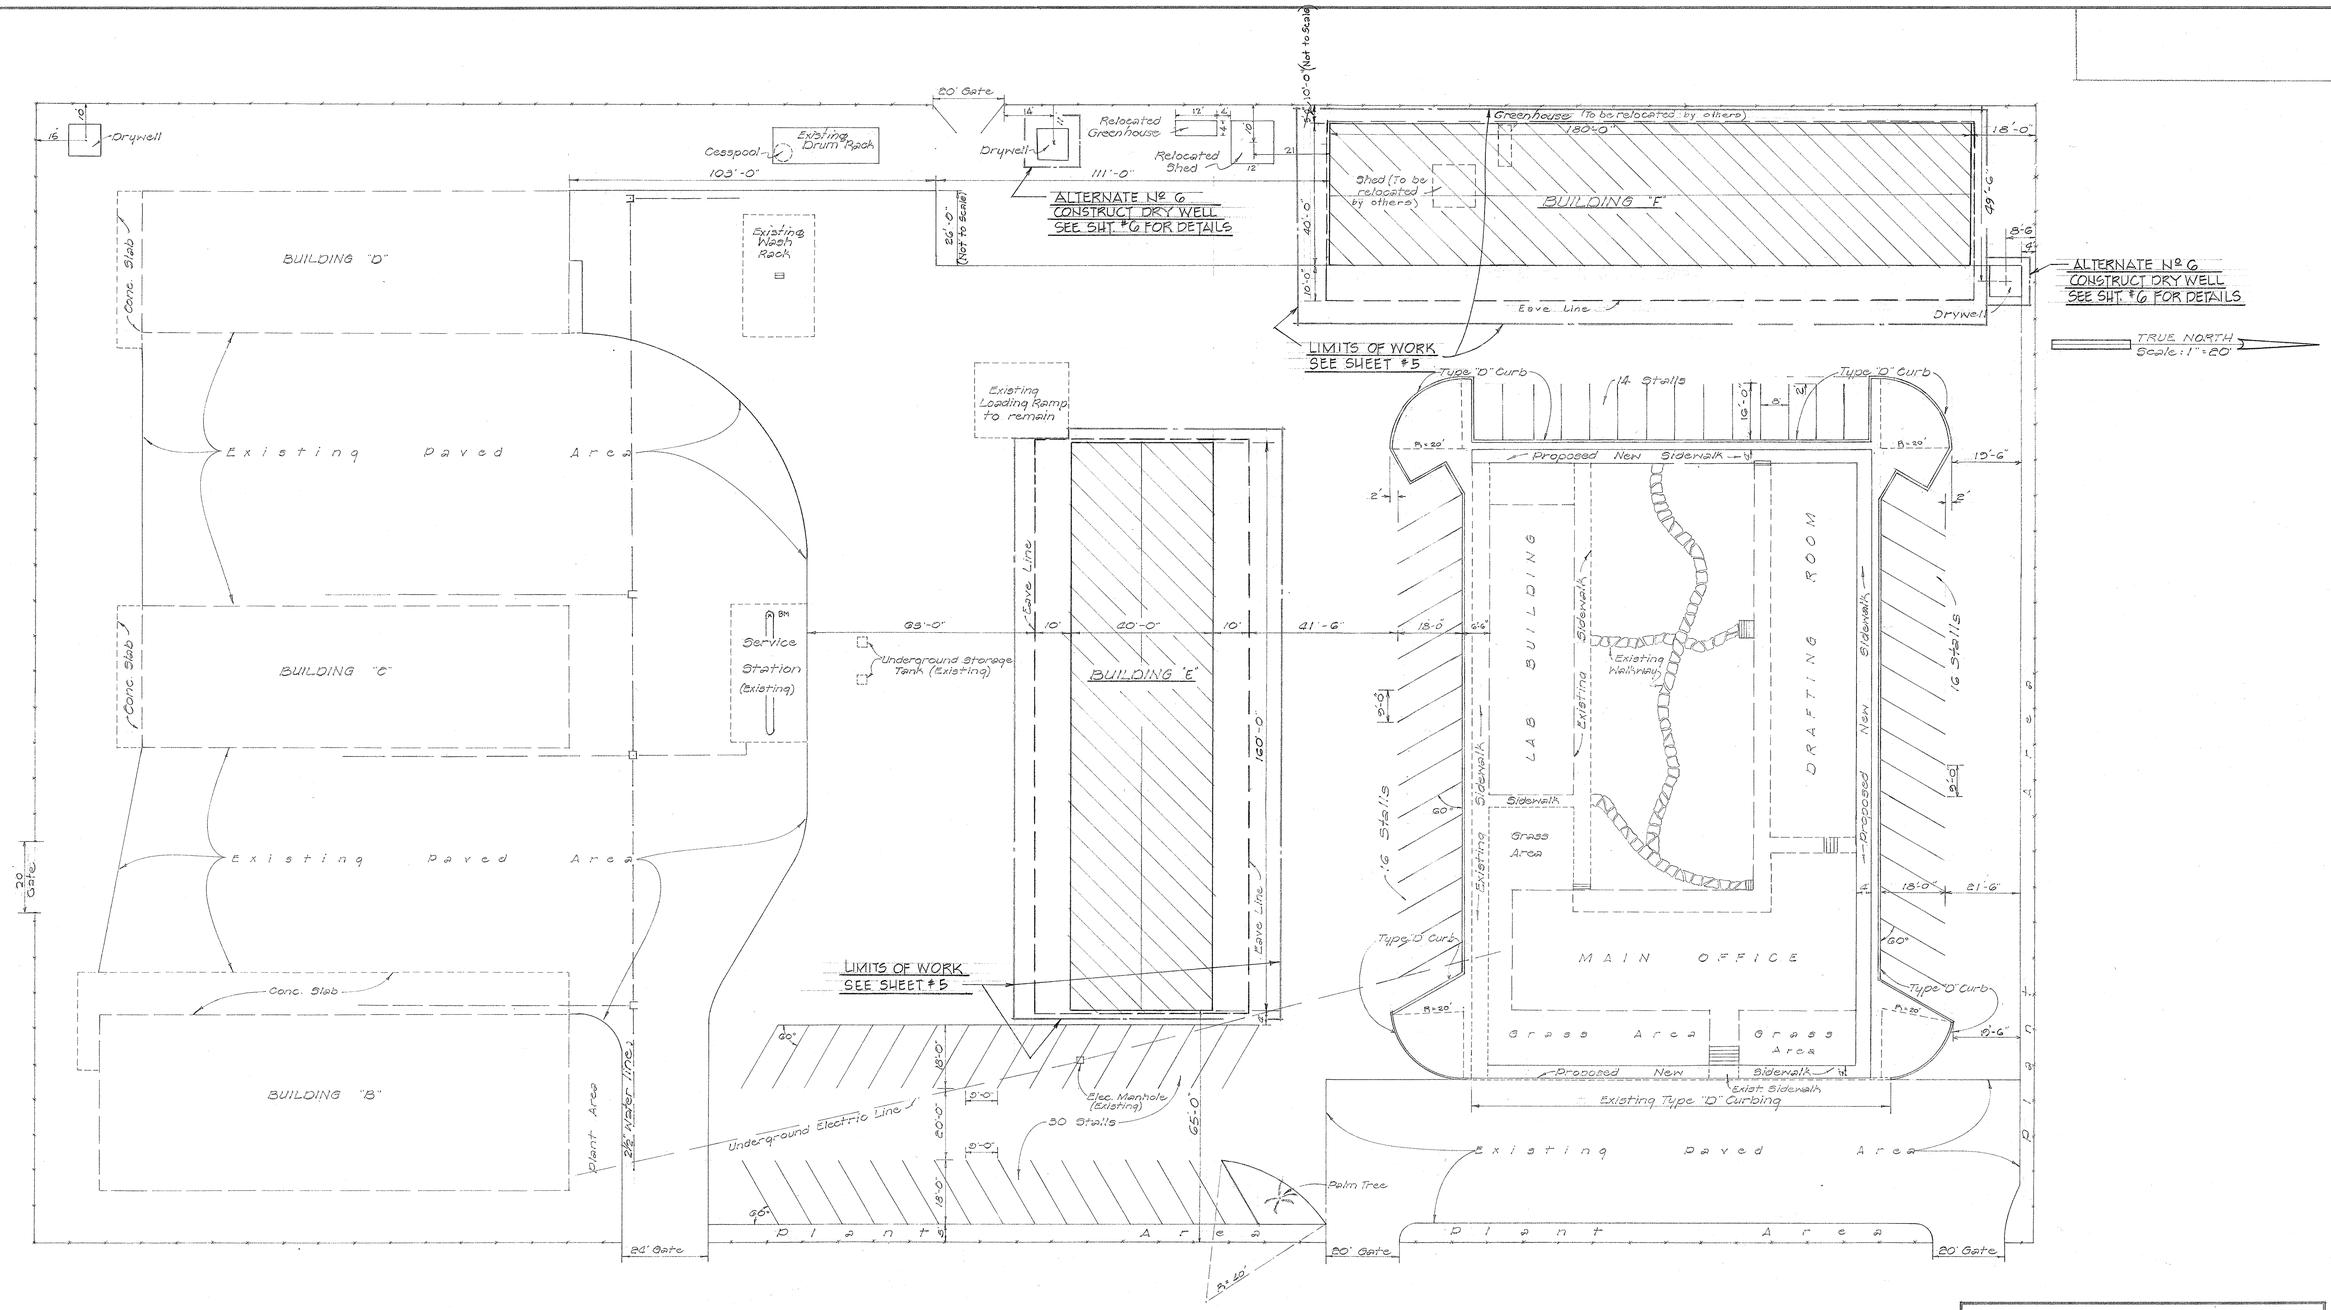

PLOT PLAN

SCALE: 1" = 20'-0"

NOTE!

1. ALL DETAILS SHOWN OUTSIDE OF LIMITS OF WORK EXCEPT FOR DRY WELL CONSTRUCTION, ARE NOT INCLUDED IN THIS CONTRACT.
2. CONCRETE FOR FOOTINGS SHALL BE CLASS A-1 CONCRETE.

DEPARTMENT OF TRANSPORTATION
HIGHWAYS DIVISION
STATE OF HAWAII

HILO BASEYARD

BUILDINGS "E" & "F"

PLOT PLAN

PROJ. No. SD 65-353 DATE: NOV., 1966

SHEET No. 2 OF 7 SHEETS