FED. ROAD DIST. NO.	STATE	PROJ. NO.	FISCAL YEAR	SHEET NO.	TOTAL SHEETS
HAWAII	HAW.	HNY-H-02-92M	1992	C.C.O. 6A	11

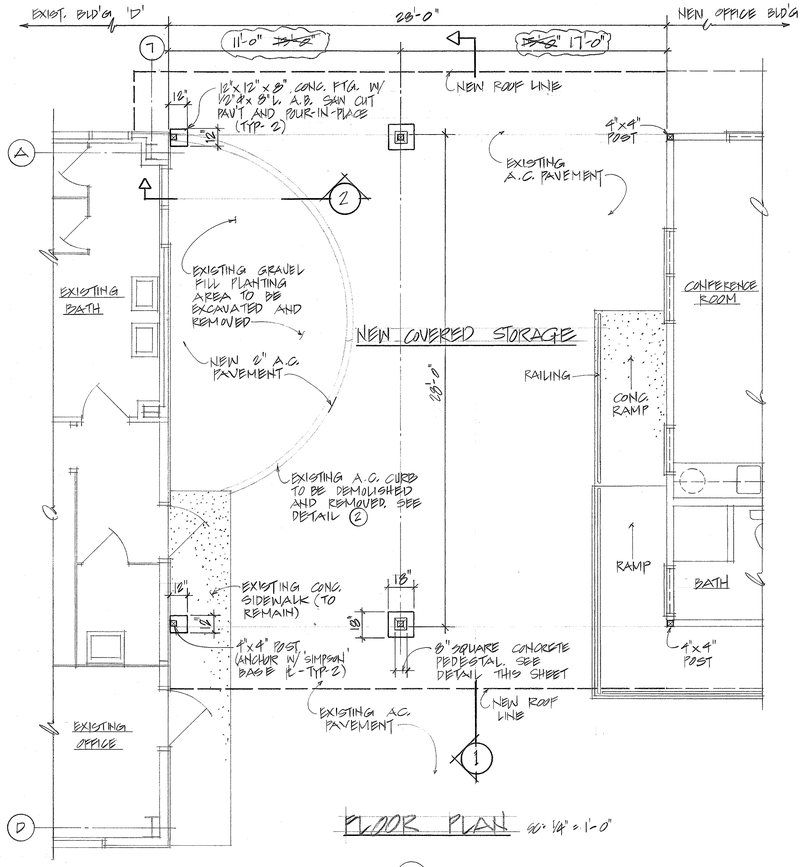

FLOOR PLAN SC: 1/4" = 1'-0"

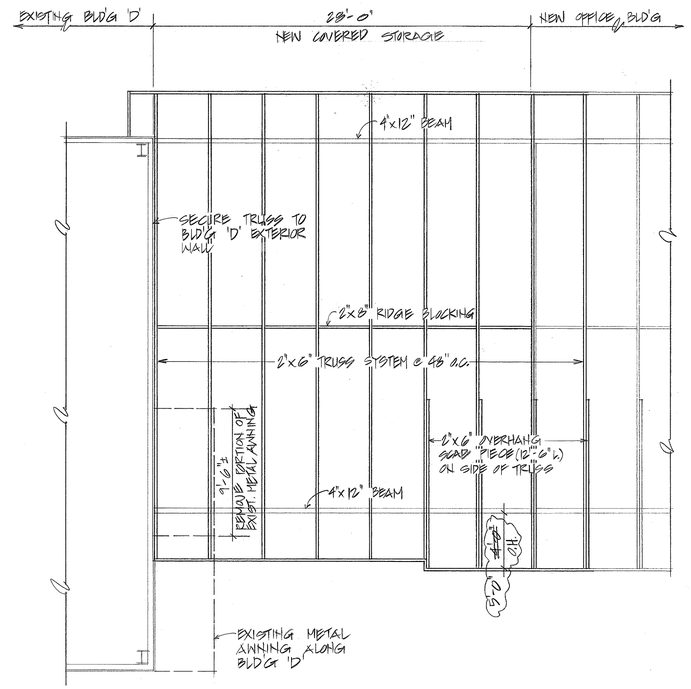

ROOF FRAMING PLAN SC: 3/16" = 1'-0"

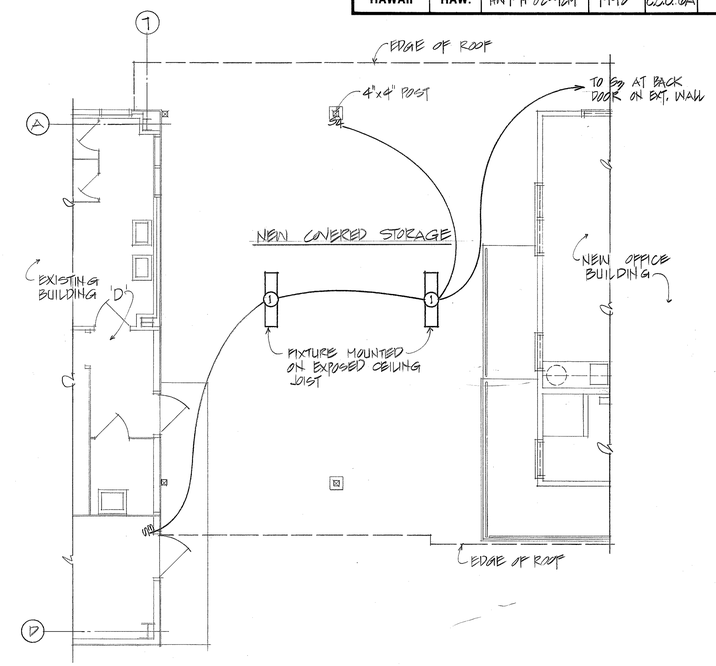

ELECTRICAL FLOOR PLAN SC: 3/16" = 1'-0"

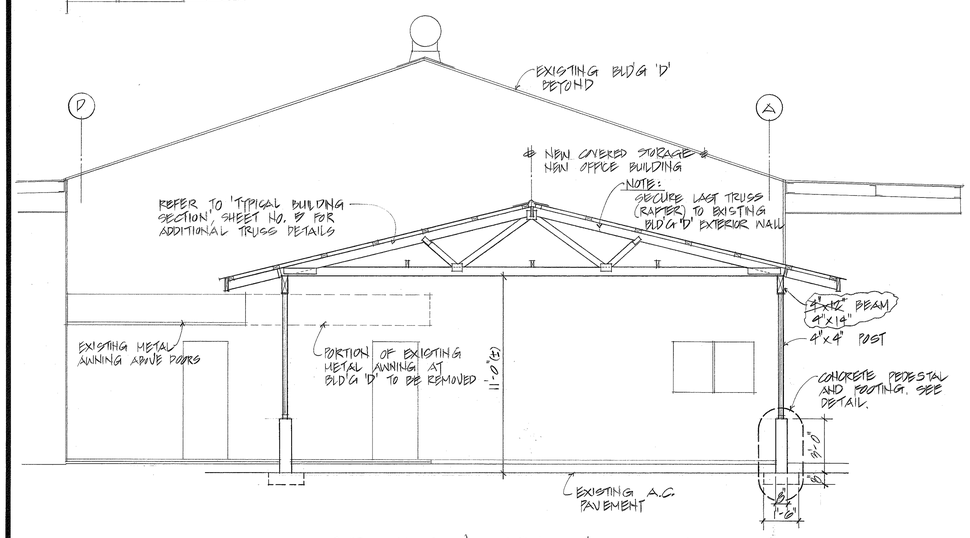

TYP. SECTION THRU COVERED STORAGE SC: 1/4" = 1'-0"

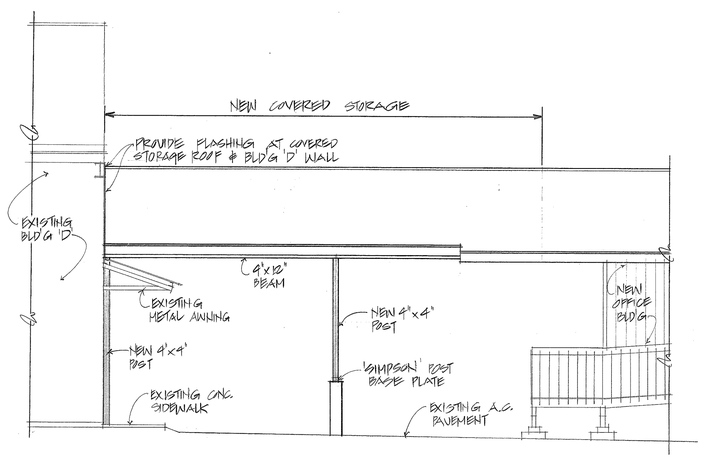

FRONT ELEVATION SC: 1/4" = 1'-0"

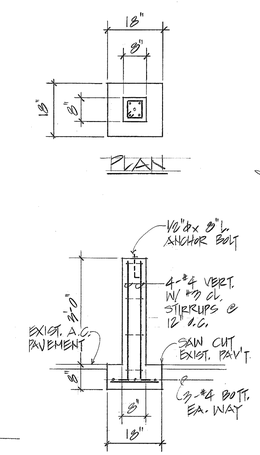

PEDESTAL/PTG DETAIL SC: 1/2" = 1'-0"

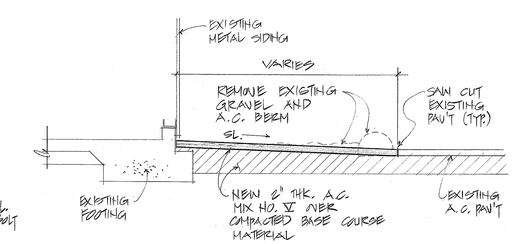

DETAIL 2 SC: 1/2" = 1'-0"

STATE OF HAWAII
DEPARTMENT OF TRANSPORTATION
HIGHWAYS DIVISION

C.C.O. #1

NEW COVERED STORAGE AREA
PLANS AND DETAILS

HILO BACKYARD BUILDING 'D'
OFFICE RENOVATION
PROJ. NO. HNY-H-02-92M

SCALE: AS NOTED DATE: SEPT. 1992

SHEET No. 1 OF 1 SHEETS

ORIGINAL PLAN		
	SURVEY PLOTTED BY	DATE
	DRAWN BY	
	TRACED BY	
NOTE BOOK	DESIGNED BY	
No.	QUANTITIES BY	
	CHECKED BY	

"AS-BUILT"

C.C.O. 6A