FED. ROAD DIST. NO.	STATE	PROJ. NO.	FISCAL YEAR	SHEET NO.	TOTAL SHEETS
HAWAII	HAW.	HWY-H-02-93M	1993	1	6

INDEX TO DRAWINGS

SHEET NO.	DESCRIPTION
1	TITLE SHEET
2	GENERAL NOTES AND SITE PLAN
3	TYPICAL SECTION, ROOF PLAN AND DETAILS
4 – 6	BUILDING "E" AND "F" INFORMATION

STATE OF HAWAII

DEPARTMENT OF TRANSPORTATION

HIGHWAYS DIVISION

"AS-BUILT"

PLANS FOR

BASEYARD IMPROVEMENTS OF MAINTENANCE BUILDINGS

HILO BASEYARD

PROJECT NO. HWY-H-02-93M

DISTRICT OF SOUTH HILO
ISLAND OF HAWAII

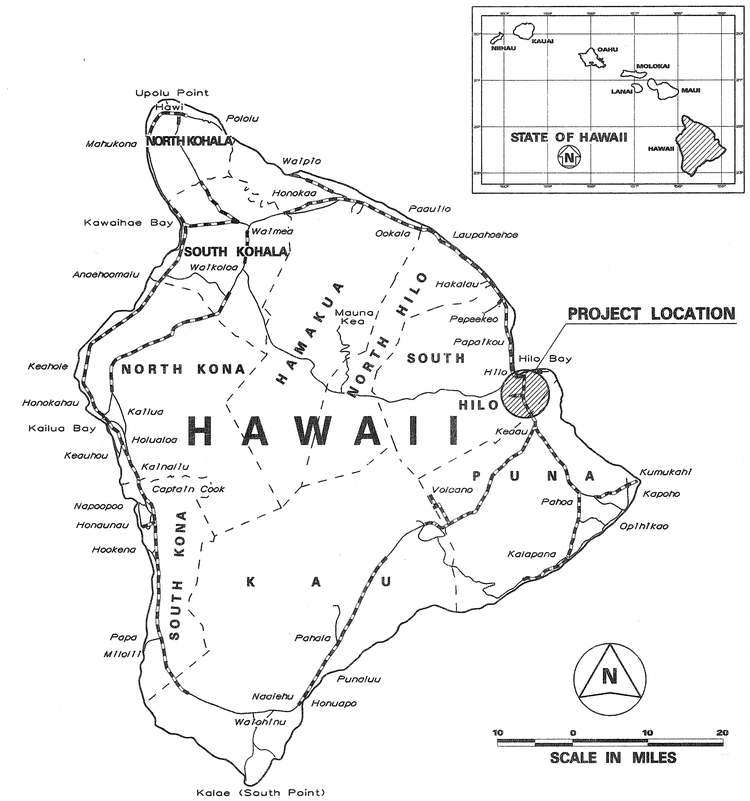

FEDERAL AID PROJECTS PREVIOUSLY CONSTRUCTED OR UNDER CONSTRUCTION

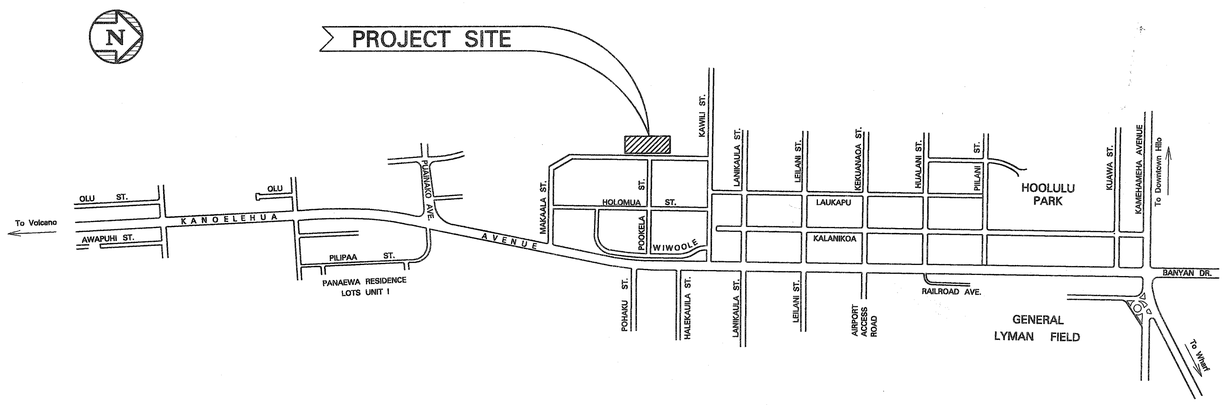

GENERAL LOCATION MAP

1 0 1 2
SCALE IN THOUSAND FEET

CHANGES MADE DURING CONSTRUCTION HAVE BEEN INCORPORATED ON THESE PLANS EXCEPT CHANGES IN THE ORIGINAL THEORETICAL QUANTITIES, REFER TO PROJECT LEGER AND/OR COMPUTATION BOOK FOR ACTUAL QUANTITIES.

Salvador Tanen — PROJECT ENGINEER

2/26/96 — DATE

DEPARTMENT OF TRANSPORTATION
STATE OF HAWAII

APPROVED:

T. Hirano — 5/12/93
For DIR. OF TRANSPORTATION — DATE

HAWAII DISTRICT — DESIGNED BY — JULIUS B. FRONDA — P. S. & E. BY — 587-2246 — PHONE — MAY, 1993 — DATE