| FED. ROAD DIST. NO. | STATE | PROJ. NO. | FISCAL YEAR | SHEET NO. | TOTAL SHEETS |
|---|---|---|---|---|---|
| HAWAII | HAW. | HWY-H-04-94M | 1994 | 1 | 8 |

| INDEX TO DRAWINGS | |
|---|---|
| SHEET NO. | DESCRIPTION |
| 1 | TITLE SHEET |
| 2 | STANDARD PLANS SUMMARY |
| 3 | GENERAL NOTES |
| 4 | REMOVAL/REPLACEMENT, RELOCATION AND GRADING PLAN |
| 5 | REMOVAL PLAN, NORTH KONA BASEYARD |
| 6 | INSTALLATION PLAN, NORTH KONA BASEYARD |
| 7 | CONCRETE SLAB DETAILS |
| 8 | SAFETY AND WARNING SIGNS |

STATE OF HAWAII

# DEPARTMENT OF TRANSPORTATION

## HIGHWAYS DIVISION

HONOLULU, HAWAII

"AS-BUILT"

PLANS FOR

# REMOVE AND REPLACE FUEL DISPENSING SYSTEM

## NORTH KONA BASEYARD

## PROJECT NO. HWY-H-04-94M

DISTRICT OF NORTH KONA
ISLAND OF HAWAII

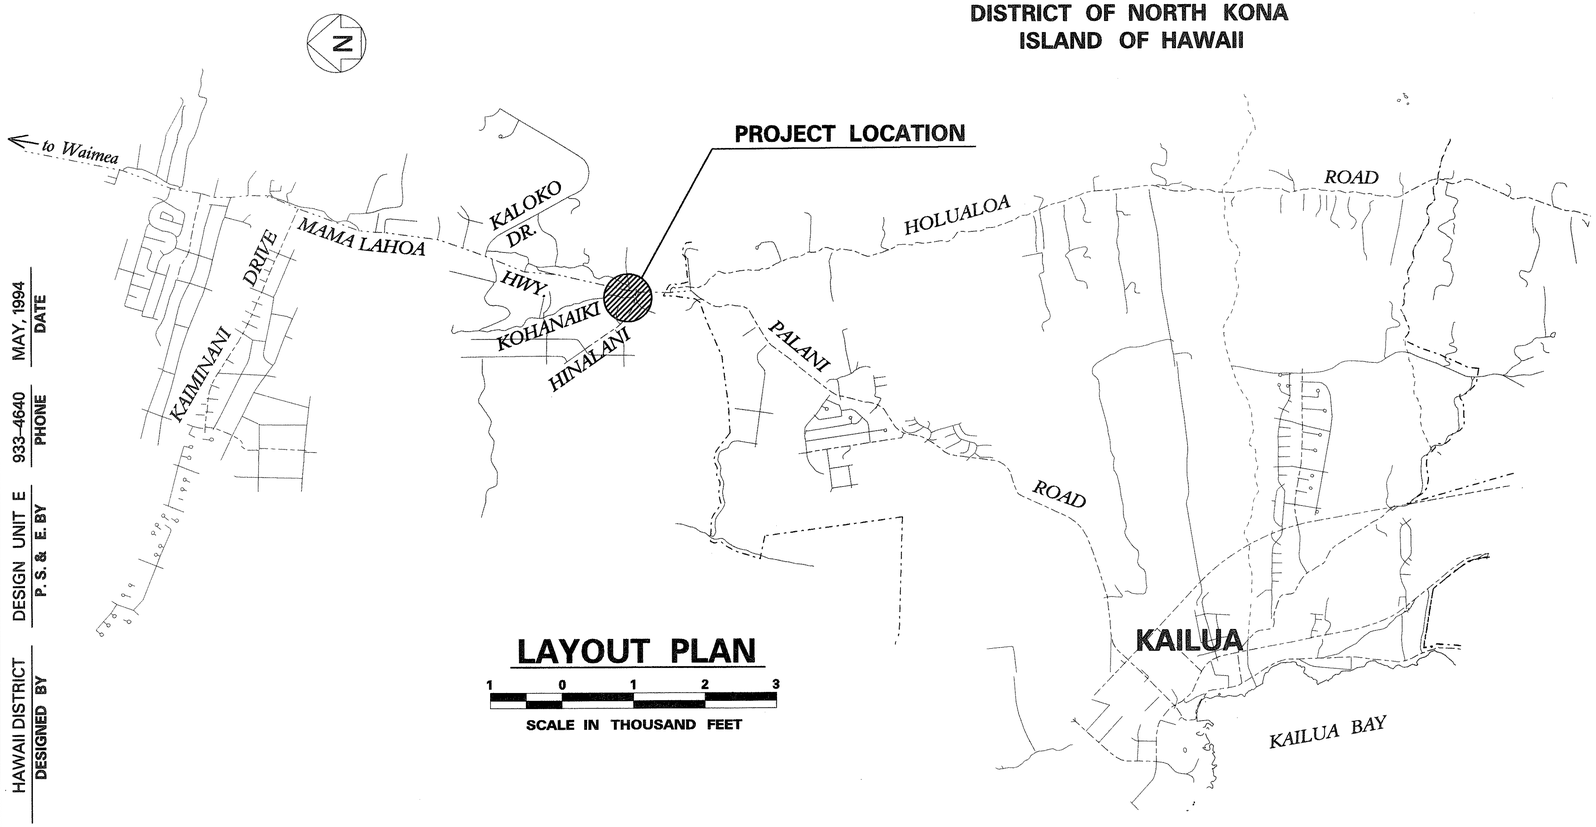


LAYOUT PLAN

1 0 1 2 3

SCALE IN THOUSAND FEET

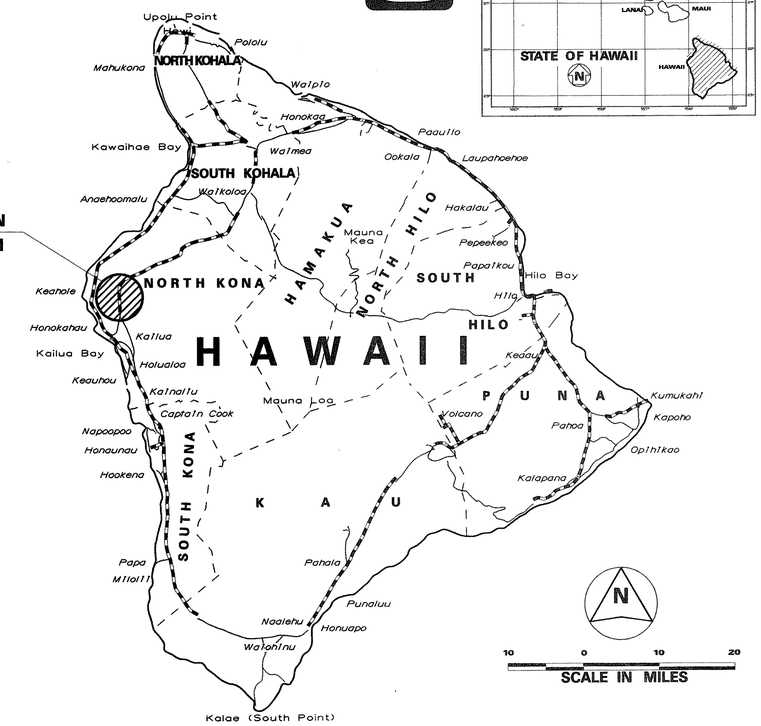


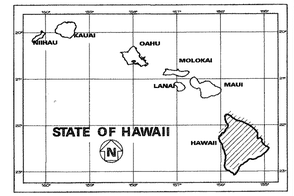


FEDERAL AID PROJECTS PREVIOUSLY CONSTRUCTED OR UNDER CONSTRUCTION

CHANGES MADE DURING CONSTRUCTION HAVE BEEN INCORPORATED ON THESE PLANS EXCEPT CHANGES IN THE ORIGINAL THEORETICAL QUANTITIES. FOR ACTUAL QUANTITIES, REFER TO PROJECT LEDGER AND/OR COMPUTATION BOOK.

Ray Shioji — RESIDENT ENGINEER — 6/7/96 DATE

DEPARTMENT OF TRANSPORTATION
STATE OF HAWAII
APPROVED:
[signature] — DIR. OF TRANSPORTATION — 5/23/94 DATE

HAWAII DISTRICT — DESIGNED BY
DESIGN UNIT E — P. S. & E. BY
933-4640 — PHONE
MAY, 1994 — DATE