FED. ROAD DIST. NO.	STATE	FED. AID PROJ. NO.	FISCAL YEAR	SHEET NO.	TOTAL SHEETS
HAWAII	HAW.	11M-01-71 19H-01-71 19B-01-71 19B-02-71	1971	2	7

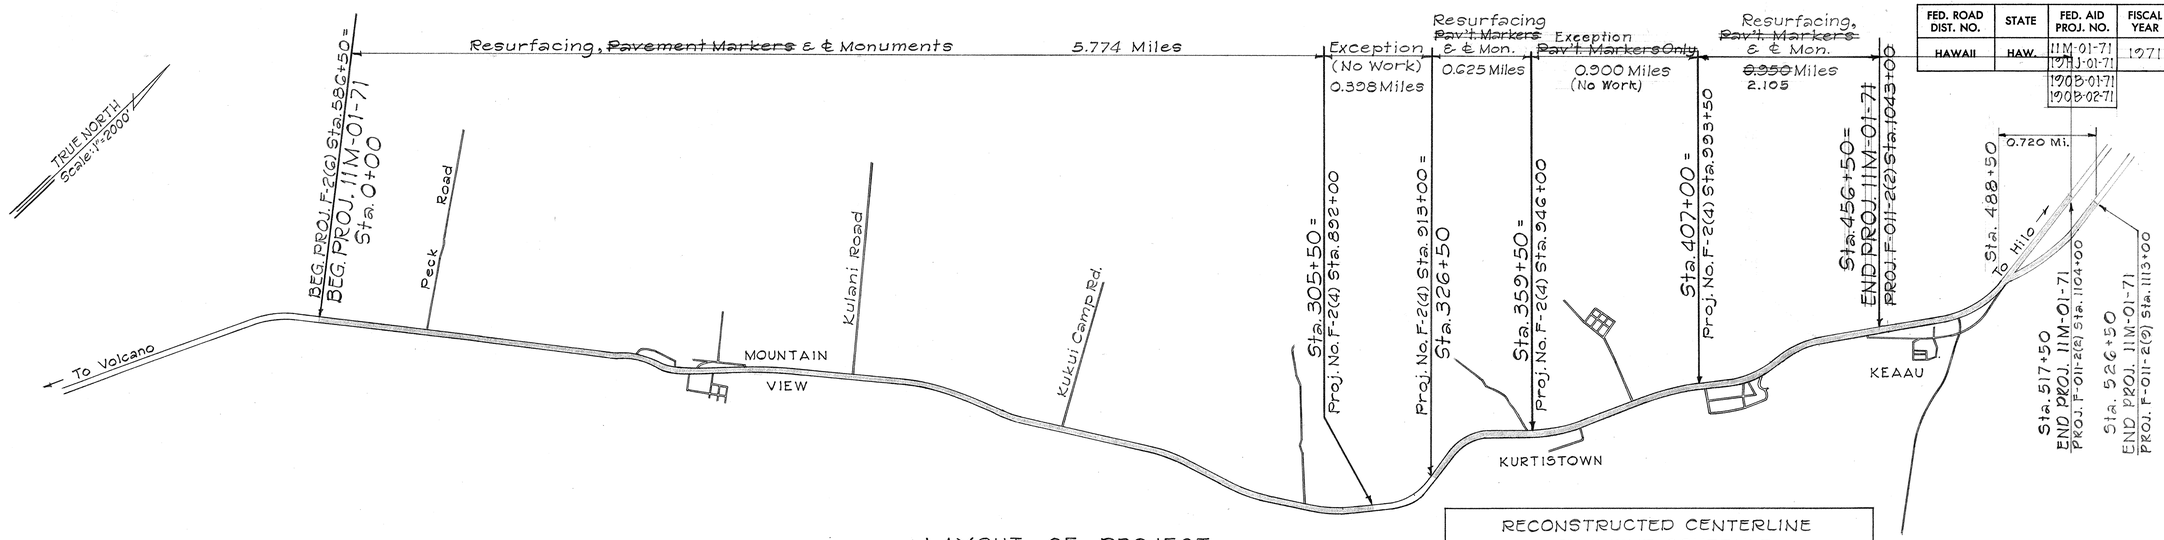

LAYOUT OF PROJECT

Scale : 1" = 2000'

Gross Length = ~~8.647 mi.~~ 10.522 mi.

Less Exception = 0.398 " 1.298

Net Length = 8.249 mi. 9.224 mi.

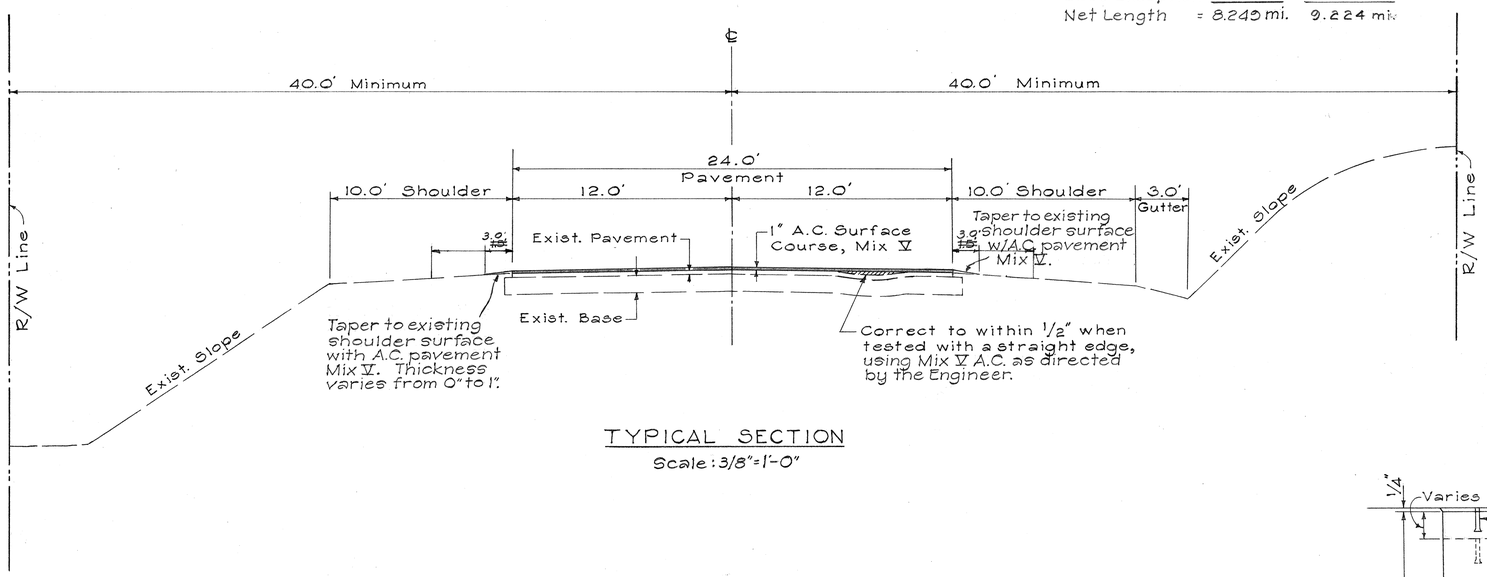

TYPICAL SECTION

Scale: 3/8"=1'-0"

RECONSTRUCTED CENTERLINE MONUMENT SCHEDULE	
LOCATION	LOCATION
Proj. F-2(6)	P.C. Sta. 823+02.88
Sta. 586+50	P.T. Sta. 837+91.21
P.C. Sta. 626+26.09	P.T. Sta. 837+95.43
P.T. Sta. 631+87.76	P.C. Sta. 847+66.13
P.C. Sta. 660+78.56	P.T. Sta. 863+99.46
P.T. Sta. 663+28.56	P.T. Sta. 864+04.24
Proj. F-2(4)	P.C. Sta. 875+06.22
Sta. 669+00	P.T. Sta. 883+25.39
P.C. Sta. 675+49.03	T.S. Sta. 916+55.04
P.T. Sta. 681+48.47	S.T. Sta. 932+30.25
P.C. Sta. 683+64.20	P.C. Sta. 945+29.07
P.T. Sta. 691+83.65	P.C. Sta. 999+25.16
P.C. Sta. 709+61.75	P.T. Sta. 1014+28.49
P.T. Sta. 722+10.08	P.T. Sta. 1015+16.00
P.C. Sta. 752+24.16	P.C. Sta. 1018+93.95
P.T. Sta. 769+57.49	P.O.T. Sta. 740+00
P.T. Sta. 770+12.48	
P.C. Sta. 781+41.84	Proj. F-011-2(2)
P.T. Sta. 791+76.01	Sta. 1027+67.88
P.T. Sta. 791+77.40	POT Sta. 1038+00
	Sta. 1060+26.47
	P.O.C. Sta. 1067+22.73
Stationing based on Proj. F-2(6), F-2(4) & F-011-2(2) "As Built."	
	P.T. Sta. 1083+26.47
	P.C. Sta. 1093+58.07

GENERAL NOTES:

1. Existing pavement surface variable. Surface indicated here is not intended to represent any specific location.
2. Centerline and edge of pavement striping to be done by others.
3. ~~Pavement marker locations shall be furnished by the Engineer in the field.~~

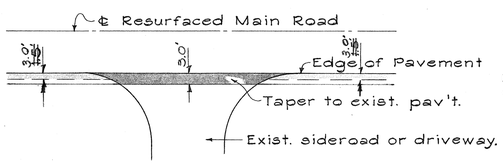

TYPICAL SIDEROAD & DRIVEWAY CONNECTION

(Not To Scale)

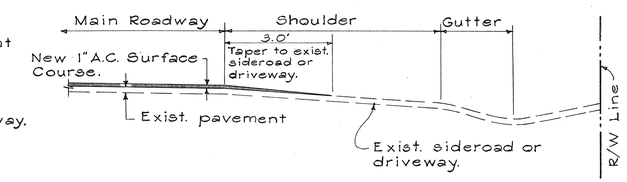

TYPICAL SECTION SIDEROAD & DRIVEWAY CONNECTION

(Not To Scale)

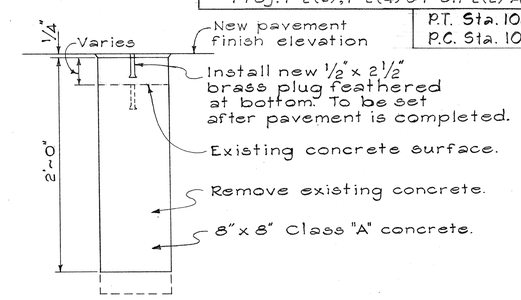

DETAIL FOR RECONSTRUCTED ℄ AND REFERENCE SURVEY MONUMENT

(Not To Scale)

STATE OF HAWAII
DEPARTMENT OF TRANSPORTATION
HIGHWAYS DIVISION

PLANS FOR RESURFACING & INSTALLATION OF PAVEMENT MARKERS

PROJECT NO. 11M-01-71

VOLCANO ROAD PUNA

Scale: As noted Date: Sept. 1970

SHEET No. 1 OF 1 SHEETS

ORIGINAL PLAN		DATE
	SURVEY PLOTTED BY	
	DRAWN BY	
	TRACED BY	
	DESIGNED BY	
NOTE BOOK	QUANTITIES BY	
No.	CHECKED BY	

PRINTED ON NO. 1000H CLEARPRINT