FED. ROAD DIST. NO.	STATE	PROJ. NO.	FISCAL YEAR	SHEET NO.	TOTAL SHEETS
HAWAII	HAW.	11GH-01-82M, 19H-02-82M	1982	1	6

INDEX TO DRAWINGS

SHEET NO.	DESCRIPTION
1	TITLE SHEET
2	GENERAL LOCATION PLAN, PROJ. NO. 11GH-01-82M
3	GENERAL LOCATION PLAN, PROJ. NO. 19H-02-82M
4	TYPICAL SECTIONS AND DETAILS
5-6	STANDARD DETAILS

STATE OF HAWAII

DEPARTMENT OF TRANSPORTATION

HIGHWAYS DIVISION

"AS BUILT"
PLANS FOR

HAWAII BELT ROAD RESURFACING

PIIKEA BRIDGE TO PUNALUU BRIDGE

PROJECT NO. 11GH-01-82M

DISTRICT OF KAU
ISLAND OF HAWAII

AND

HAWAII BELT ROAD RESURFACING

KILAU BRIDGE TO KAALUU BRIDGE

PROJECT NO. 19H-02-82M

DISTRICT OF NORTH HILO
ISLAND OF HAWAII

Contractor: Yamada and Sons, Inc.
Contract No.: 14580

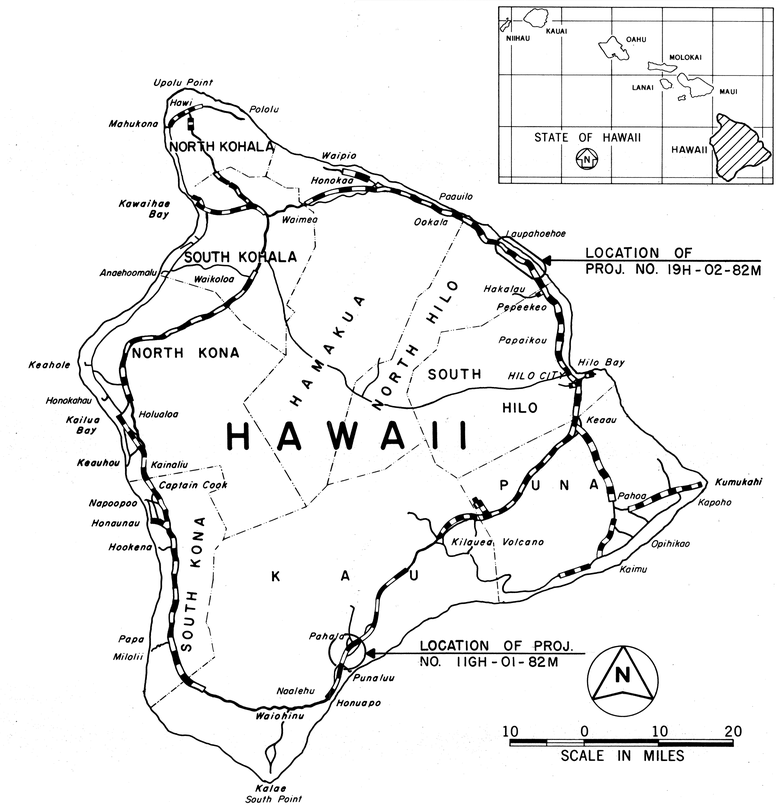

FEDERAL AID PROJECTS PREVIOUSLY CONSTRUCTED OR UNDER CONSTRUCTION

ALL CHANGES MADE DURING CONSTRUCTION HAVE BEEN INCORPORATED ON THESE PLANS IN RED EXCEPT CHANGES IN THE ORIGINAL THEORETICAL QUANTITIES. FOR ACTUAL QUANTITIES, REFER TO PROJECT LEDGER AND/OR COMPUTATION BOOK.

Benge Kodani — RESIDENT ENGINEER — 5-23-83 DATE

HAWAII DISTRICT — DESIGNED BY
R. MIKAMI — P. S. & E. BY
548-7534 — PHONE
March, 1982 — DATE

DEPARTMENT OF TRANSPORTATION
STATE OF HAWAII
APPROVED:
James K. Carras — 4/14/82
for DIR. OF TRANSPORTATION — DATE

DD-D-1-4