FED. ROAD DIST. NO.	STATE	PROJ. NO.	FISCAL YEAR	SHEET NO.	TOTAL SHEETS
HAWAII	HAW.	19H-01-86M 19G-01-86M 190B-01-86M 11B-01-86M	1986	1	13

INDEX TO DRAWINGS

SHEET NO.	DESCRIPTION
1	TITLE SHEET
2-3	LOCATION PLAN, TYPICAL SECTION
	& DETAILS, ROADWAY & PAVEMENT
	STRIPING PLAN
	PROJ. NO. 19H-01-86M
4-5	GENERAL LOCATION PLAN &
	TYPICAL SECTIONS, PROJECT
	PLAN & STRIPING LAYOUT
	PROJ. NO. 19G-01-86M
6	PAVEMENT RECONSTRUCTION
	DETAILS & SCHEDULES
7	LOCATION PLAN, TYPICAL SECTION
	& DETAILS
	PROJ. NO. 190B-01-86M
8-9	GENERAL LOCATION PLAN
	PROJECT & STRIPING LAYOUT,
	& TYPICAL SECTIONS & DETAILS
	PROJ. NO. 11B-01-86M
10-13	STANDARD DETAILS

STATE OF HAWAII

DEPARTMENT OF TRANSPORTATION

HIGHWAYS DIVISION

"AS-BUILT"

PLANS FOR
CONSTRUCTION OF

HAWAII BELT ROAD RESURFACING

MAULUA GULCH

PROJECT NO. 19H-01-86M

DISTRICT OF NORTH HILO

CONTRACT No. 20958

CONTRACTOR: YAMADA AND SONS, INC.

HAWAII BELT ROAD RESURFACING

KEALAKAHA BRIDGE TOWARDS KUKAIAU

PROJECT NO. 19G-01-86M

DISTRICT OF HAMAKUA

CONTRACT No. 20957

CONTRACTOR: JAS. W. GLOVER, LTD.

HAWAII BELT ROAD RESURFACING

KONA HIGHLANDS TO PALANI ROAD

PROJECT NO. 190B-01-86M

DISTRICT OF NORTH KONA

CONTRACT No. 20956

CONTRACTOR: JAS. W. GLOVER, LTD.

HAWAII BELT ROAD RESURFACING

MACHADO STORE TO KONA THEATRE

PROJECT NO. 11B-01-86M

DISTRICT OF SOUTH KONA

CONTRACT No. 20955

CONTRACTOR: GRACE PACIFIC CORP.

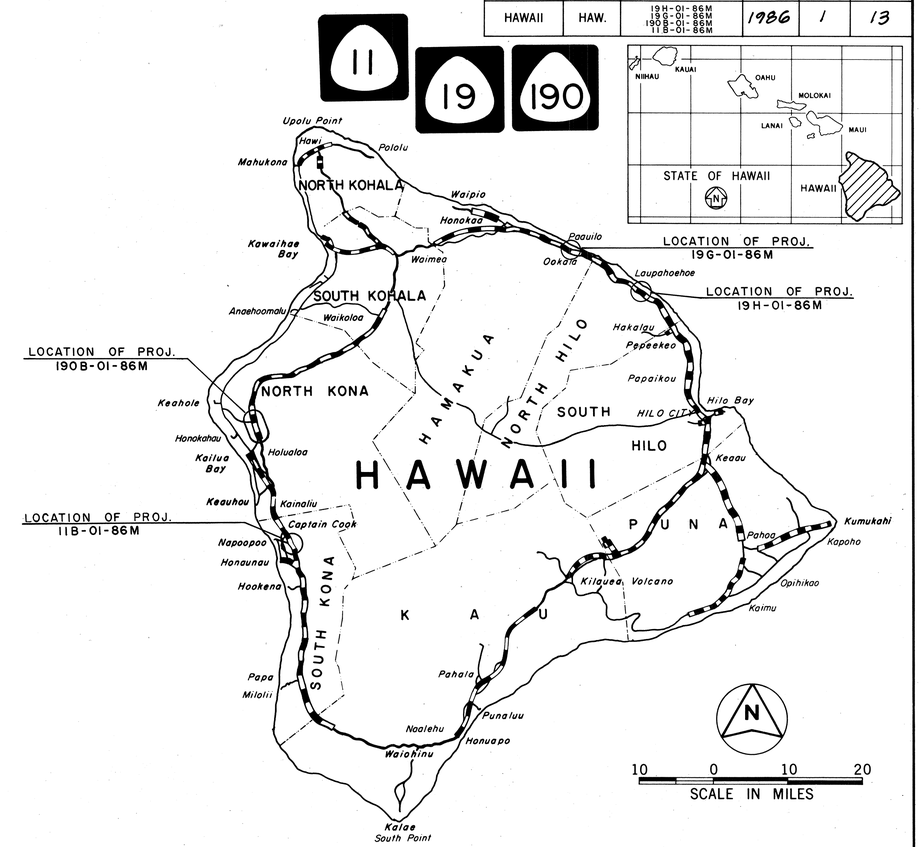

FEDERAL AID PROJECTS PREVIOUSLY CONSTRUCTED OR UNDER CONSTRUCTION

CHANGES MADE DURING CONSTRUCTION HAVE BEEN INCORPORATED ON THESE PLANS EXCEPT CHANGES IN THE ORIGINAL THEORETICAL QUANTITIES. FOR ACTUAL QUANTITIES, REFER TO PROJECT LEDGER AND/OR COMPUTATION BOOK.

RESIDENT ENGINEER — DATE 9-21-88

DEPARTMENT OF TRANSPORTATION
STATE OF HAWAII

APPROVED:

DIR. OF TRANSPORTATION — DATE 5/29/88

HAWAII DISTRICT — DESIGNED BY
JOSE PINIOL — P. S. & E. BY
548-7537 — PHONE
MAY, 1986 — DATE