FED. ROAD DIST. NO.	STATE	PROJ. NO.	FISCAL YEAR	SHEET NO.	TOTAL SHEETS
HAWAII	HAW.	11C-01-89 19J-01-89	1990	1	4

INDEX TO DRAWINGS

SHEET NO.	DESCRIPTION
1	TITLE SHEET
2	STANDARD PLANS SUMMARY
3	ROADWAY PLANS, TYPICAL SECTION, DETAILS & GENERAL NOTES FOR PROJECT NO. 11C-01-89
4	ROADWAY PLANS, TYPICAL SECTION, DETAILS & GENERAL NOTES FOR PROJECT NO. 19J-01-89

STATE OF HAWAII

DEPARTMENT OF TRANSPORTATION

HIGHWAYS DIVISION

"AS-BUILT"

PLANS FOR

HAWAII BELT ROAD

FLASHING WARNING LIGHTS AT HOOKENA SCHOOL

PROJECT NO. 11C-01-89

DISTRICT OF SOUTH KONA

ISLAND OF HAWAII

HAWAII BELT ROAD

FLASHING WARNING LIGHTS

VICINITY OF KALANIANAOLE SCHOOL

PROJECT NO. 19J-01-89

DISTRICT OF SOUTH HILO

ISLAND OF HAWAII

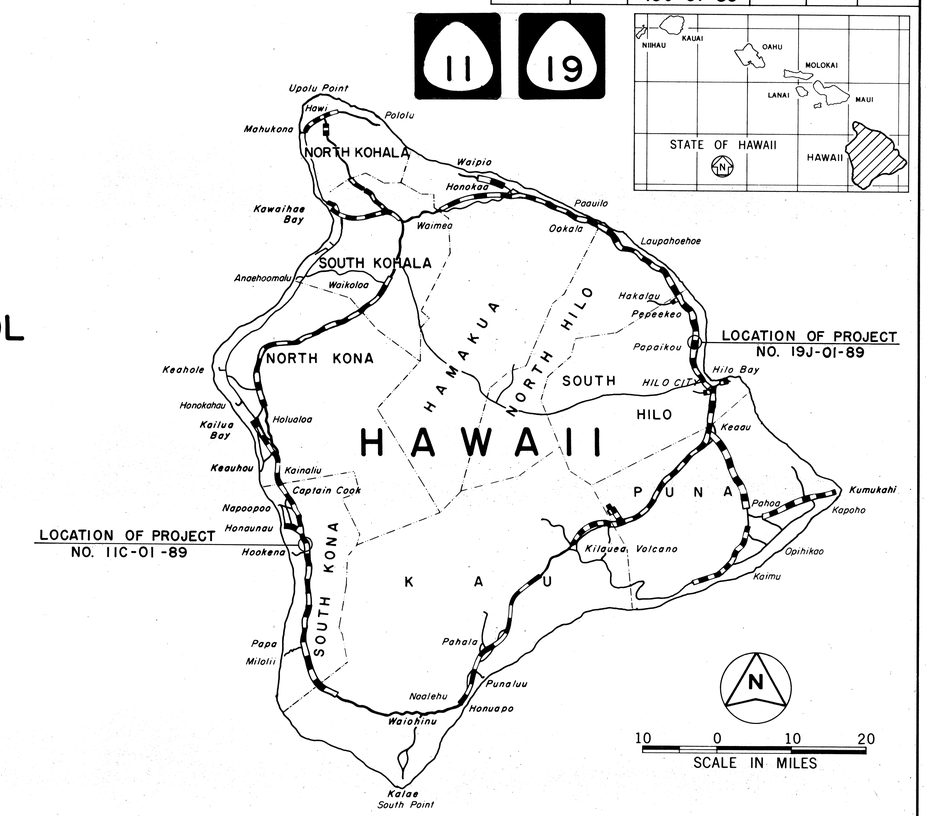

FEDERAL AID PROJECTS PREVIOUSLY CONSTRUCTED OR UNDER CONSTRUCTION

PROJECT NO. 11C-01-89
MILE POST 101.4 ± & 101.9 ±

PROJECT NO. 19J-01-89
MILE POST 7.2 ± & 7.4 ±

CHANGES MADE DURING CONSTRUCTION HAVE BEEN INCORPORATED ON THESE PLANS EXCEPT CHANGES IN THE ORIGINAL THEORETICAL QUANTITIES. FOR ACTUAL QUANTITIES, REFER TO PROJECT LEDGER AND/OR COMPUTATION BOOK.

RESIDENT ENGINEER — 5-13-91 DATE

DEPARTMENT OF TRANSPORTATION
STATE OF HAWAII

APPROVED:

DIR. OF TRANSPORTATION — 4/9/90 DATE

HAWAII DISTRICT — DESIGNED BY

A. YAMAGUCHI — P. S. & E. BY

548-7534 — PHONE

MARCH 1990 — DATE