INDEX TO DRAWINGS	
SHEET NO.	DESCRIPTION
1	TITLE SHEET
2	TYPICAL SECTIONS & DETAILS
3	GENERAL LAYOUT: 250A-01-75M 270B-01-75M
4 - 8	PLANS - Proj. No. 250A-01-75M
9	PLANS - Proj. No. 270B-01-75M

STATE OF HAWAII

DEPARTMENT OF TRANSPORTATION

HIGHWAYS DIVISION

PLANS FOR

RESURFACING AND REHABILITATION PROGRAM OF HIGHWAYS AT VARIOUS LOCATIONS ON THE ISLAND OF HAWAII

ROUTE 250

KOHALA MOUNTAIN ROAD
PROJ. NO. 250A-01-75M
DISTRICTS OF NORTH KOHALA
AND SOUTH KOHALA

ROUTE 270

NIULII - POLOLU VALLEY ROAD
PROJ. NO. 270B-01-75 M
DISTRICT OF NORTH KOHALA

FED. ROAD DIST. NO.	STATE	PROJ. NO.	FISCAL YEAR	SHEET NO.	TOTAL SHEETS
HAWAII	HAW.	250A-01-75M 270B-01-75M	1975	1	9

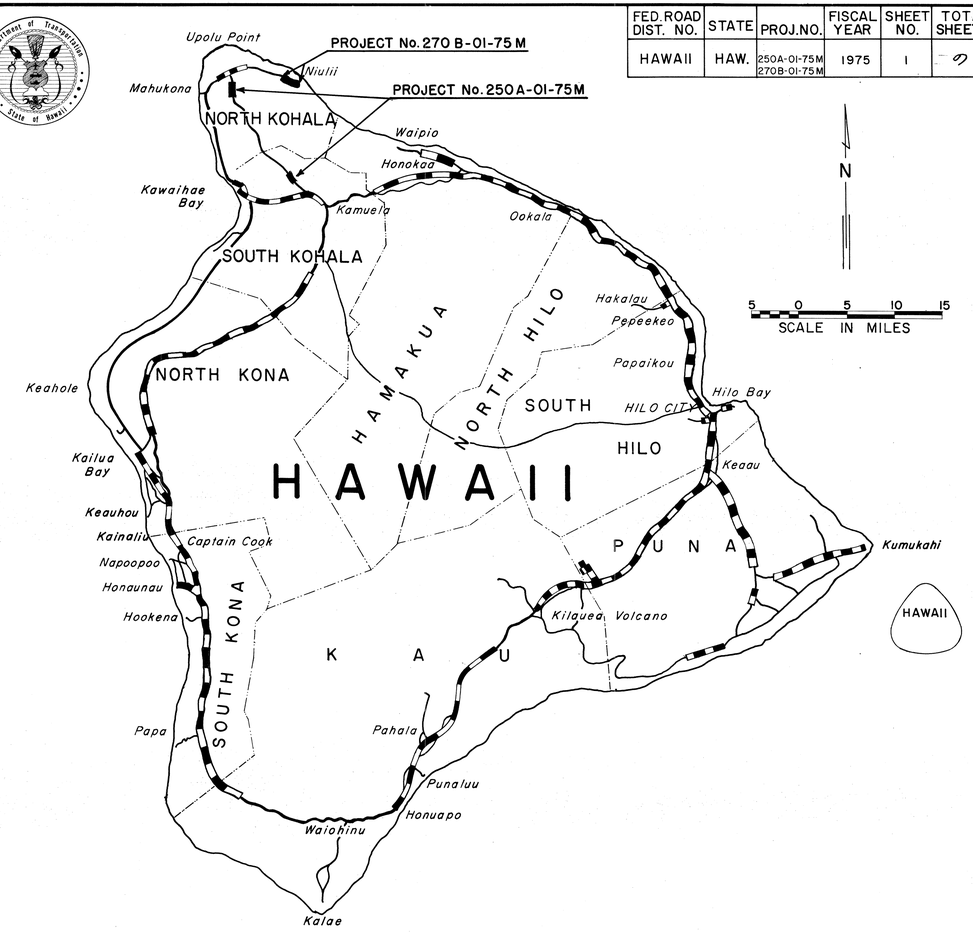

Federal Aid Projects Previously Constructed Or Under Construction

GENERAL LOCATIONS

NO AS-BUILT CHANGES MADE
DURING CONSTRUCTION.

10-9-80
PROJECT ENGINEER DATE

LENGTH OF PROJECT

PROJECT No. 250A-01-75M . . . . . 12.857 Miles (Gross)
7.058 Miles (Exception)
5.799 Miles (Net)
PROJECT No. 270B-01-75M . . . . . 1.595 Miles

DEPARTMENT OF TRANSPORTATION
STATE OF HAWAII
APPROVED:
Murray Lee 10/18/74
FOR DIR. OF TRANSPORTATION DATE

HAWAII DISTRICT
DESIGNED BY
R. Mikami
P. S. & E. BY
548-7534
PHONE
Oct. 1974
DATE