


STATE	PROJ. NO.	FISCAL YEAR	SHEET NO.	TOTAL SHEETS
HAW.	BMD 66-343	FY 71-72	41	88

FINAL	SURVEYED	DATE
SURVEY	PLOTTED	BY
NOTE BOOK	AREA CHECKED	
NO.		

ORIGINAL	SURVEYED	DATE
SURVEY	PLOTTED	BY
NOTE BOOK	AREA CHECKED	
NO.		

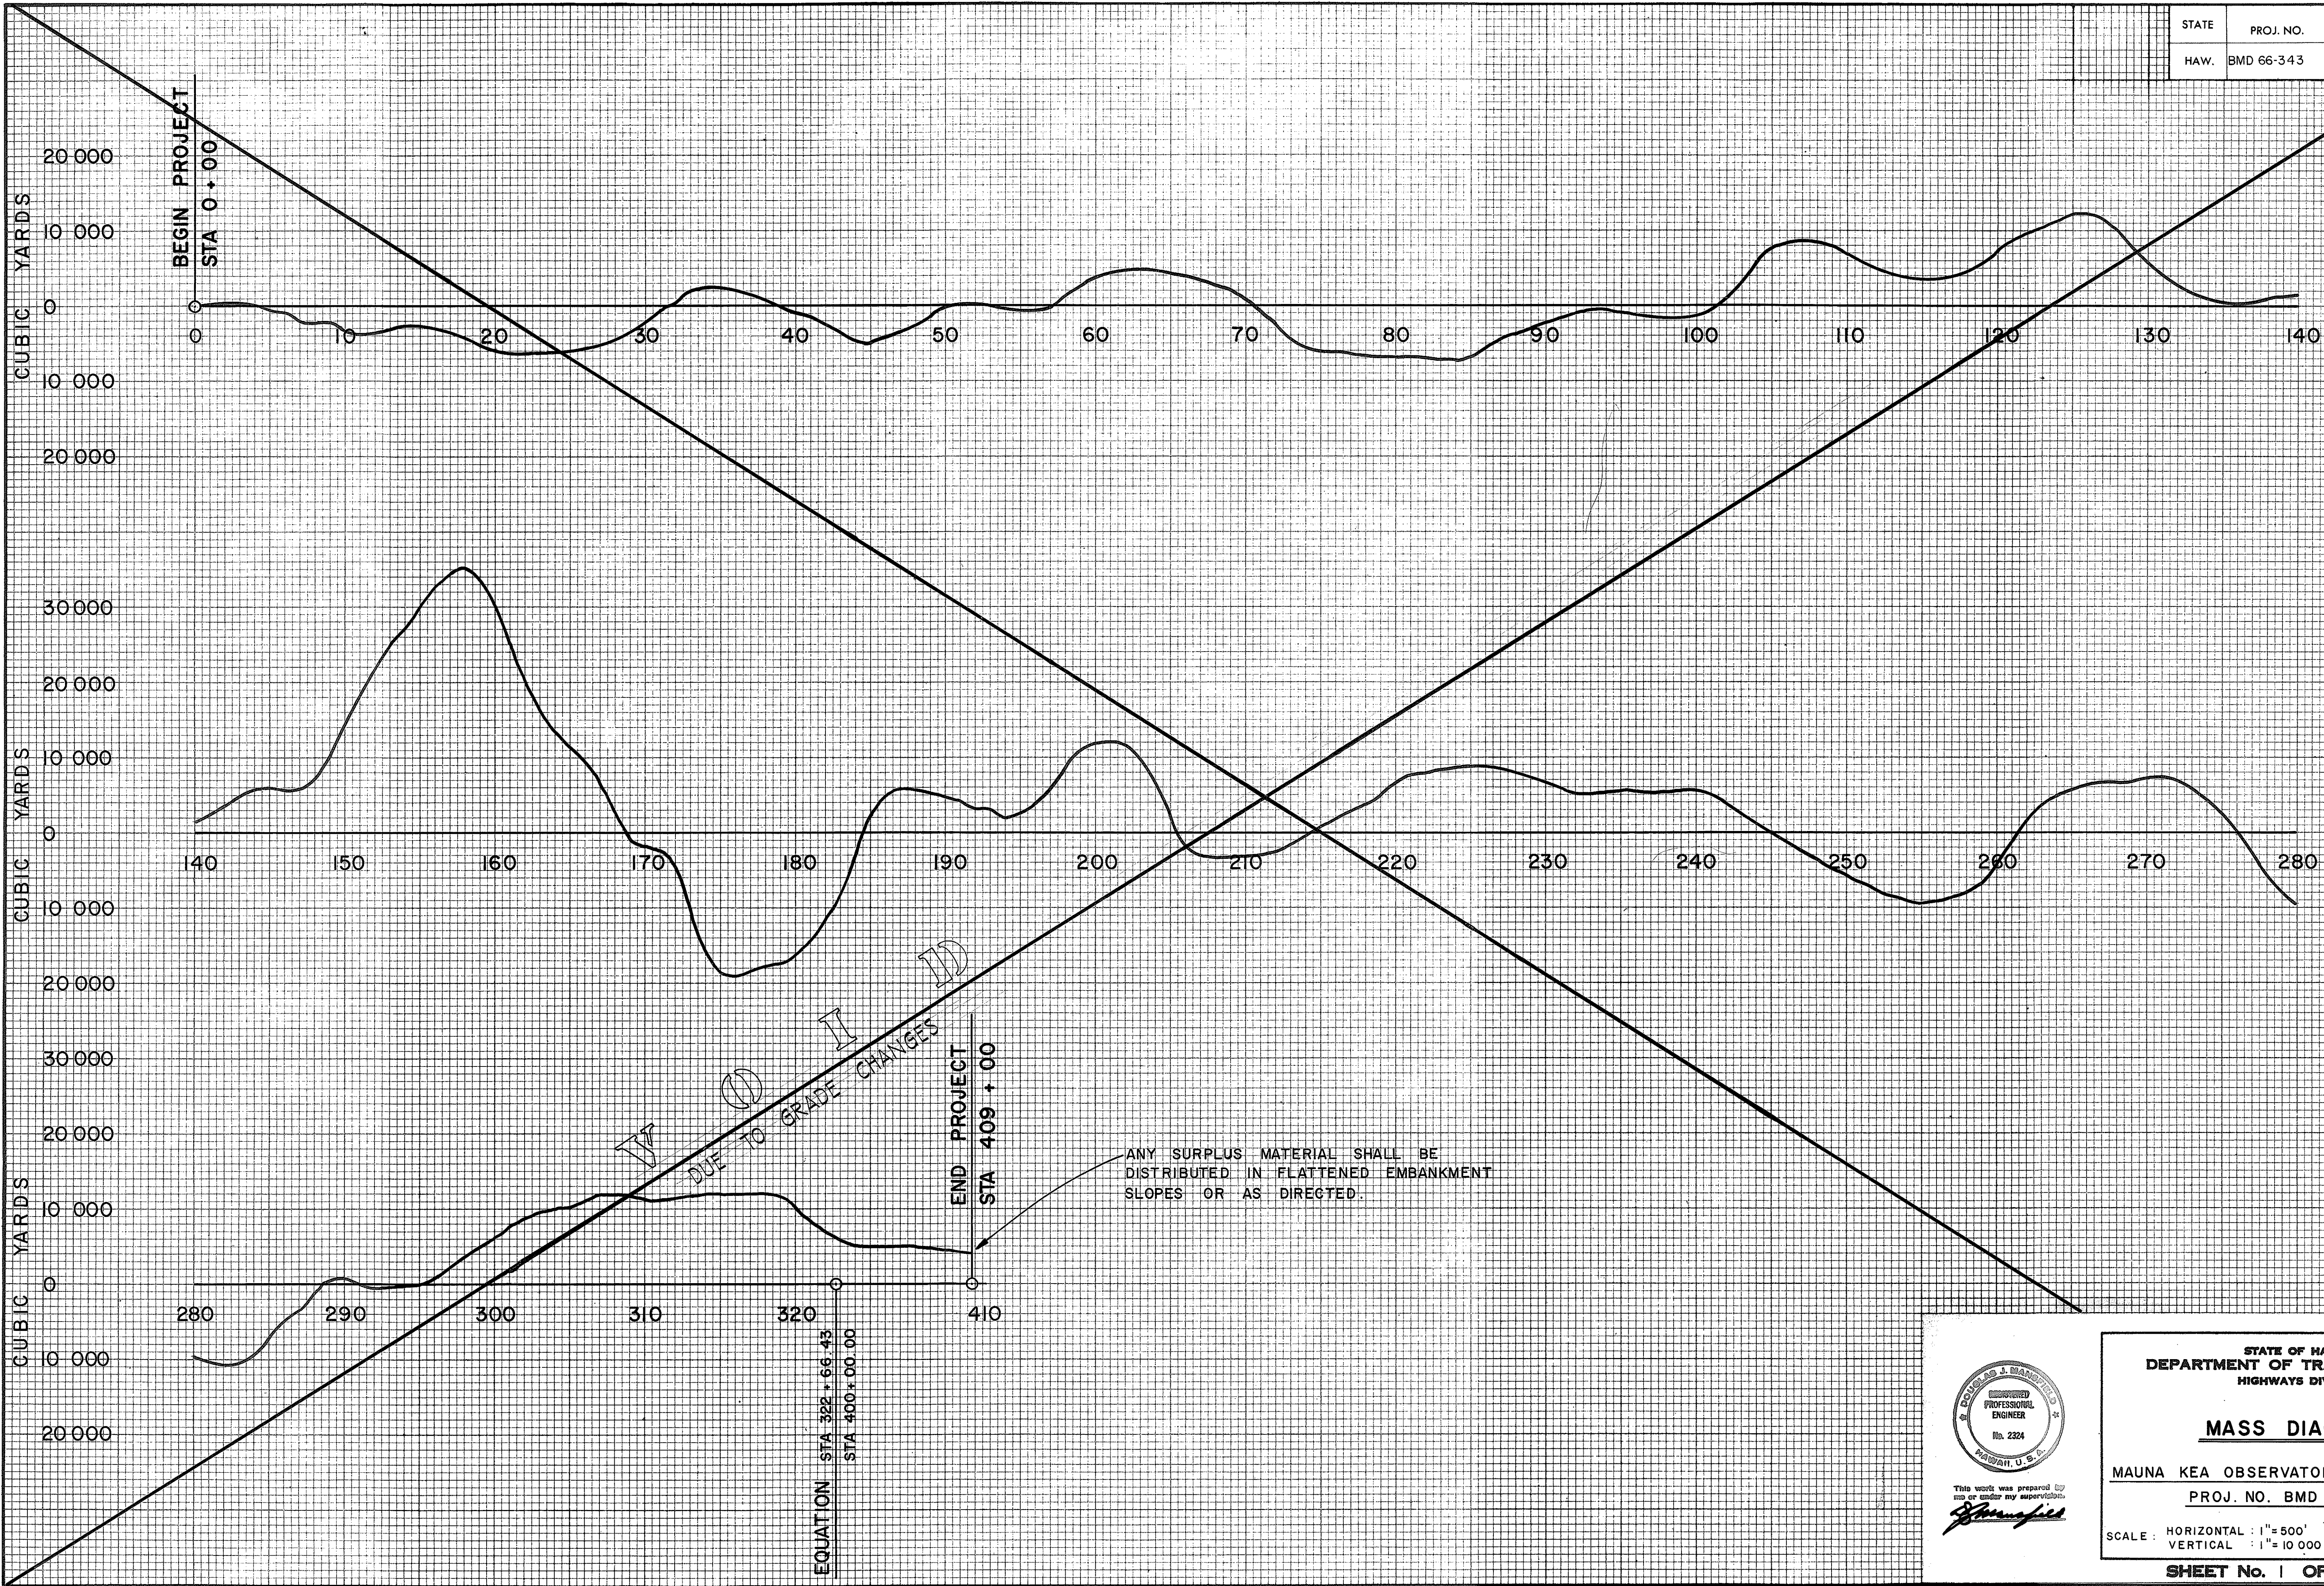

This work was prepared by me or under my supervision.

STATE OF HAWAII
DEPARTMENT OF TRANSPORTATION
HIGHWAYS DIVISION

MASS DIAGRAM

MAUNA KEA OBSERVATORY ACCESS ROAD
PROJ. NO. BMD 66 - 343

SCALE: HORIZONTAL: 1"=500'
VERTICAL: 1"=10,000 CY DATE: MARCH 1972