FED. ROAD DIST. NO.	STATE	FED. AID PROJ. NO.	FISCAL YEAR	SHEET NO.	TOTAL SHEETS
HAWAII	HAW.	ER 8(1)	1961	1	21

SHEET	INDEX TO DRAWINGS DESCRIPTION	COMPOSITE SHEET NO.
1.01	TITLE SHEET	1
1.02	TYPICAL SECTION	3
1.03-1.07	PLAN & PROFILE	4-8
1.08-1.09	STANDARD DETAILS	10-11
1.10-1.21	CROSS SECTIONS	12-23

STATE OF HAWAII
DEPARTMENT OF TRANSPORTATION
DIVISION OF HIGHWAYS
AS-BUILT
PLANS OF

KAPOHO - KUMUKAHI LIGHTHOUSE ROAD

(END PROJECT S-0132(1) TO KUMUKAHI LIGHTHOUSE)

EMERGENCY RELIEF PROJECT NO. ER 8(1)

DISTRICT OF PUNA
ISLAND OF HAWAII

SCALES

PLAN ..... 1 INCH = 100 FT.
PROFILE ..... HOR. 1 INCH = 100 FT.
VER. 1 INCH = 10 FT.
CROSS SECTION ..... HOR. 1 INCH = 10 FT.
VER. 1 INCH = 10 FT.

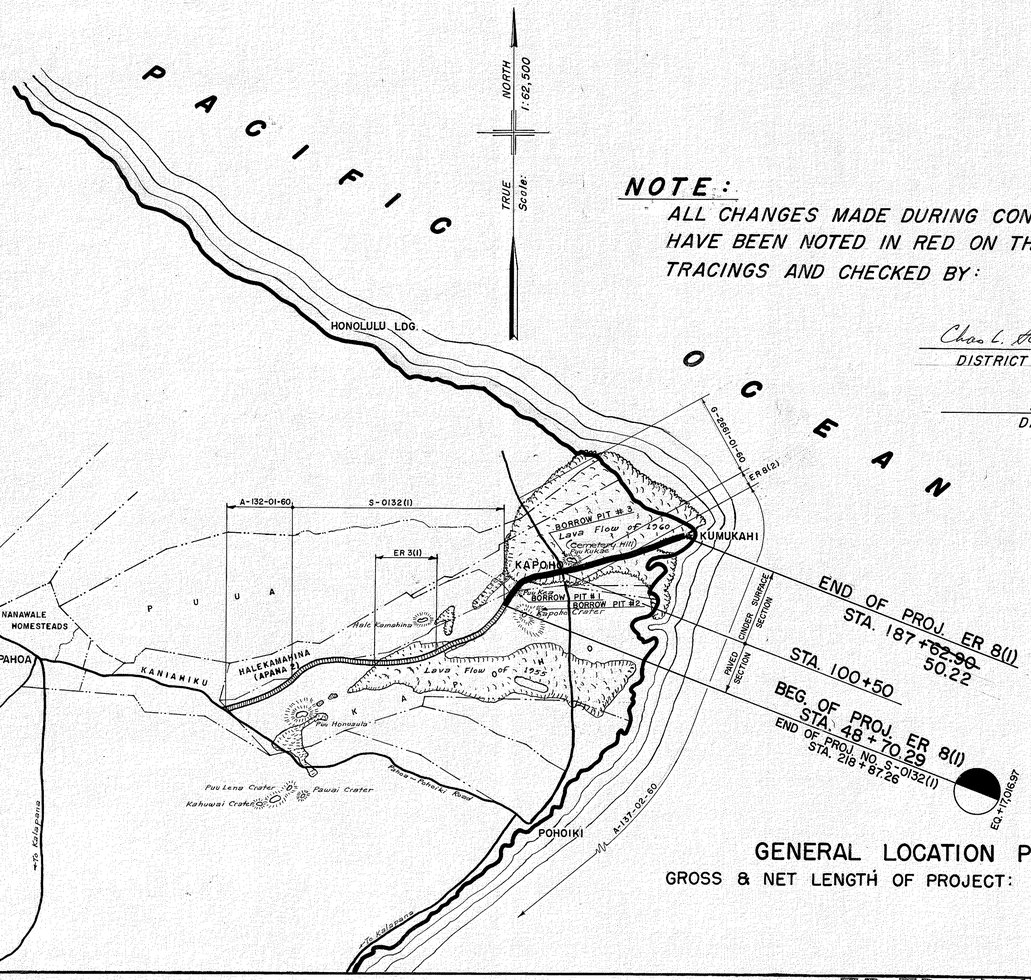

NOTE:
ALL CHANGES MADE DURING CONSTRUCTION HAVE BEEN NOTED IN RED ON THESE TRACINGS AND CHECKED BY:

Chas. L. Schulter
DISTRICT ENGINEER

8/22/62
DATE

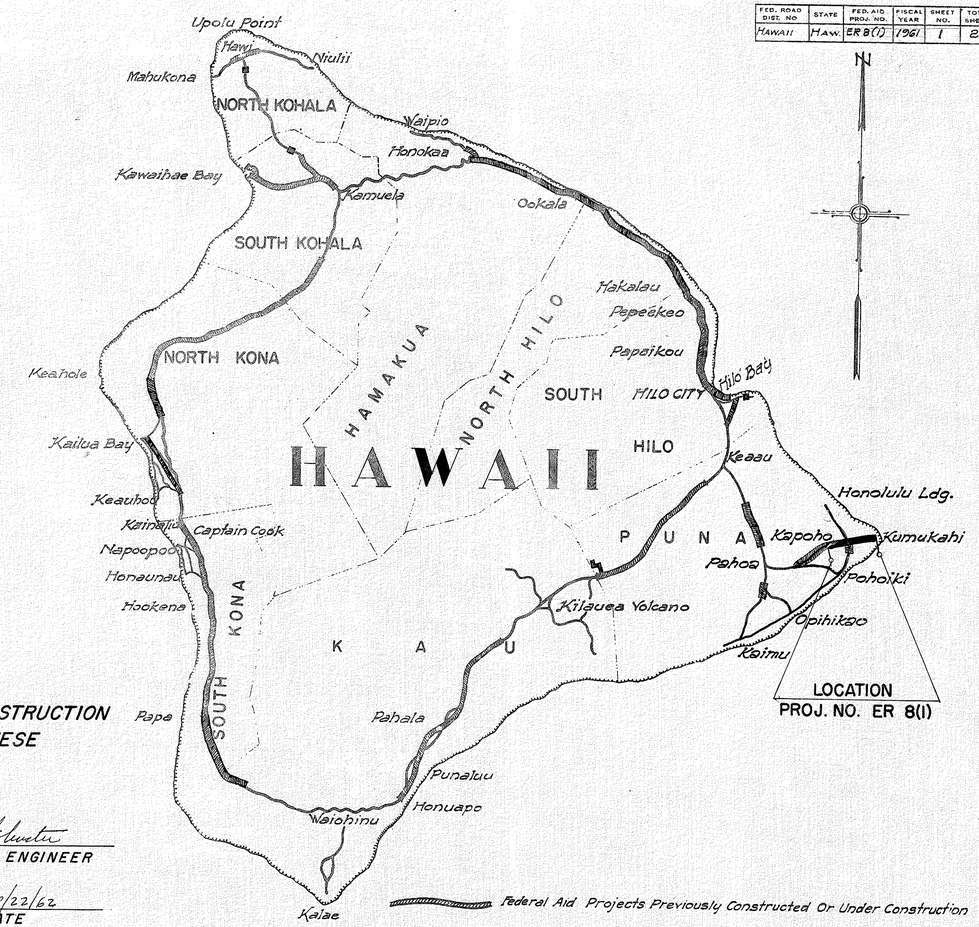

DESIGN CLASSIFICATION

	Kapoho Leg	Kumukahi Leg	Pohoiki Leg	Honolulu Landing Leg
July 1958 Count	189		100	118
1980				
ADT	864	30	892	138
DHV	12%		12%	12%
D	70/30		70/30	70/30
T	15%	40%	10%	10%
V	50	40	50	

GENERAL LOCATION PLAN
GROSS & NET LENGTH OF PROJECT: 2.6~~31~~ 29 MILES

APPROVED: DATE 5/10/61
Sam O. Hirota
for DIRECTOR OF TRANSPORTATION

DEPARTMENT OF COMMERCE
BUREAU OF PUBLIC ROADS
APPROVED:
[redacted]
DIVISION ENGINEER DATE

ER000801.01