


FINAL SURVEY	DATE
	BY
	SURVEYED
	NOTED
	NO.

ORIGINAL SURVEY	DATE
	BY
	SURVEYED
	NOTED
	NO.


DIST.	STATE	FISCAL YEAR	SHEET No.	TOTAL SHEETS

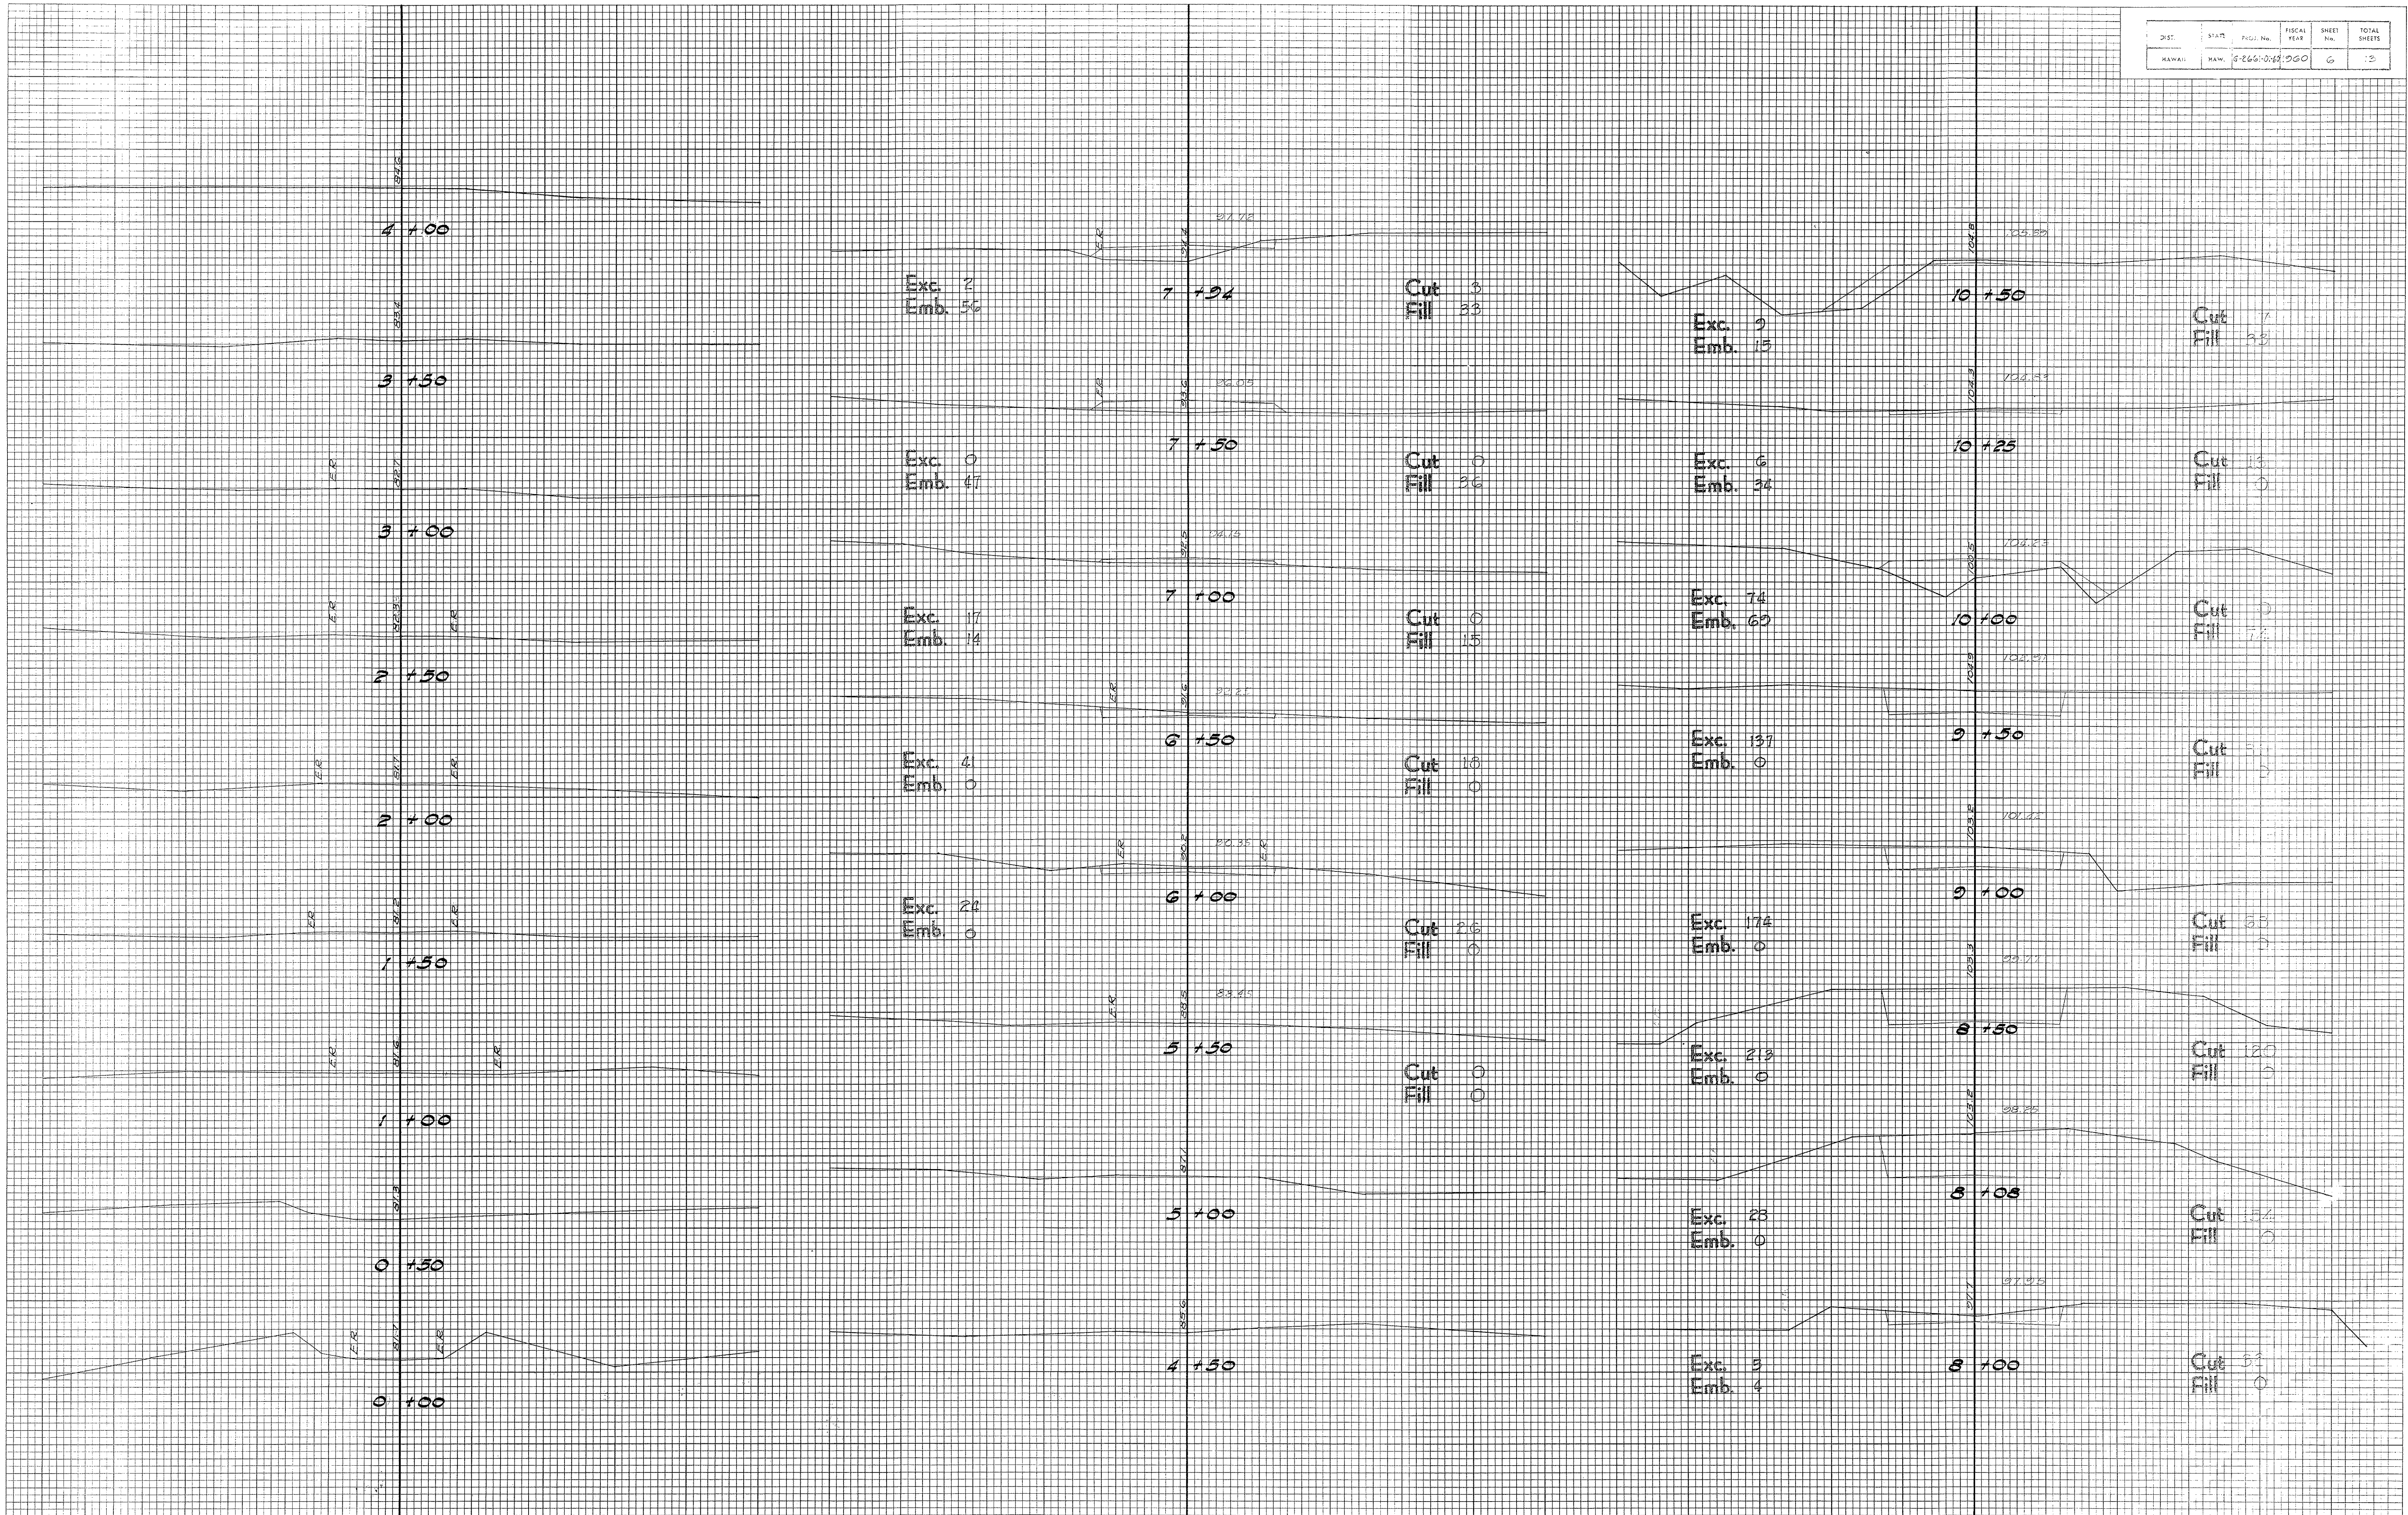

DIST.	STATE	PROJECT NO.	FISCAL YEAR	SHEET NO.	TOTAL SHEETS

FINAL SURVEY	DATE	
	BY	
	SURVEYED	
	NOTED	
	NO.	


ORIGINAL SURVEY	DATE	
	BY	
	SURVEYED	
	NOTED	
	NO.	

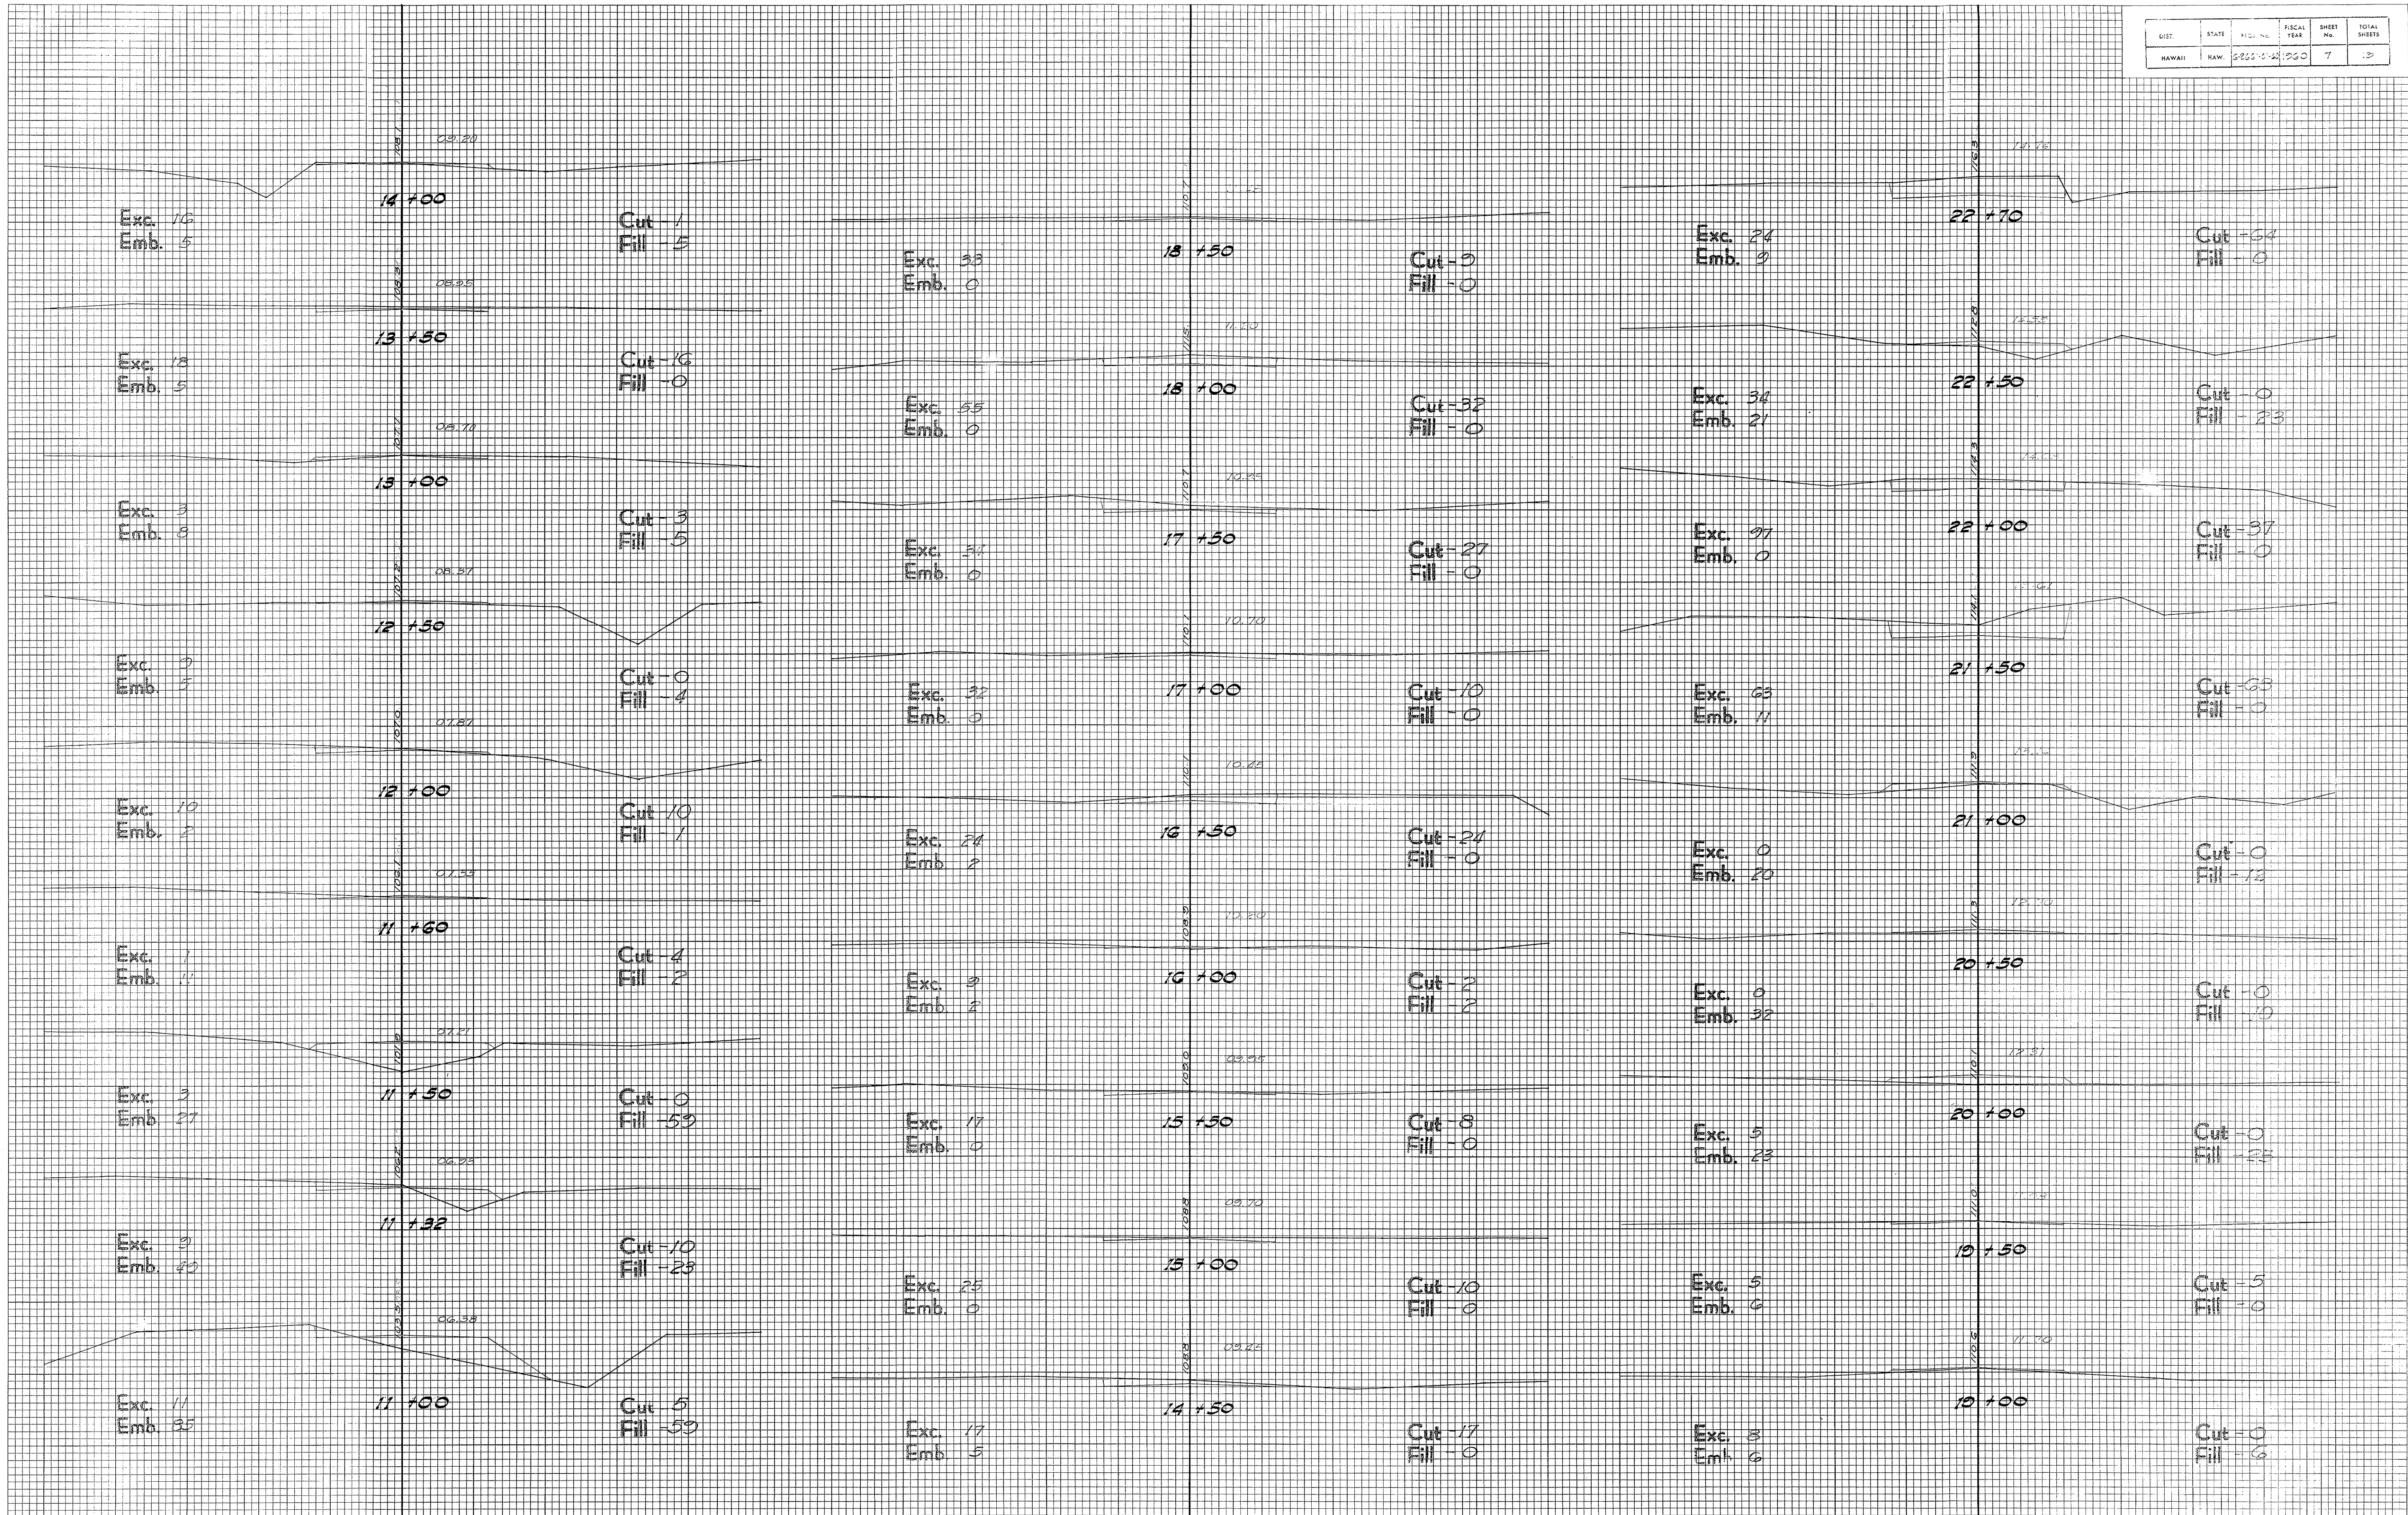

DIST.	STATE	PROJ. NO.	FISCAL YEAR	SHEET NO.	TOTAL SHEETS

DATE	BY
FINAL SURVEY	
NOTED	
AREAS CHECKED	
NO.	


DATE	BY
ORIGINAL SURVEY	
NOTED	
AREAS CHECKED	
NO.	

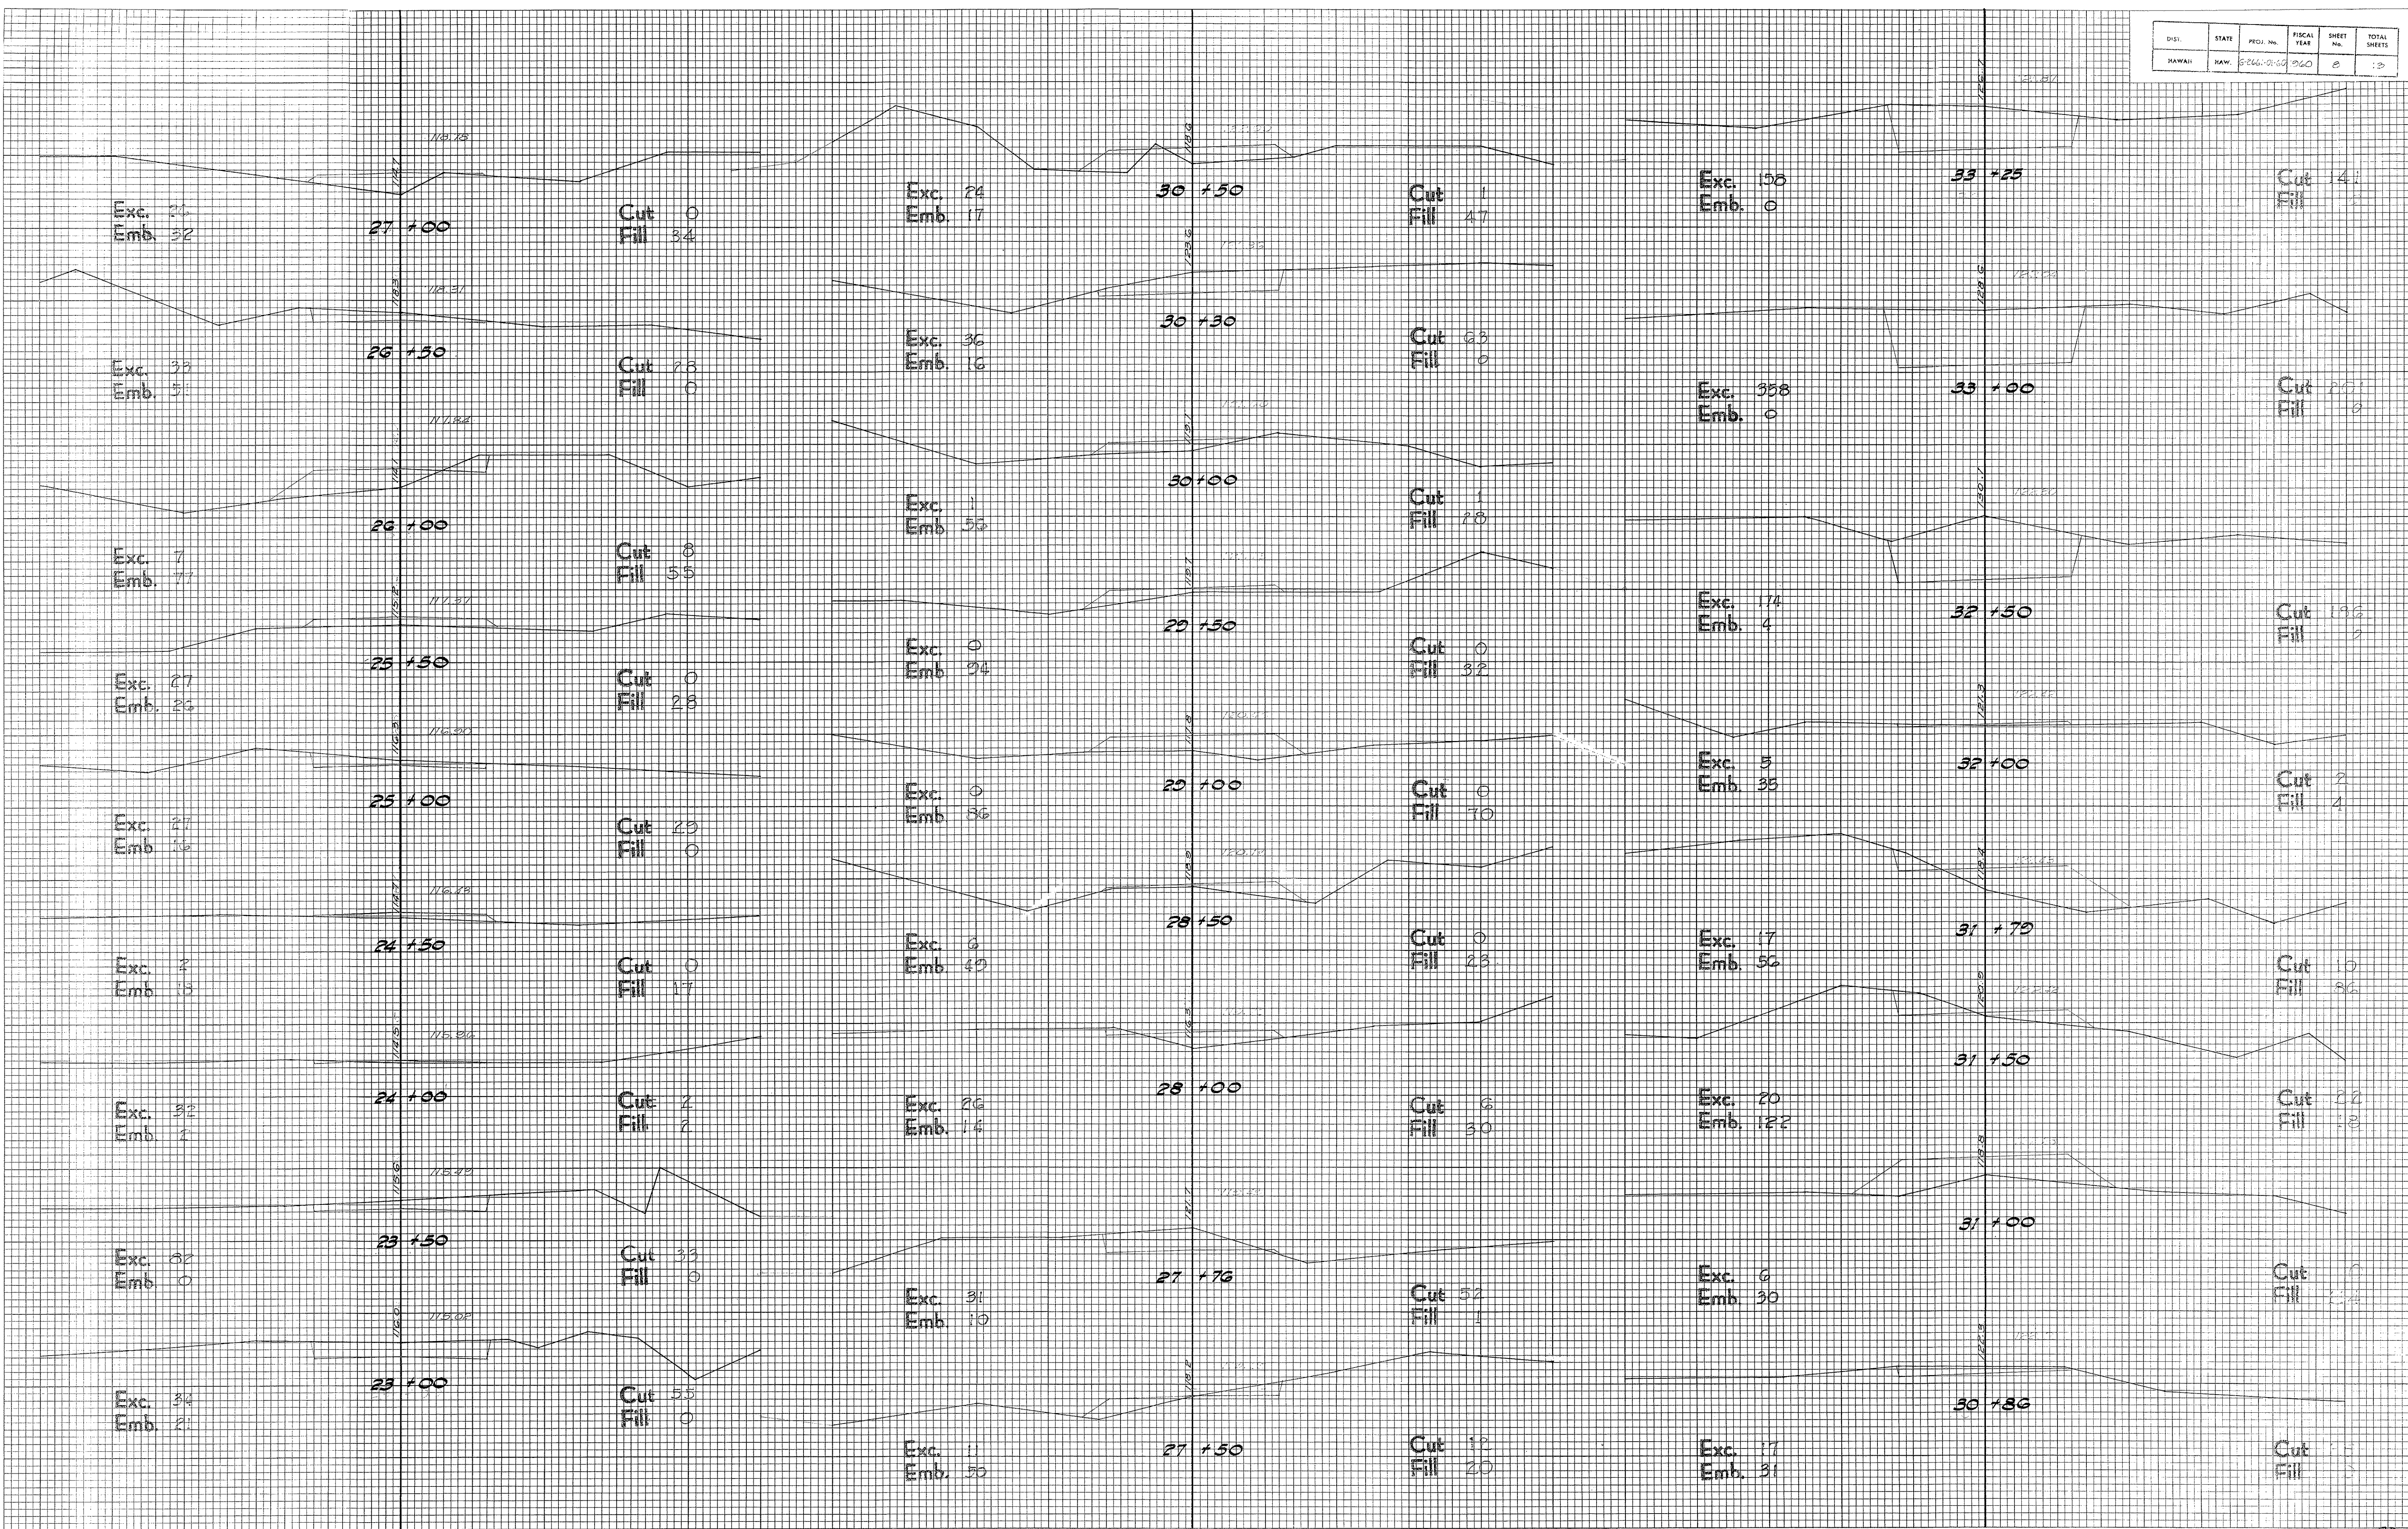

DIST.	STATE	FDL. NO.	FISCAL YEAR	SHEET NO.	TOTAL SHEETS
HAWAII	HAW.	6-256-1-1-5	1960	9	13


FINAL SURVEY	DATE	
	BY	
	SURVEYED	
	PLOTTED	
NOTE BOOK	NO.	
	AREAS CHECKED	

ORIGINAL SURVEY	DATE	
	BY	
	SURVEYED	
	PLOTTED	
NOTE BOOK	NO.	
	AREAS CHECKED	

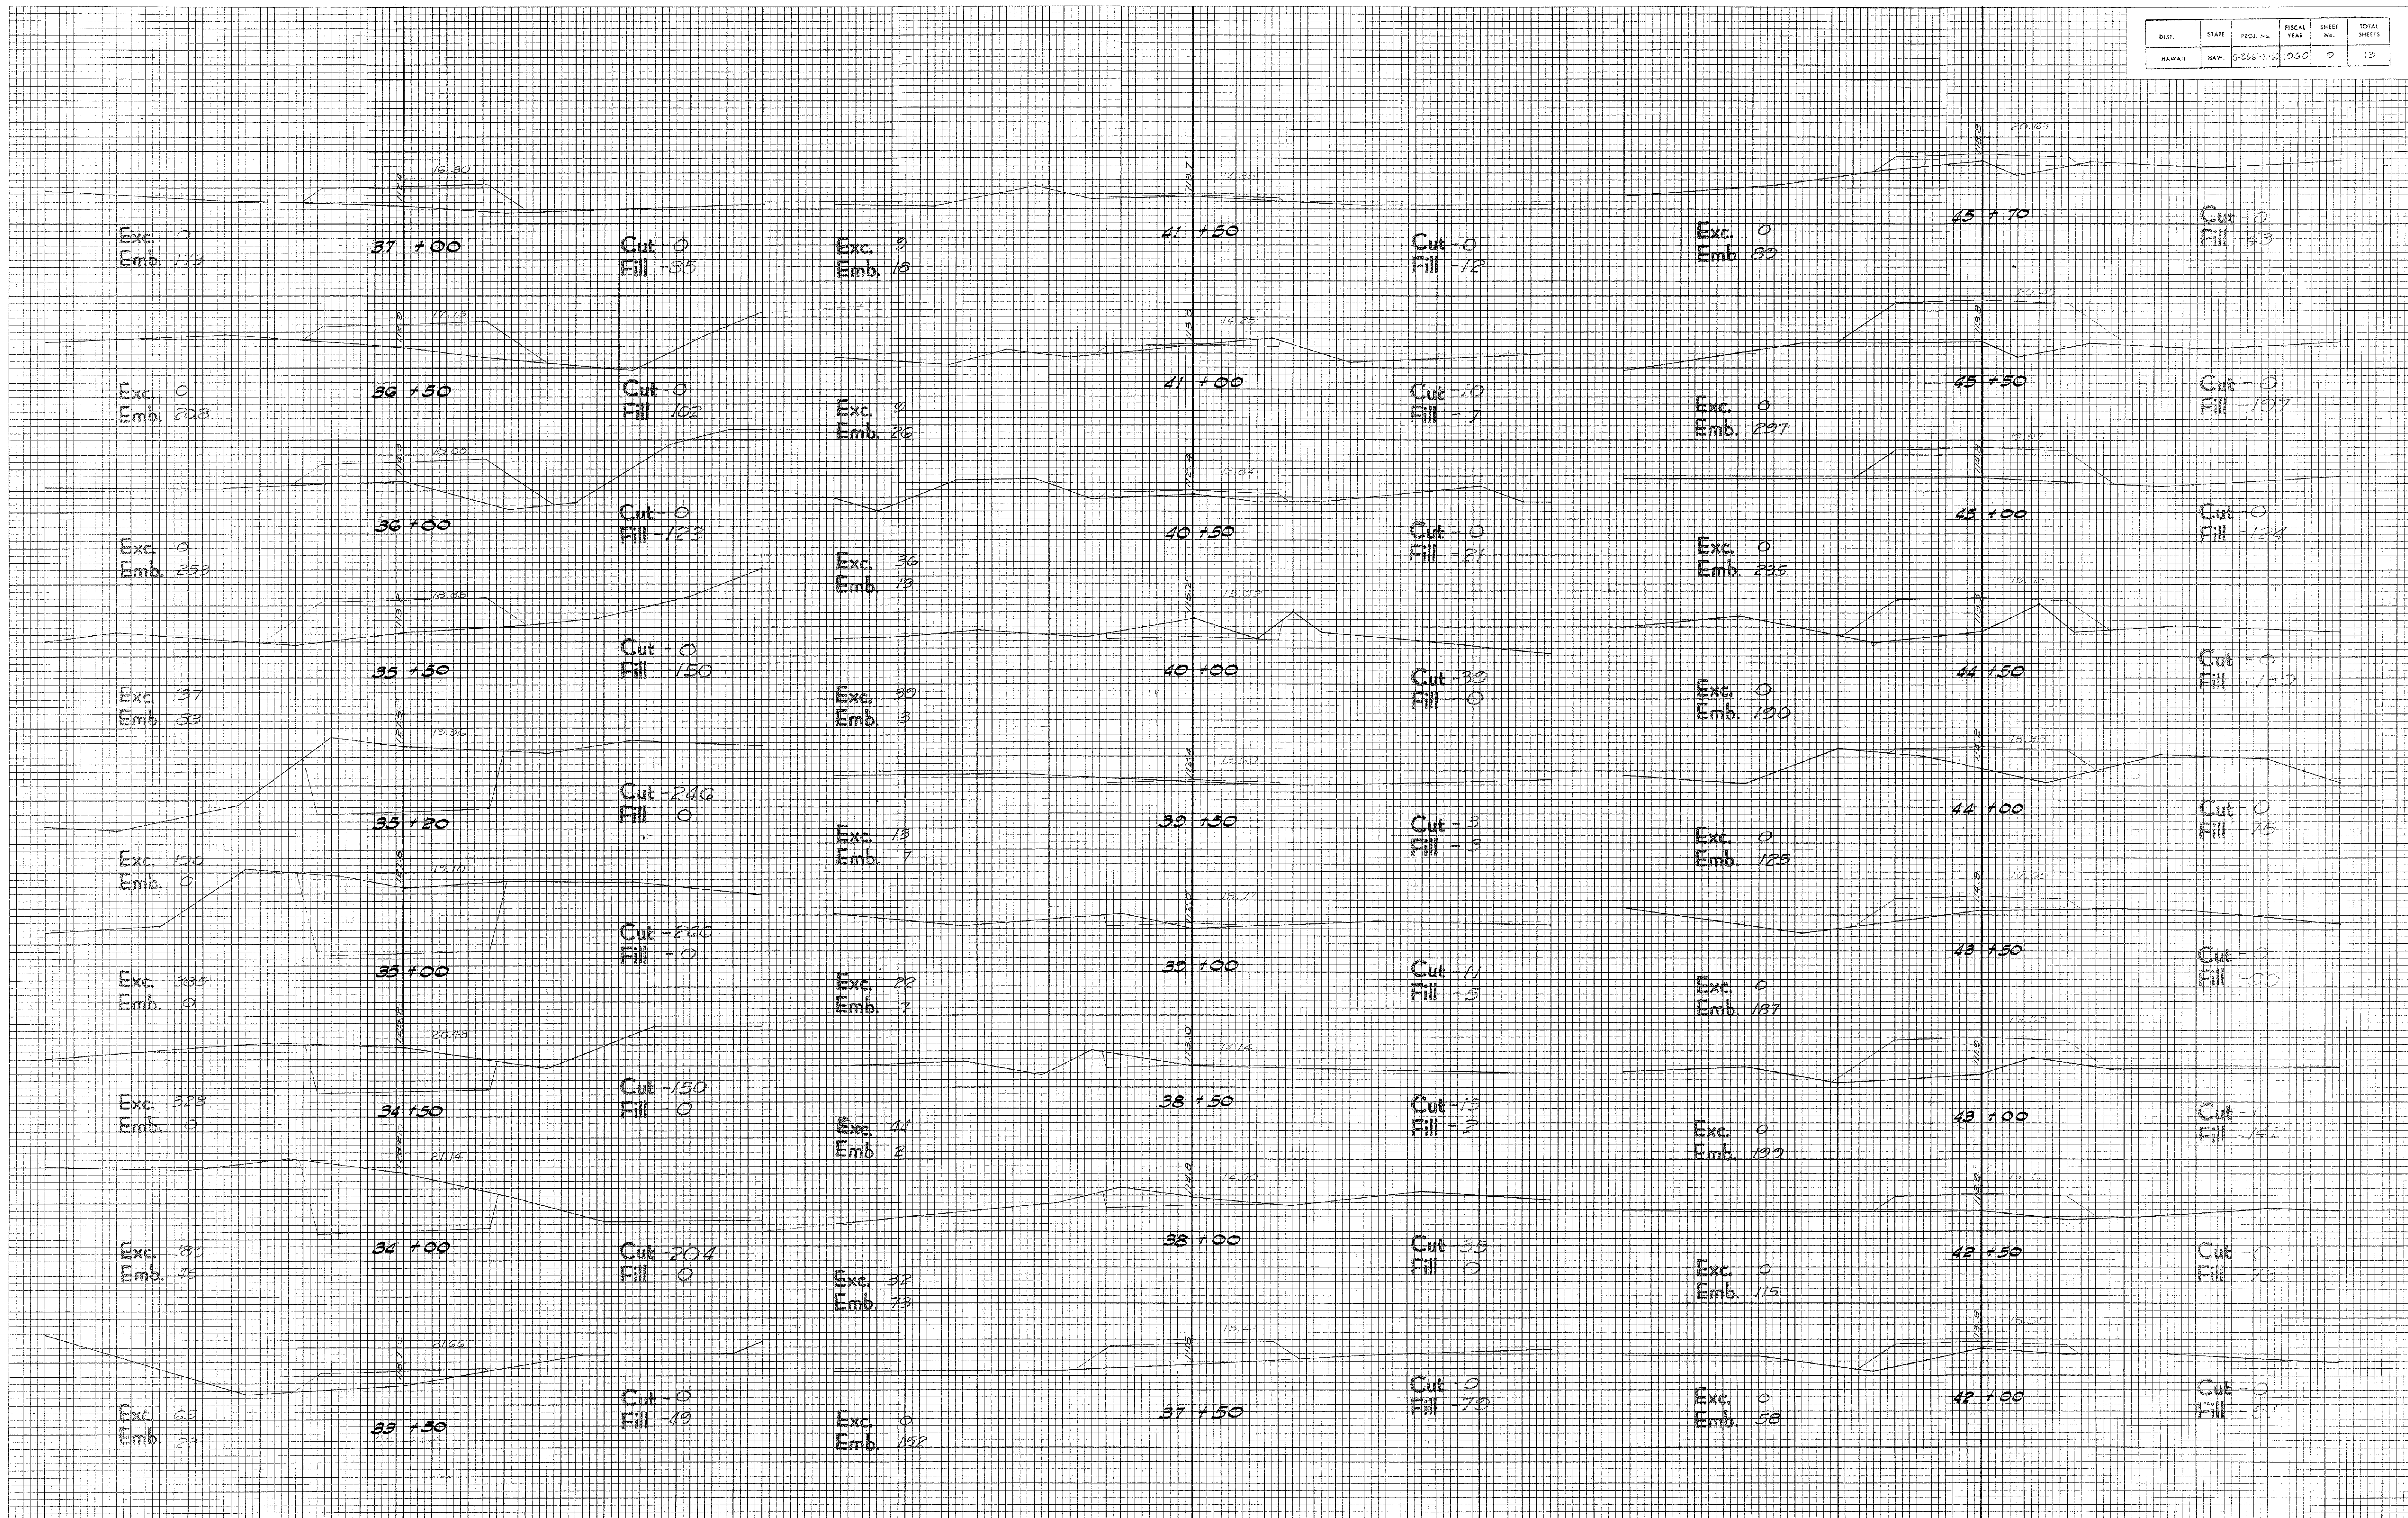

FINAL SURVEY
 SURVEYED
 PLOTTED
 NOTE BOOK
 NO. _____


ORIGINAL SURVEY
 SURVEYED
 PLOTTED
 NOTE BOOK
 NO. _____

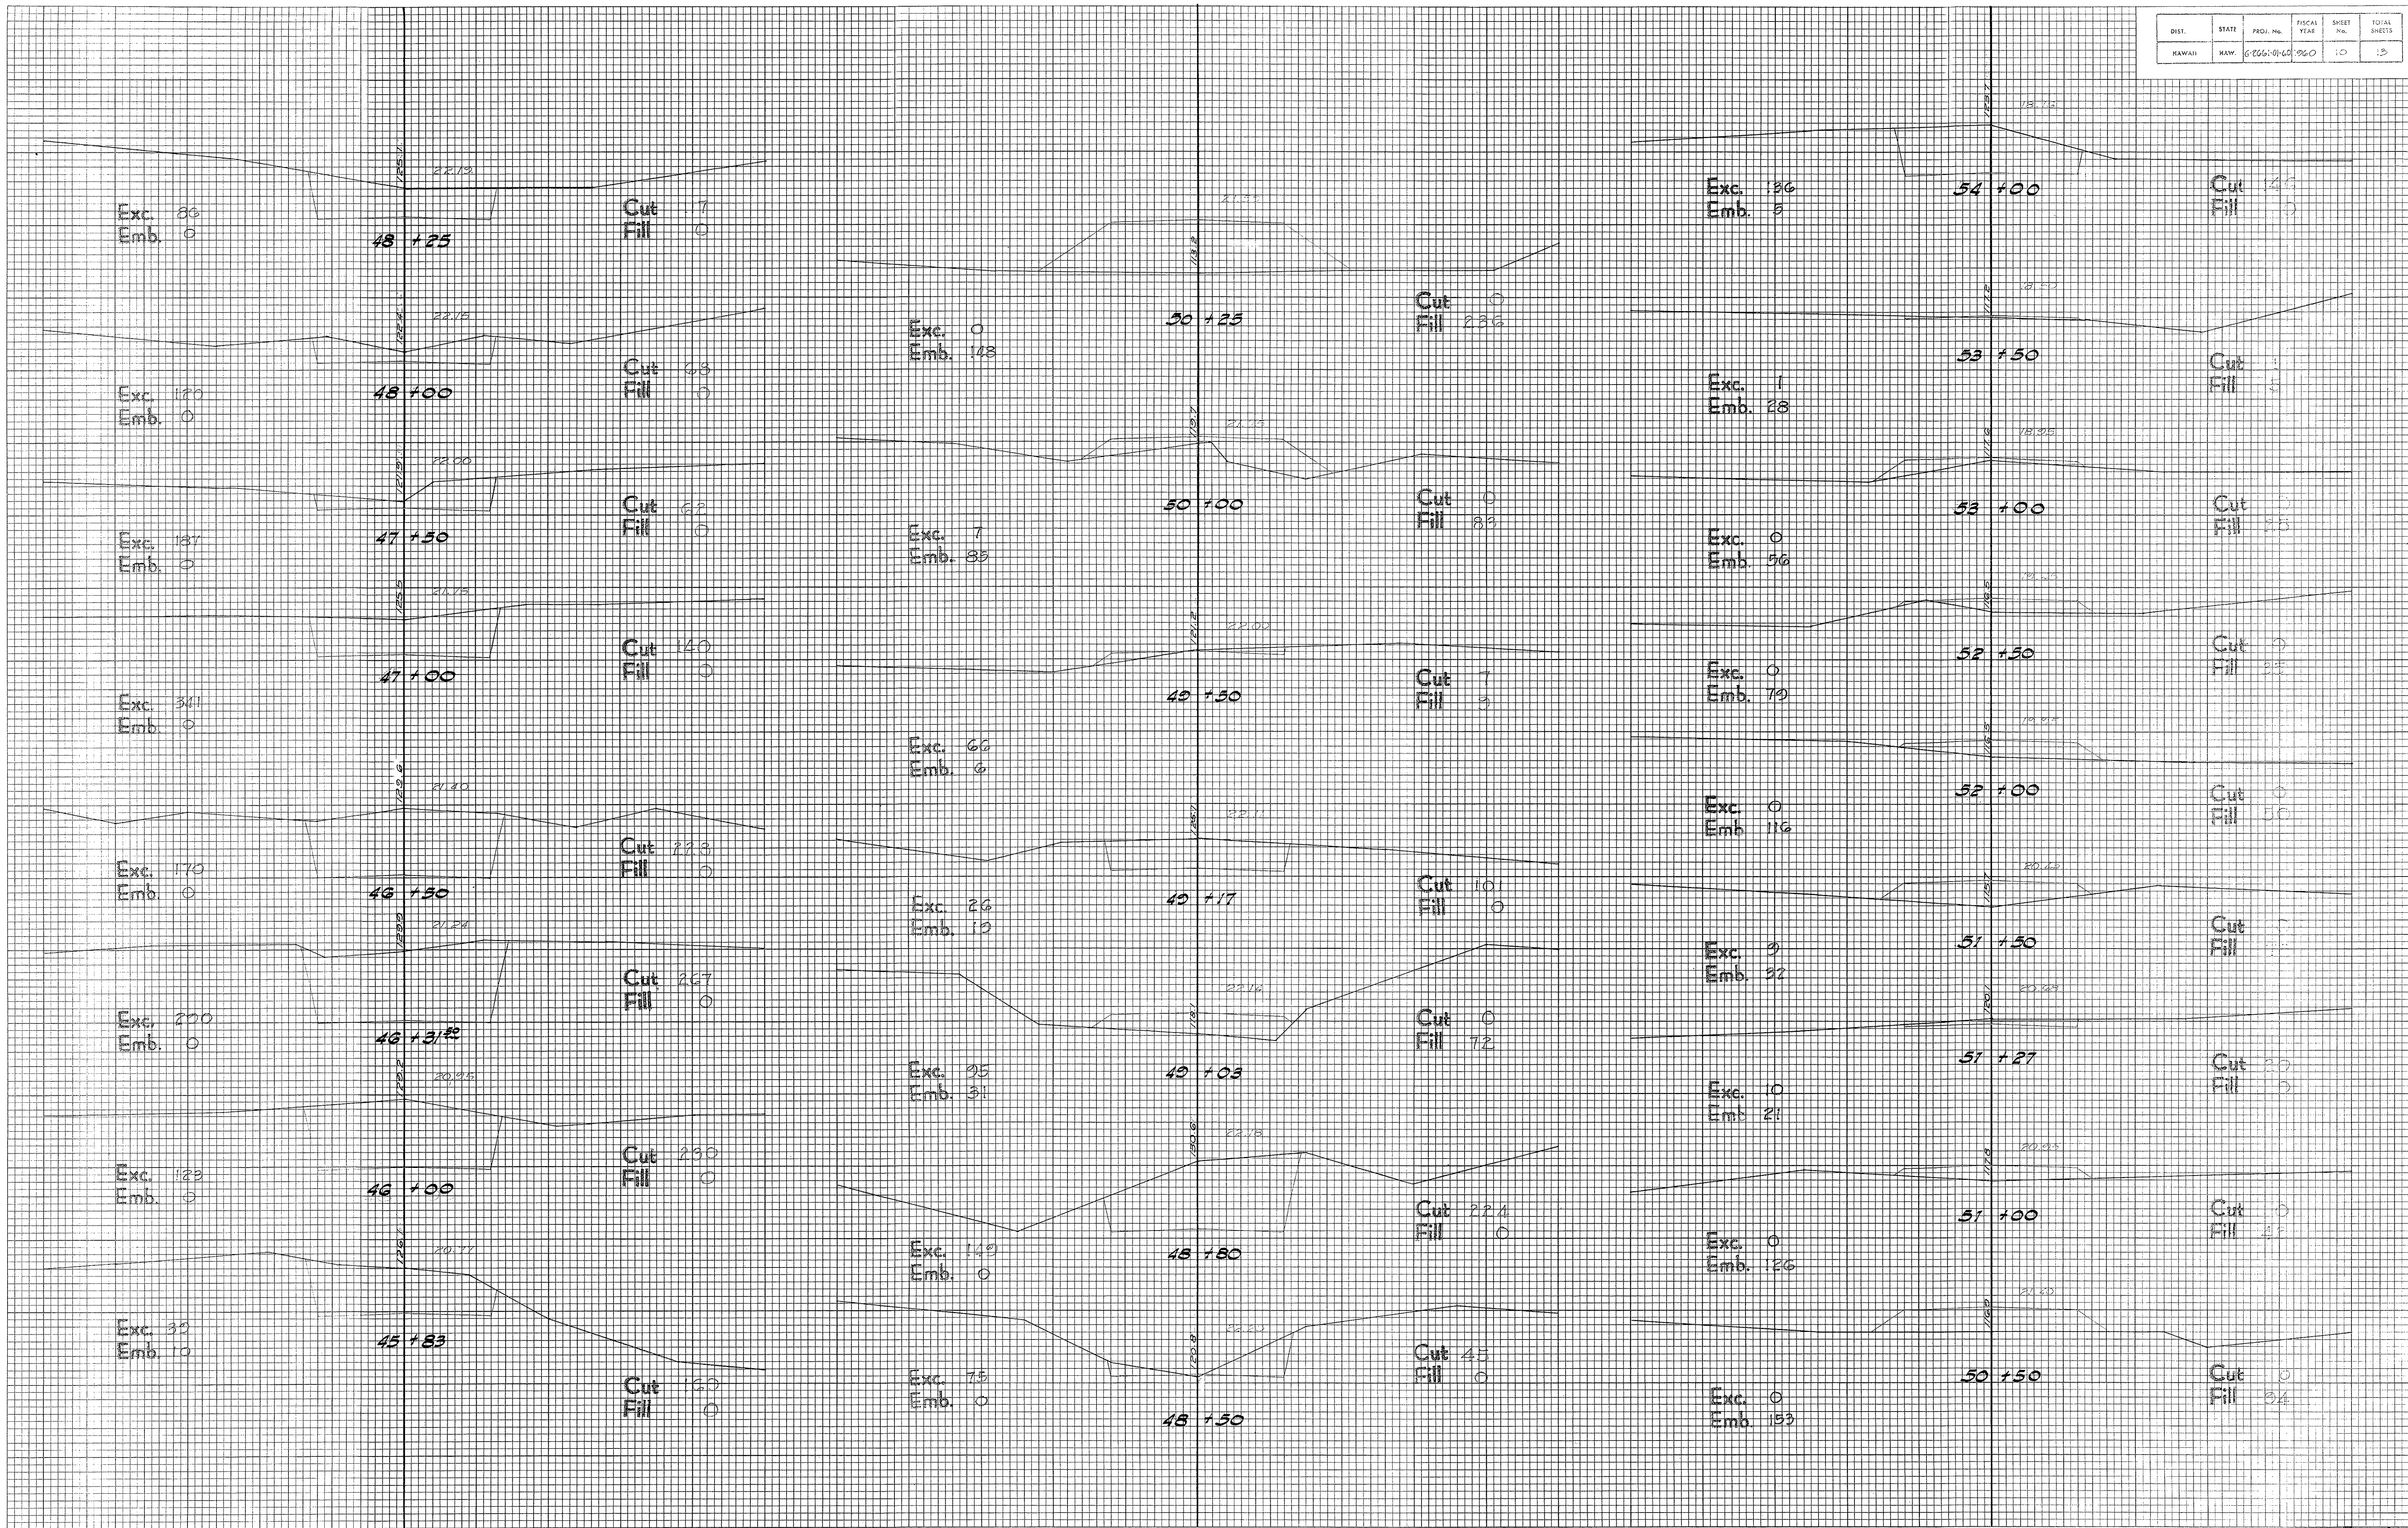

DIST.	STATE	PROJ. NO.	FISCAL YEAR	SHEET NO.	TOTAL SHEETS


FINAL SURVEY	DATE
	BY
	SURVEYED
	PLOTTED
NOTE BOOK	DATE
	BY
	AREAS
	CHECKED
NO.	DATE
	BY
	AREAS
	CHECKED

ORIGINAL SURVEY	DATE
	BY
	SURVEYED
	PLOTTED
NOTE BOOK	DATE
	BY
	AREAS
	CHECKED
NO.	DATE
	BY
	AREAS
	CHECKED

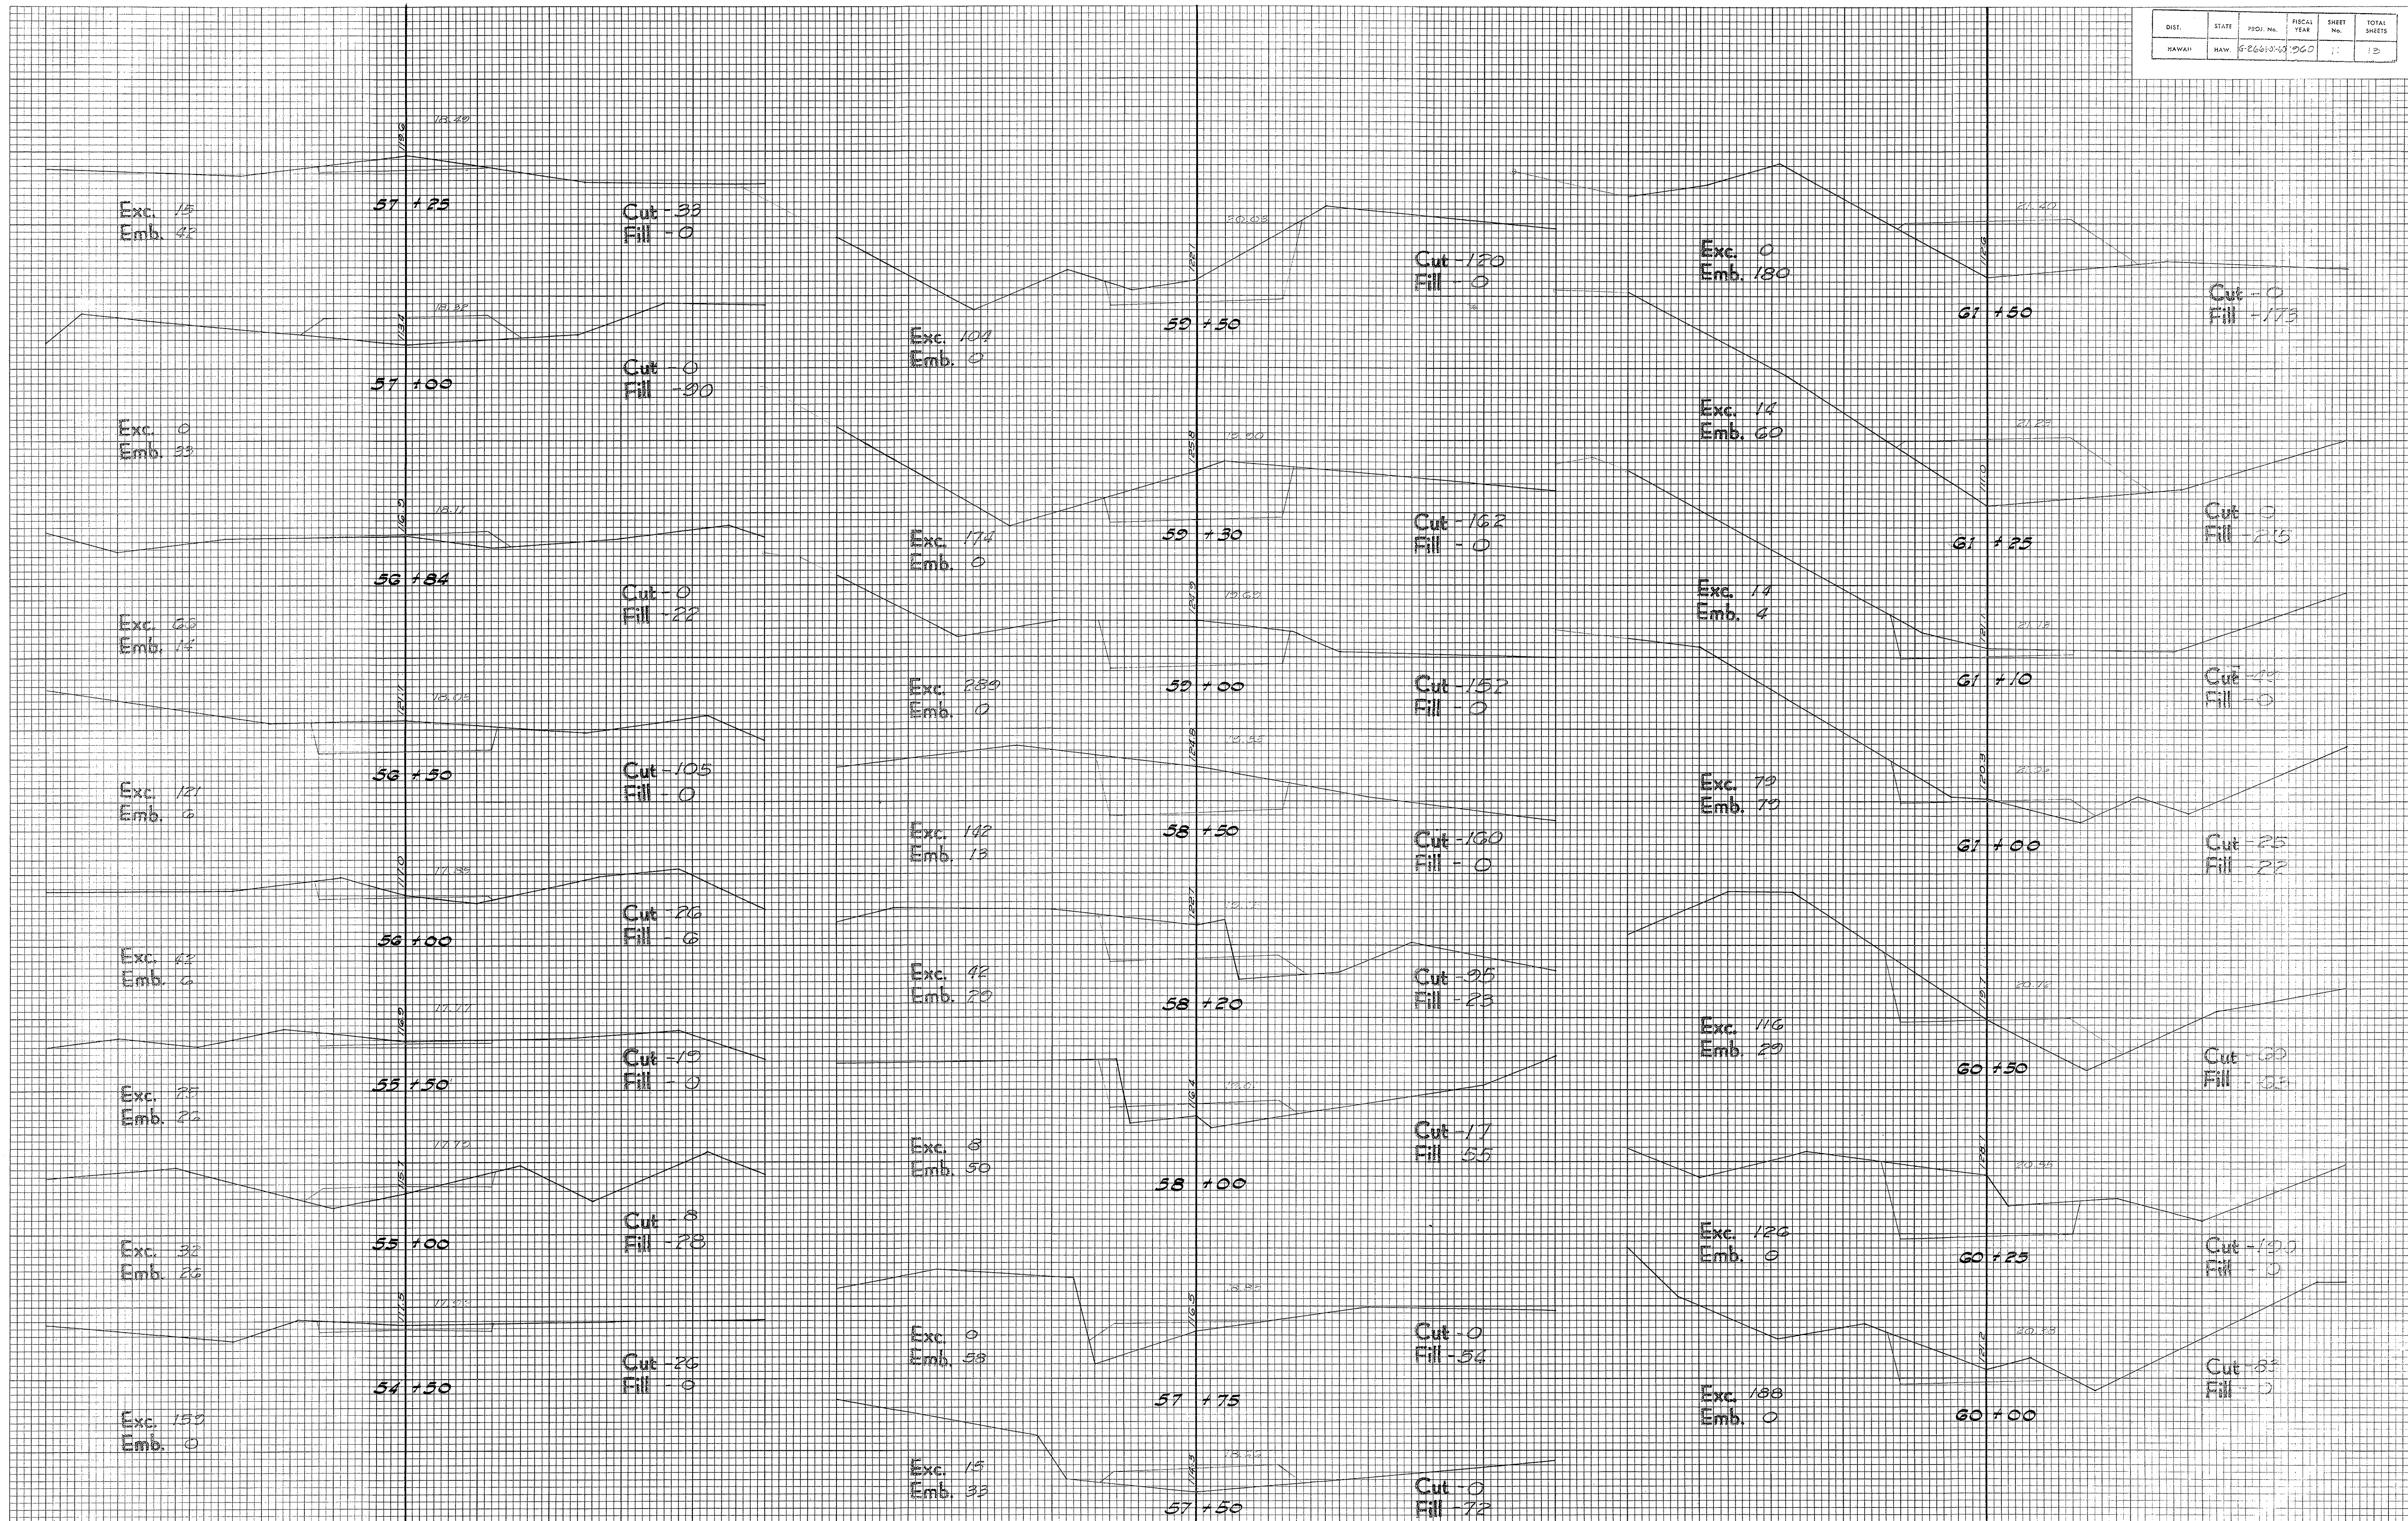

DATE	BY	FINAL SURVEY
		SURVEYED
		PLOTTED
		TEMPLATE
		NOTE BOOK
		AREAS CHECKED
		NO.

DATE	BY	ORIGINAL SURVEY
		SURVEYED
		PLOTTED
		TEMPLATE
		NOTE BOOK
		AREAS CHECKED
		NO.

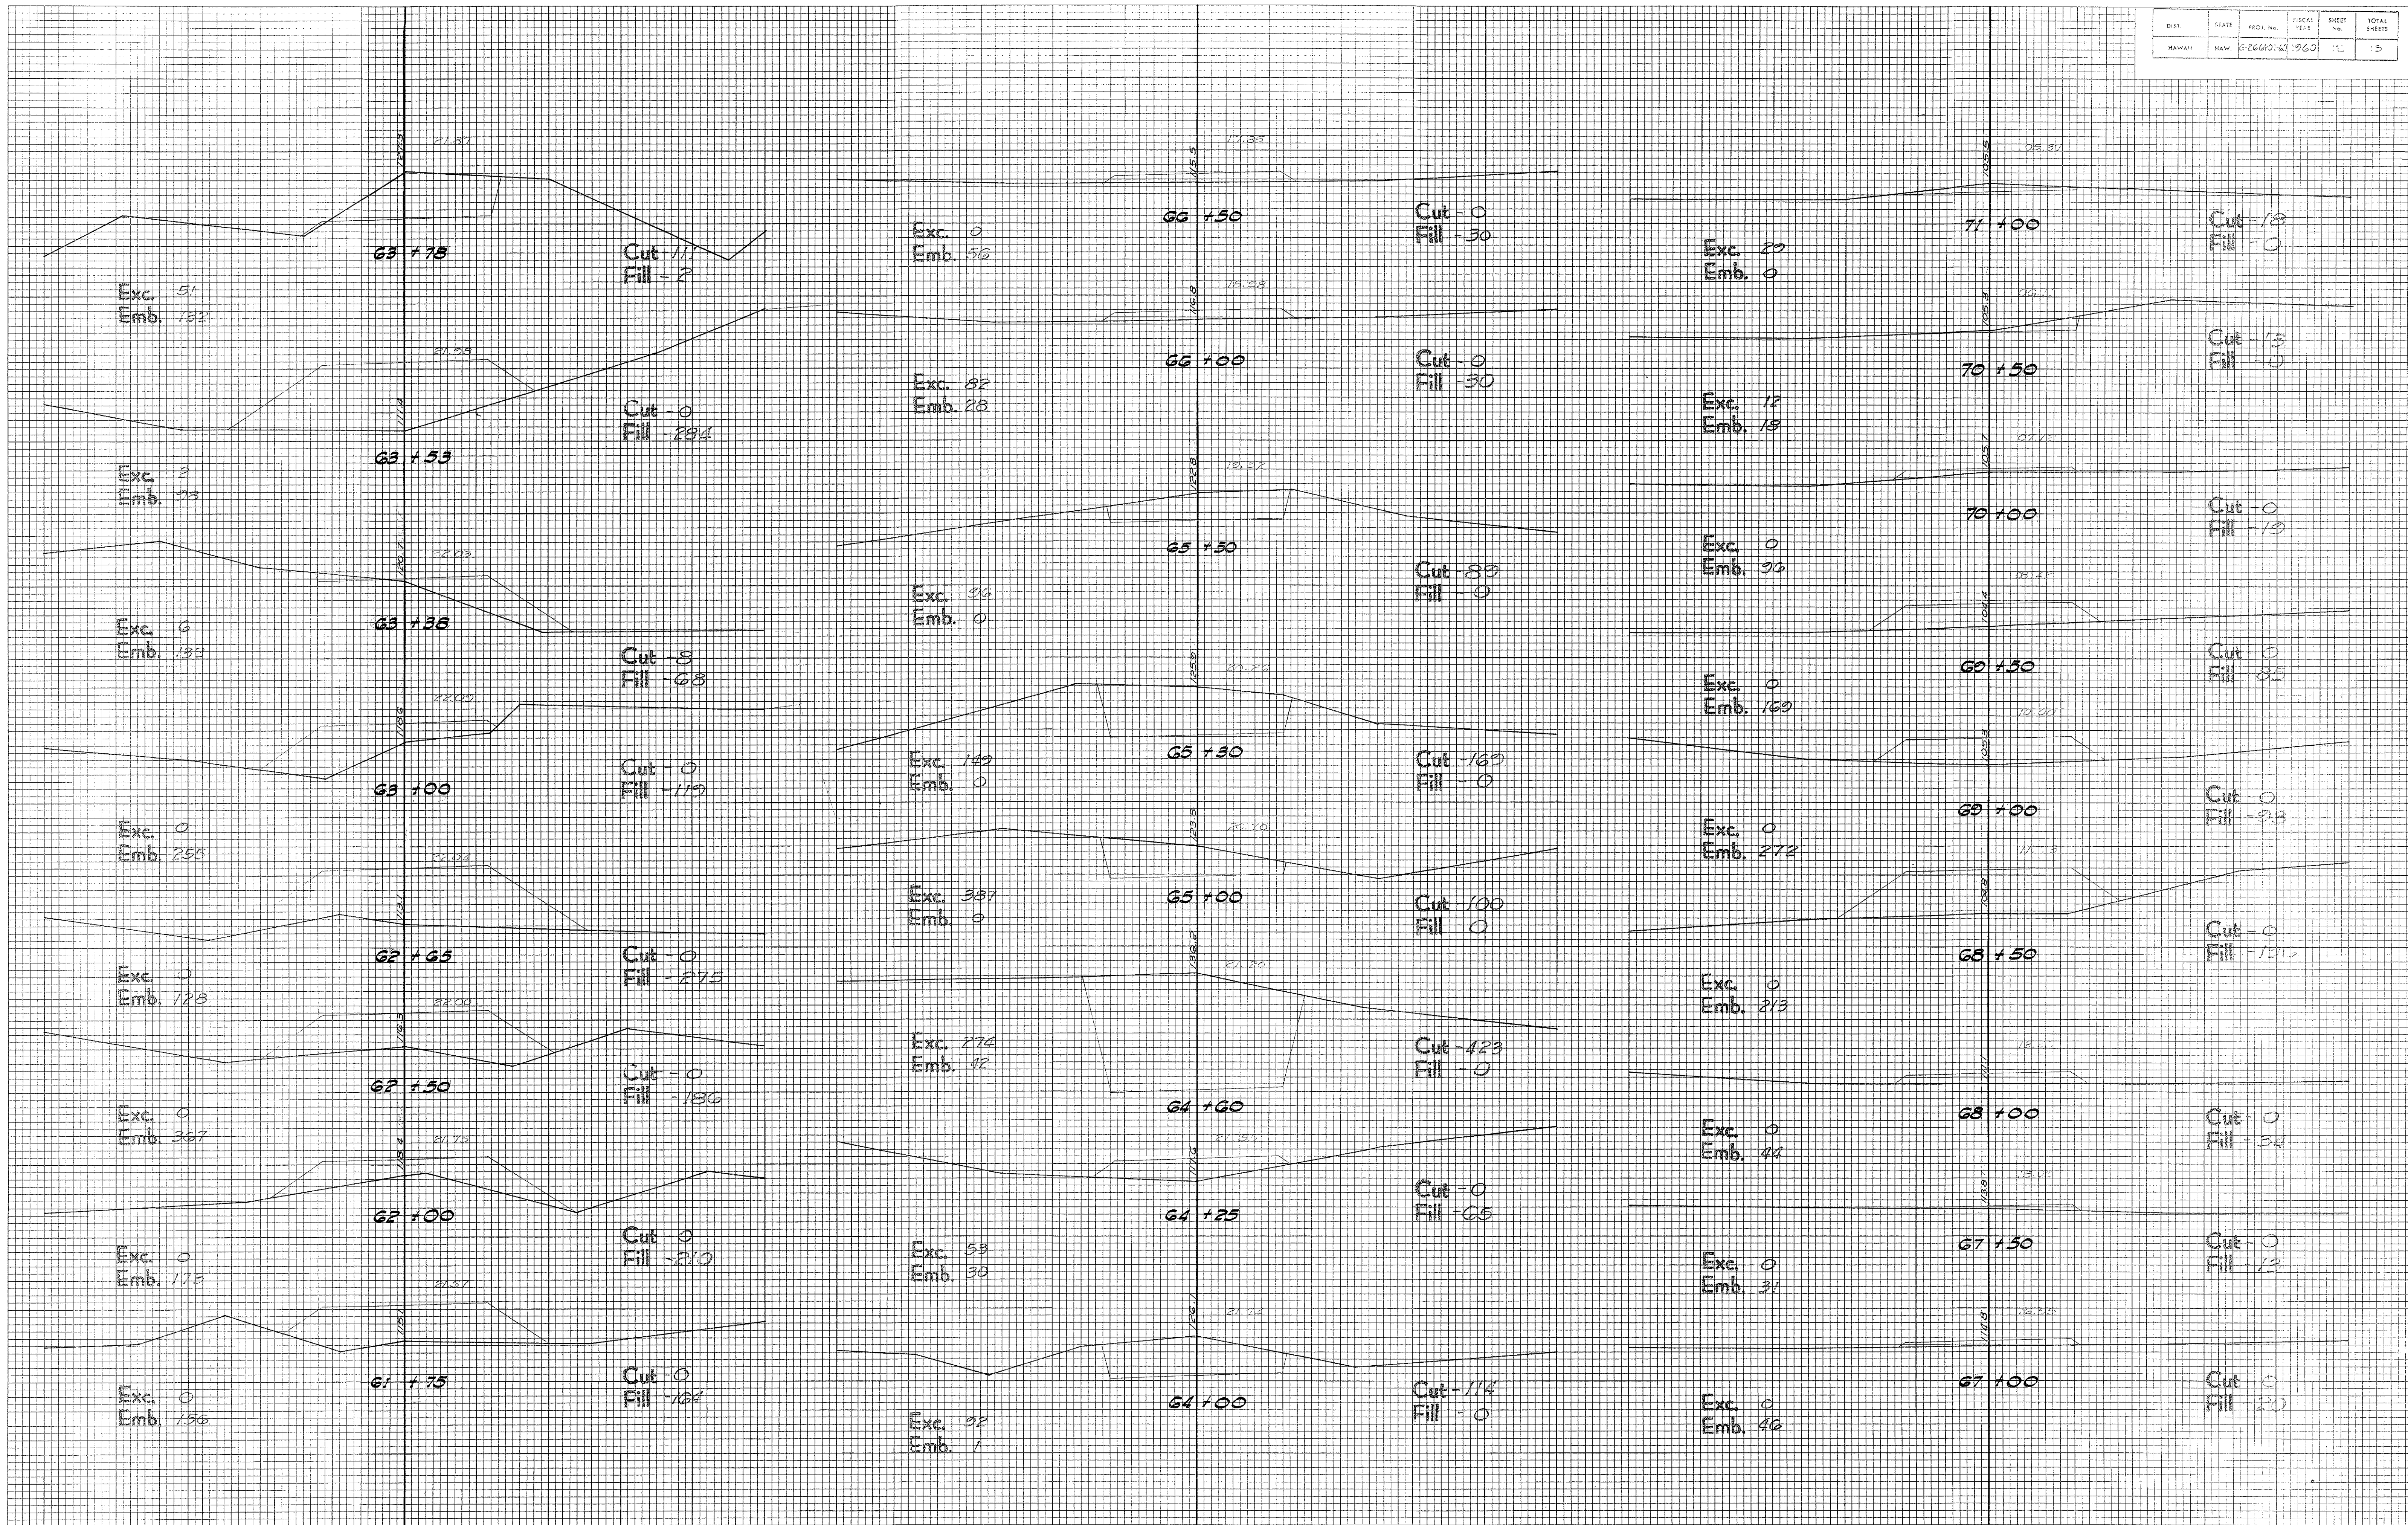

ORIGINAL			BY	DATE
SURVEYED				
PLOTTED				
TEMPLATE				
AREAS				
AREAS CHECKED				
NO.				

