


FED. ROAD DIST. NO.	STATE	PROJ. NO.	FISCAL YEAR	SHEET NO.	TOTAL SHEETS
HAWAII	HAW.	HWY. - H - 01-86	1987	32	115

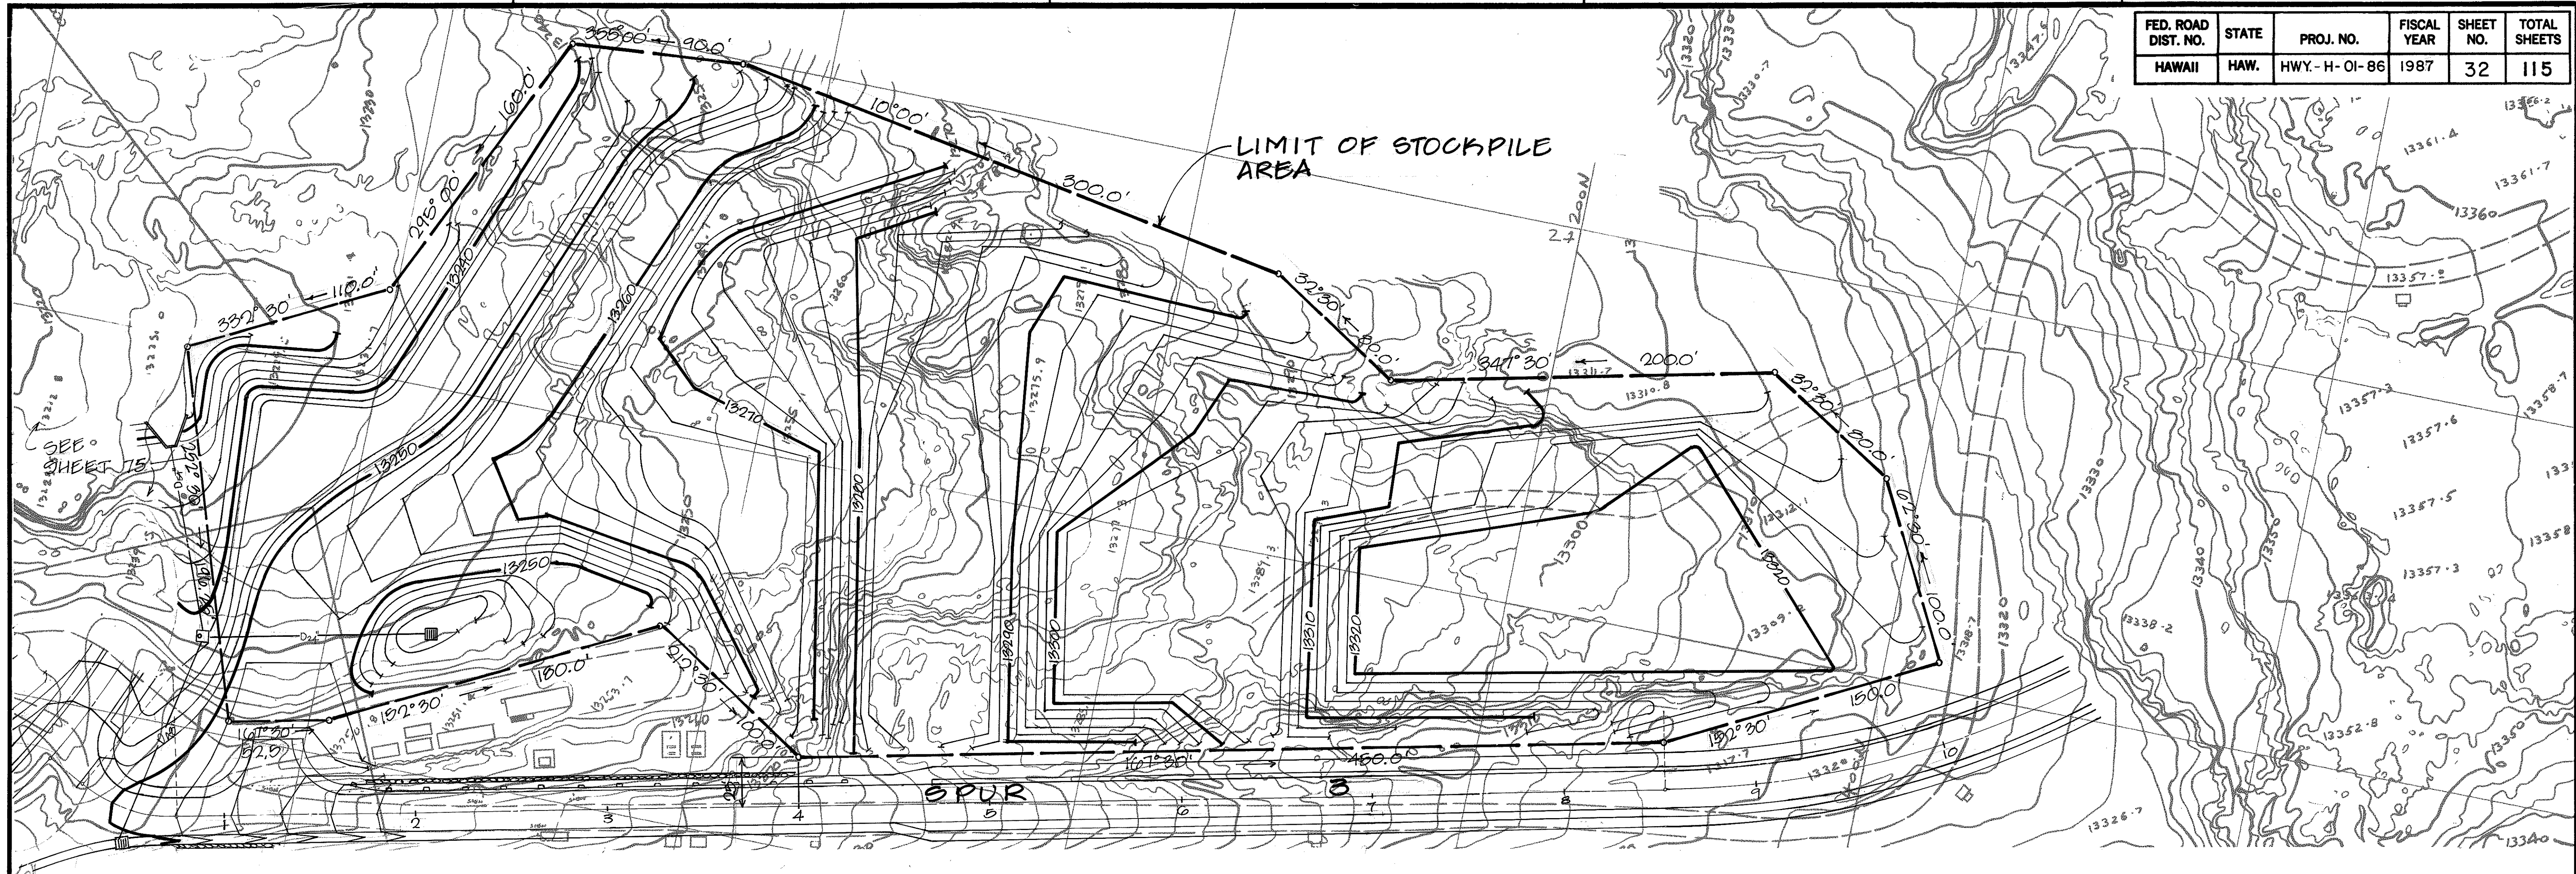

STOCKPILE AREA = 1.2 ACRES  
STOCKPILE CAPACITY = 93,000 CU. YDS.

NOTE:

STATE HIGHWAYS DIVISION SHALL  
DETERMINE FINAL MATERIAL QUANTITY  
IN STOCKPILE.

ORIGINAL PLAN	SURVEY PLOTTED BY _____	DATE _____
	DRAWN BY _____	" "
	TRACED BY _____	" "
	DESIGNED BY _____	" "
	QUANTITIES BY _____	" "
	CHECKED BY _____	" "
No. _____		

