INDEX TO DRAWINGS	
SHEET	DESCRIPTION
1	TITLE SHEET

TERRITORY OF HAWAII

TERRITORIAL HIGHWAY DEPARTMENT

HONOLULU T.H.

PLANS OF

REHABILITATION OF A PORTION OF VOLCANO ROAD

WAR DAMAGE REHABILITATION PROJECT NO. W.D.R. 11 (2)

DISTRICT OF PUNA

ISLAND OF HAWAII

FED. ROAD DIST. NO.	STATE	FED. AID PROJ. NO.	FISCAL YEAR	SHEET NO.	TOTAL SHEETS
HAWAII	H.A.W.	W.D.R. 11(2)	1948	1	1

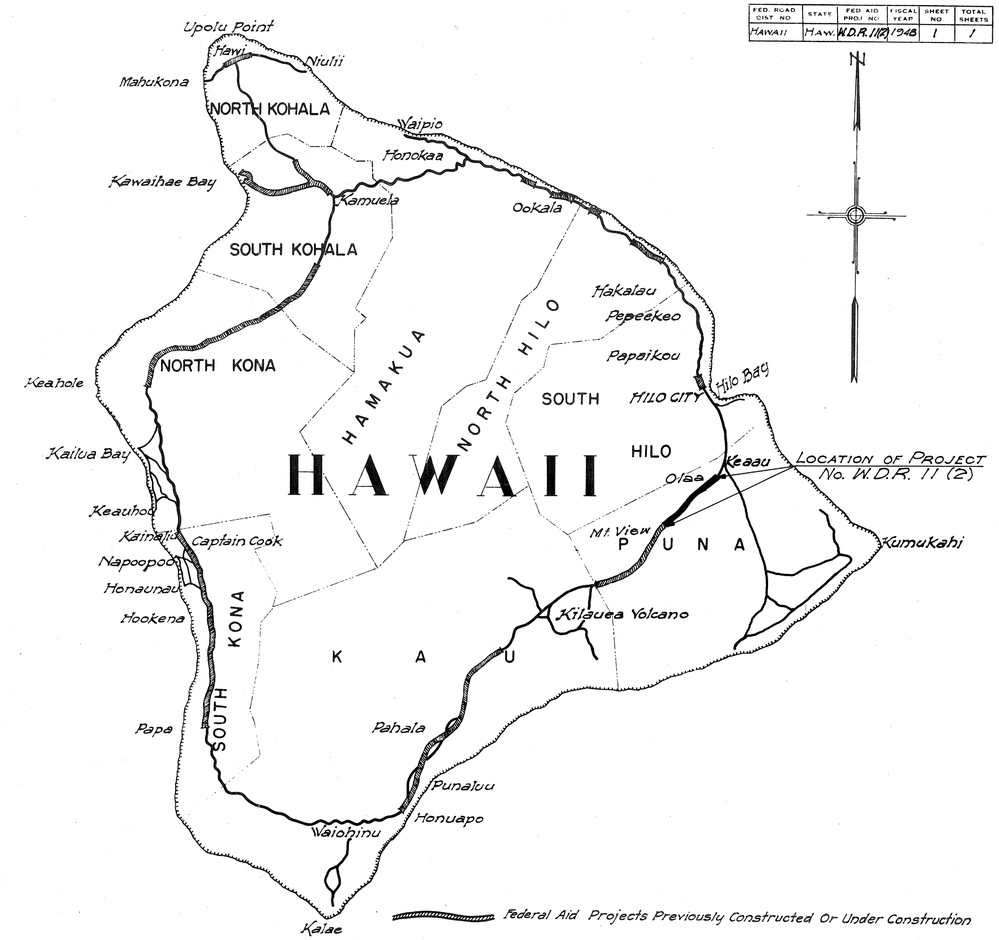

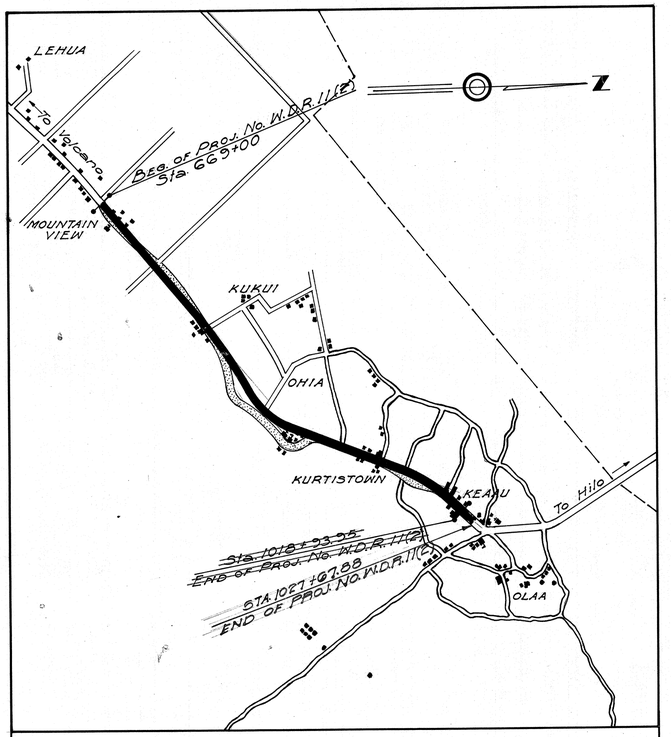

LAYOUT OF PROJECT

Scale: 1" = 1 mile

Gross & Net Length of Project: ~~6.599~~ 6.793 Miles

NOTE:

ALL CHANGES MADE DURING CONSTRUCTION HAVE BEEN NOTED IN RED ON THESE TRACINGS AND CHECKED BY:

Walter O. Watson Jr.

RESIDENT ENGINEER

DATE Feb. 12, 1951

RECOMMENDED FOR APPROVAL: DATE: [redacted]

[redacted]

DISTRICT ENGINEER
PUBLIC ROADS ADMINISTRATION
FEDERAL WORKS AGENCY

APPROVED: DATE: 8-2-48

TERRITORIAL HIGHWAY ENGINEER

APPROVED: DATE: [redacted]

[redacted]

DIVISION ENGINEER
PUBLIC ROADS ADMINISTRATION
FEDERAL WORKS AGENCY

ORIGINAL PLAN		DATE
	SURVEY PLOTTED BY	
	DESIGNED BY	
	DRAWN BY	
NOTE BOOK	TRACED BY	
	QUANTITIES BY	
	QUANTITIES CHECKED BY	
No.	CHECKED BY	

5339.1