FED. ROAD DIST. NO.	STATE	FED. AID PROJ. NO.	FISCAL YEAR	SHEET NO.	TOTAL SHEETS
HAWAII	HAW.	F-18(5)	1951	1	38

4-21-52

INDEX TO DRAWINGS

SHEET	DESCRIPTION
1	TITLE SHEET
2	TYPICAL SECTION
3-14	PLAN & PROFILE
15-16	STANDARD DETAILS
17-38	CROSS SECTIONS

TERRITORY OF HAWAII

TERRITORIAL HIGHWAY DEPARTMENT

HONOLULU T.H.

PLANS OF

HAWAII BELT ROAD

FEDERAL AID PROJECT No. F-18 (5)

DISTRICT OF KAU

ISLAND OF HAWAII

CONVENTIONAL SIGNS USED

Centerline — 150

Boundary Lines — or,

Fences (Noted) — or,

Existing Roadway

Box Culvert

Circular Culvert

Bridge

Railroad — or,

Tree (Large) — or,

Telephone Pole — TP

Electric Pole — EP

Warning & Regulatory Signs — Type

Centerline Monument

SCALES

PLAN		1 IN. = 100 FT.
PROFILE	HOR.	1 IN. = 100 FT.
	VERT.	1 IN. = 10 FT.
CROSS-SECTION	HOR.	1 IN. = 10 FT.
	VERT.	1 IN. = 10 FT.

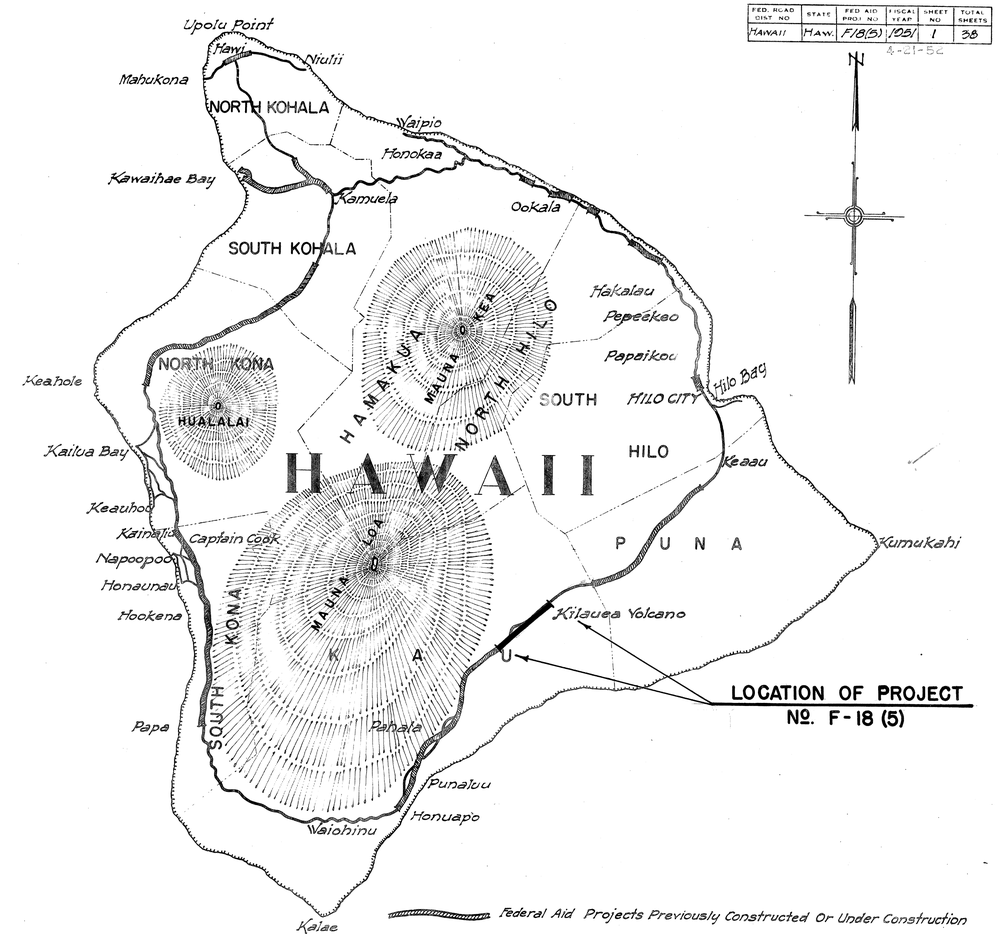

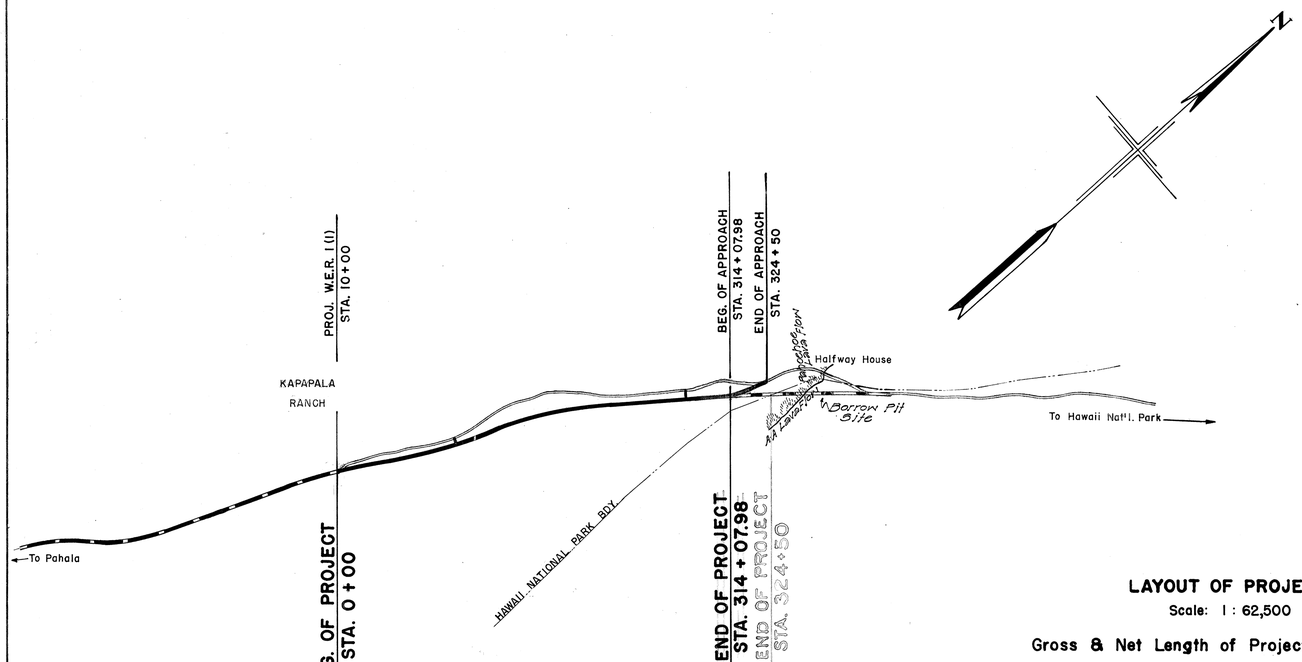

LAYOUT OF PROJECT

Scale: 1 : 62,500

Gross & Net Length of Project ~~5.948~~ 6.146 Miles

NOTE:
ALL CHANGES MADE DURING CONSTRUCTION HAVE BEEN NOTED IN RED ON THESE TRACINGS AND CHECKED BY:

E. A. Moore
RESIDENT ENGINEER

May 28, 1953
DATE

APPROVED DATE 9/7/51

TERRITORIAL HIGHWAY ENGINEER

DEPARTMENT OF COMMERCE
BUREAU OF PUBLIC ROADS

RECOMMENDED FOR APPROVAL: [redacted]

DISTRICT ENGINEER — DATE

APPROVED: [redacted]

DIVISION ENGINEER — DATE

ORIGINAL PLATS	DESIGNED BY	DRAWN BY	TRACED BY	QUANTITIES BY	QUANTITIES CHECKED BY	CHECKED BY
NOTE BOOK No.						

5550.1