



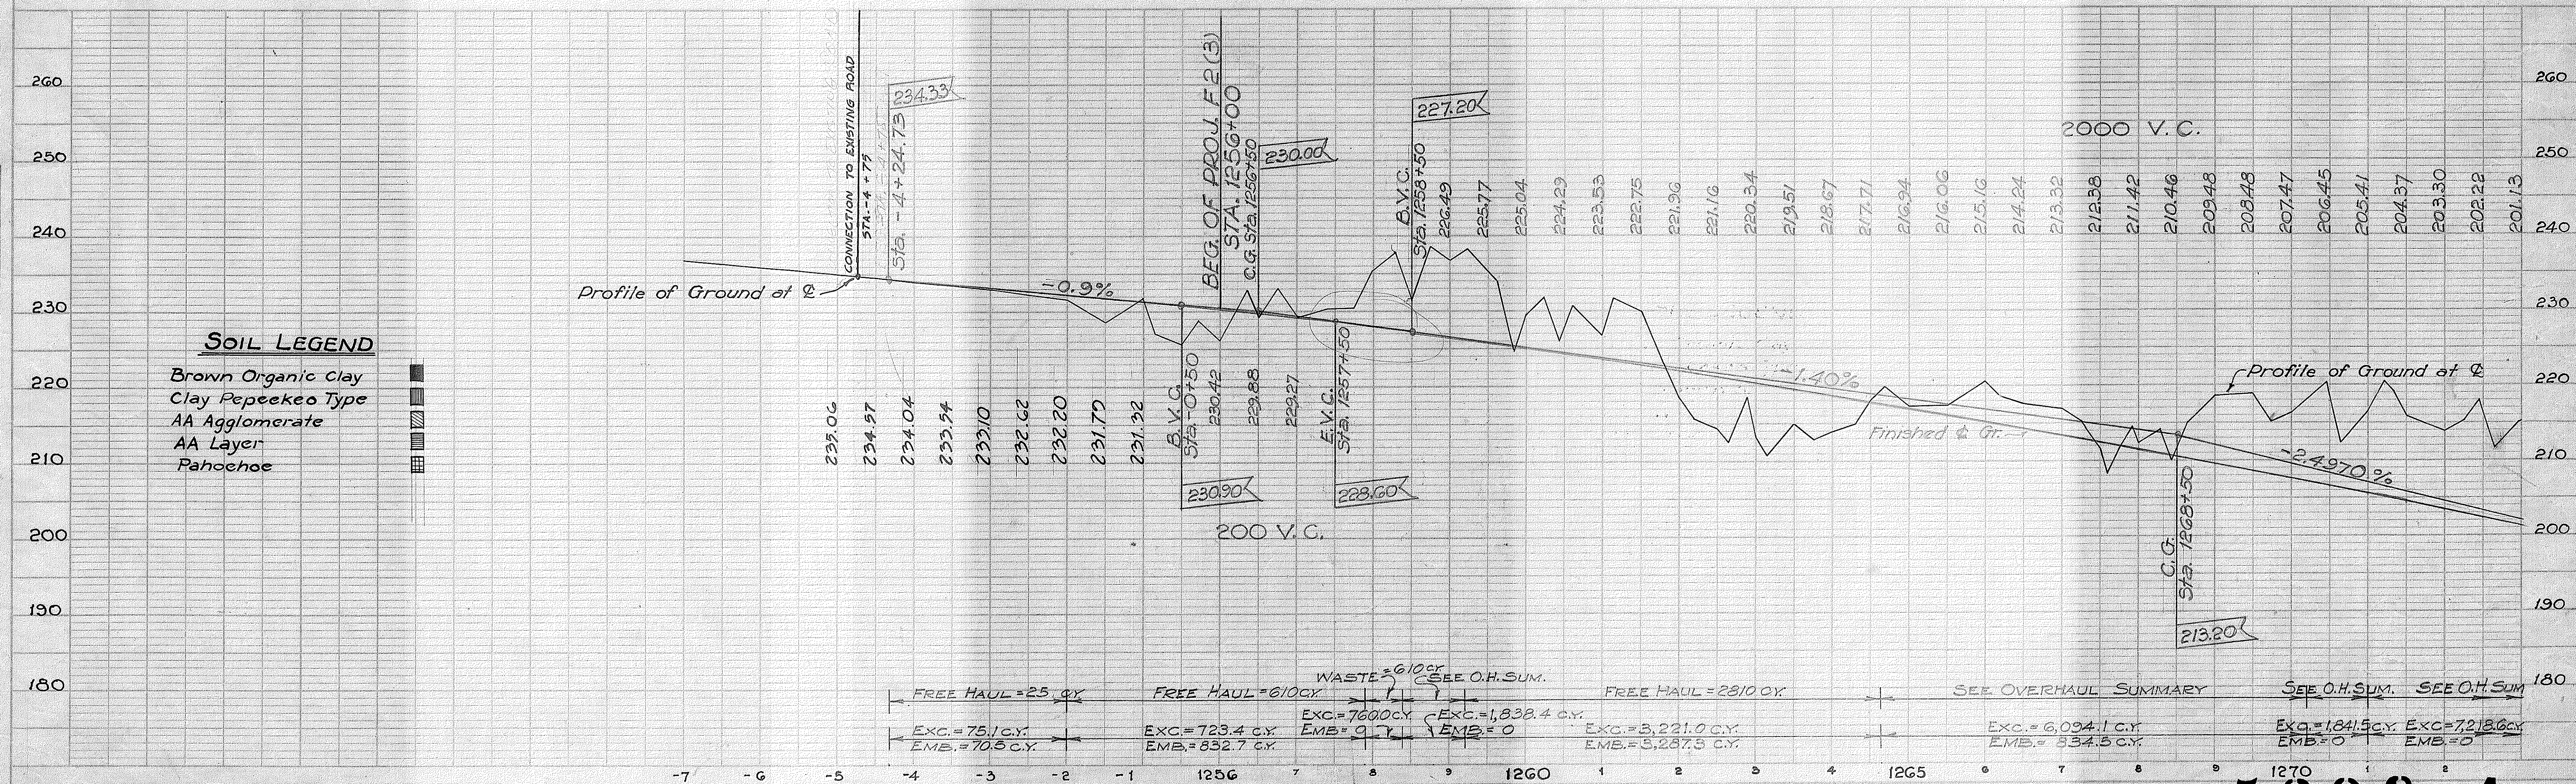


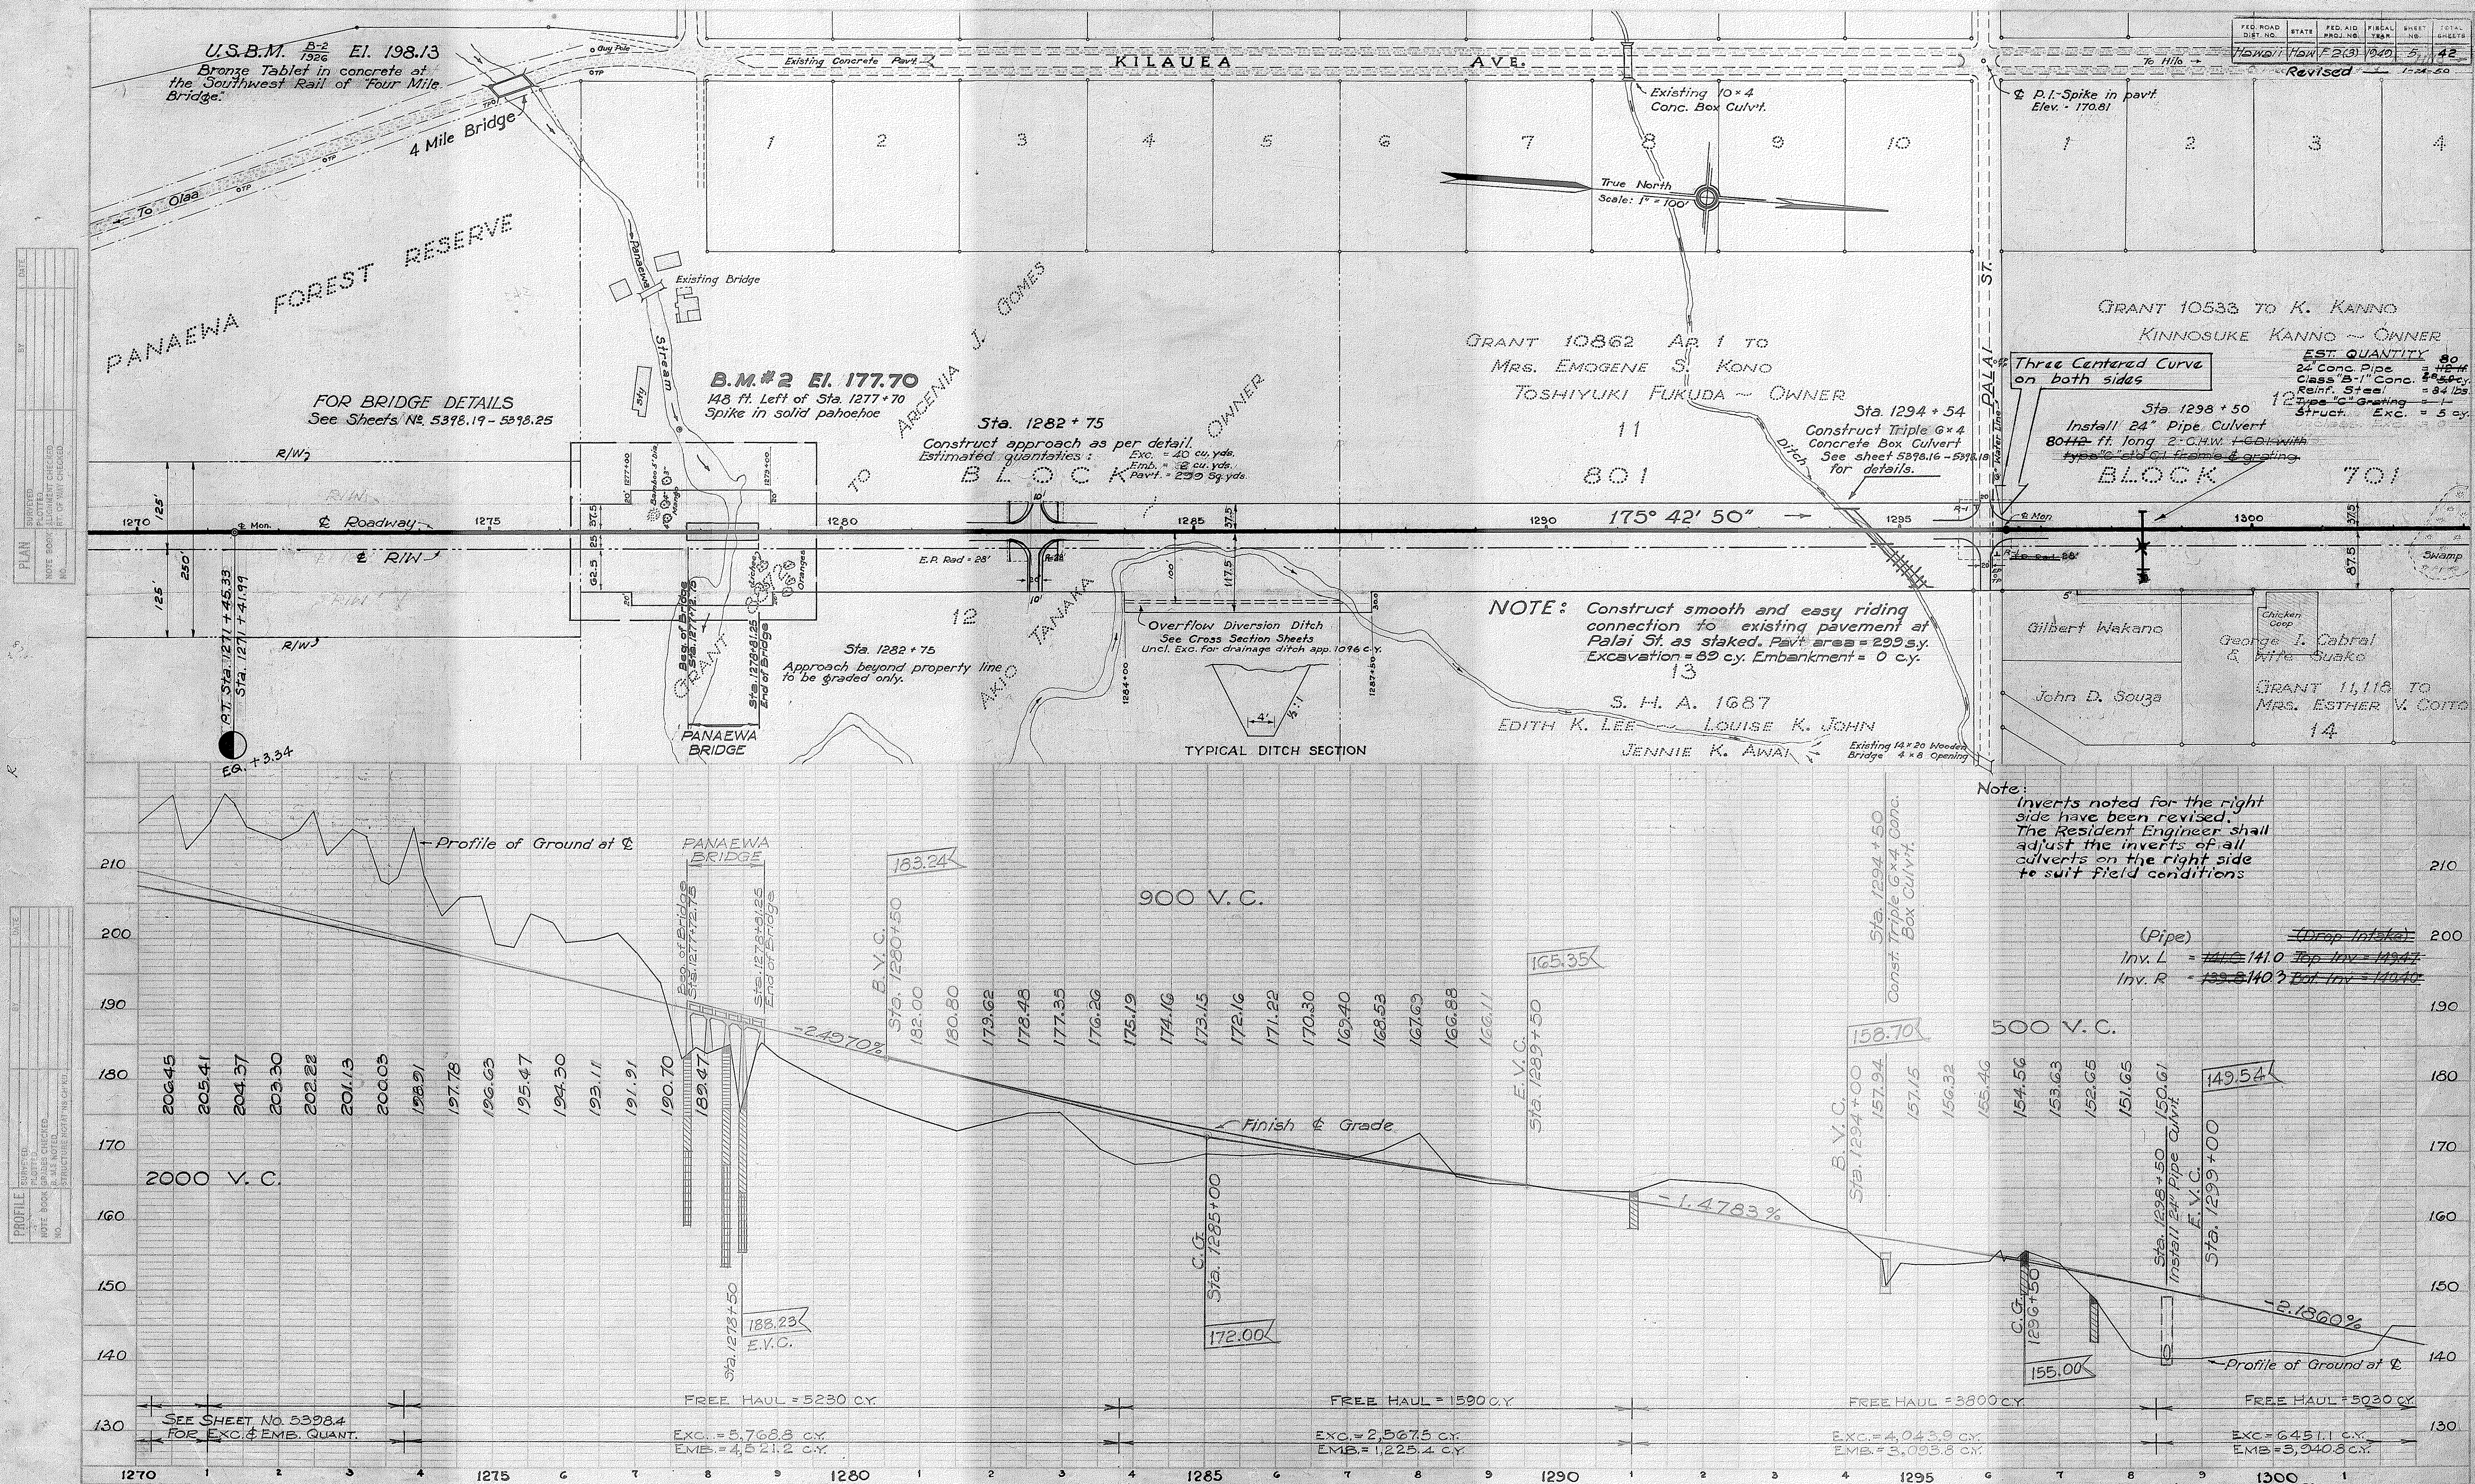

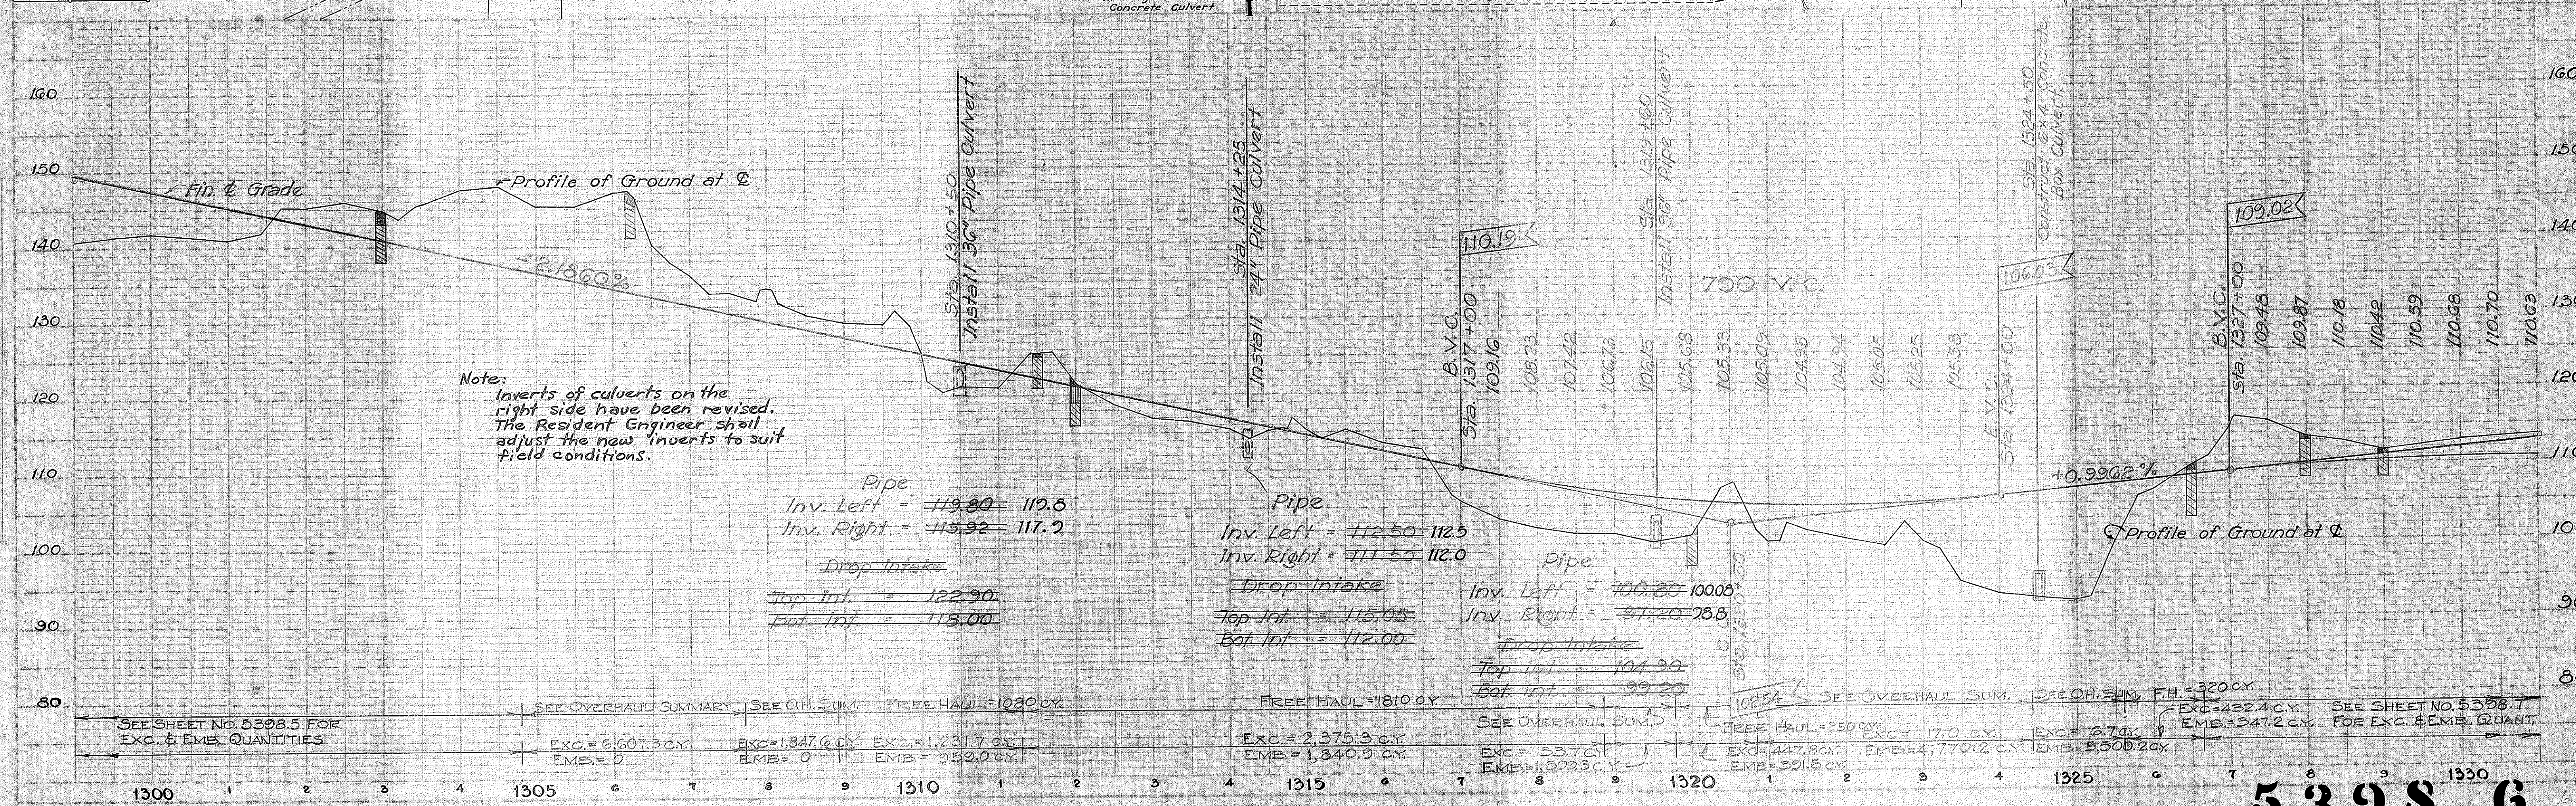

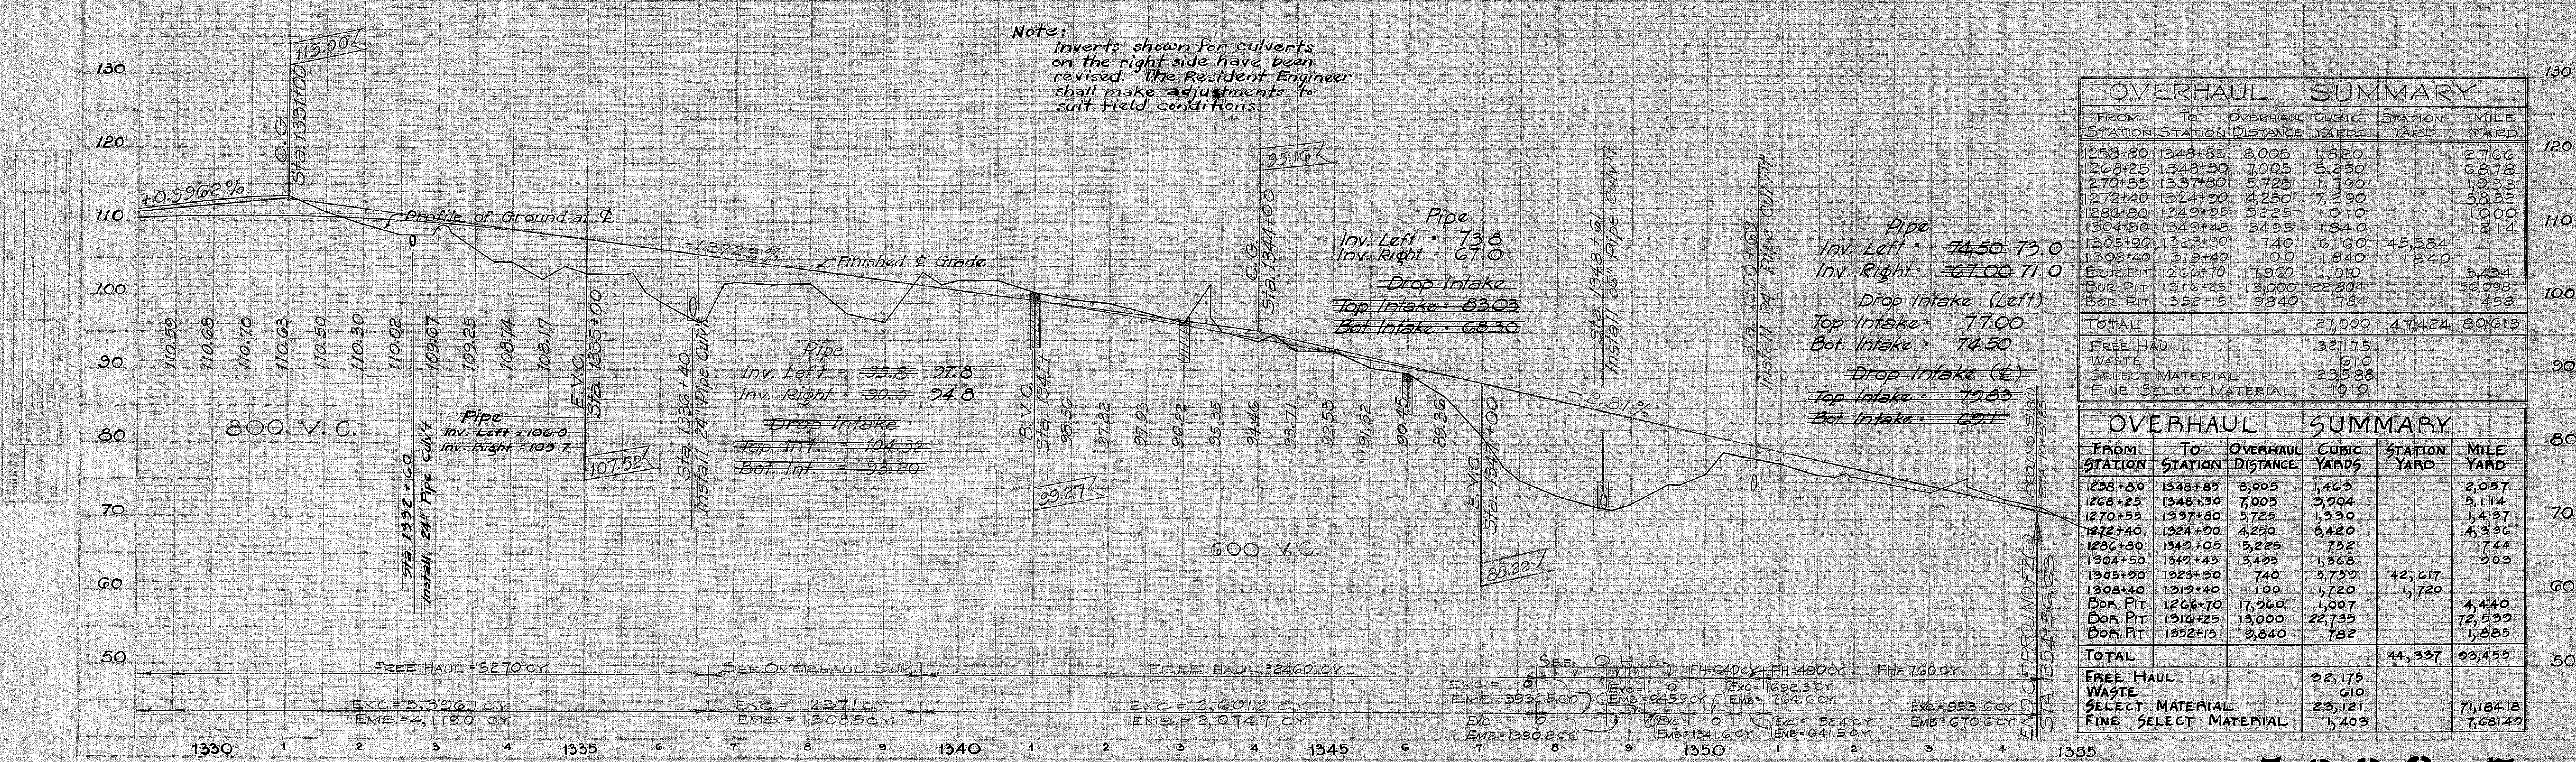

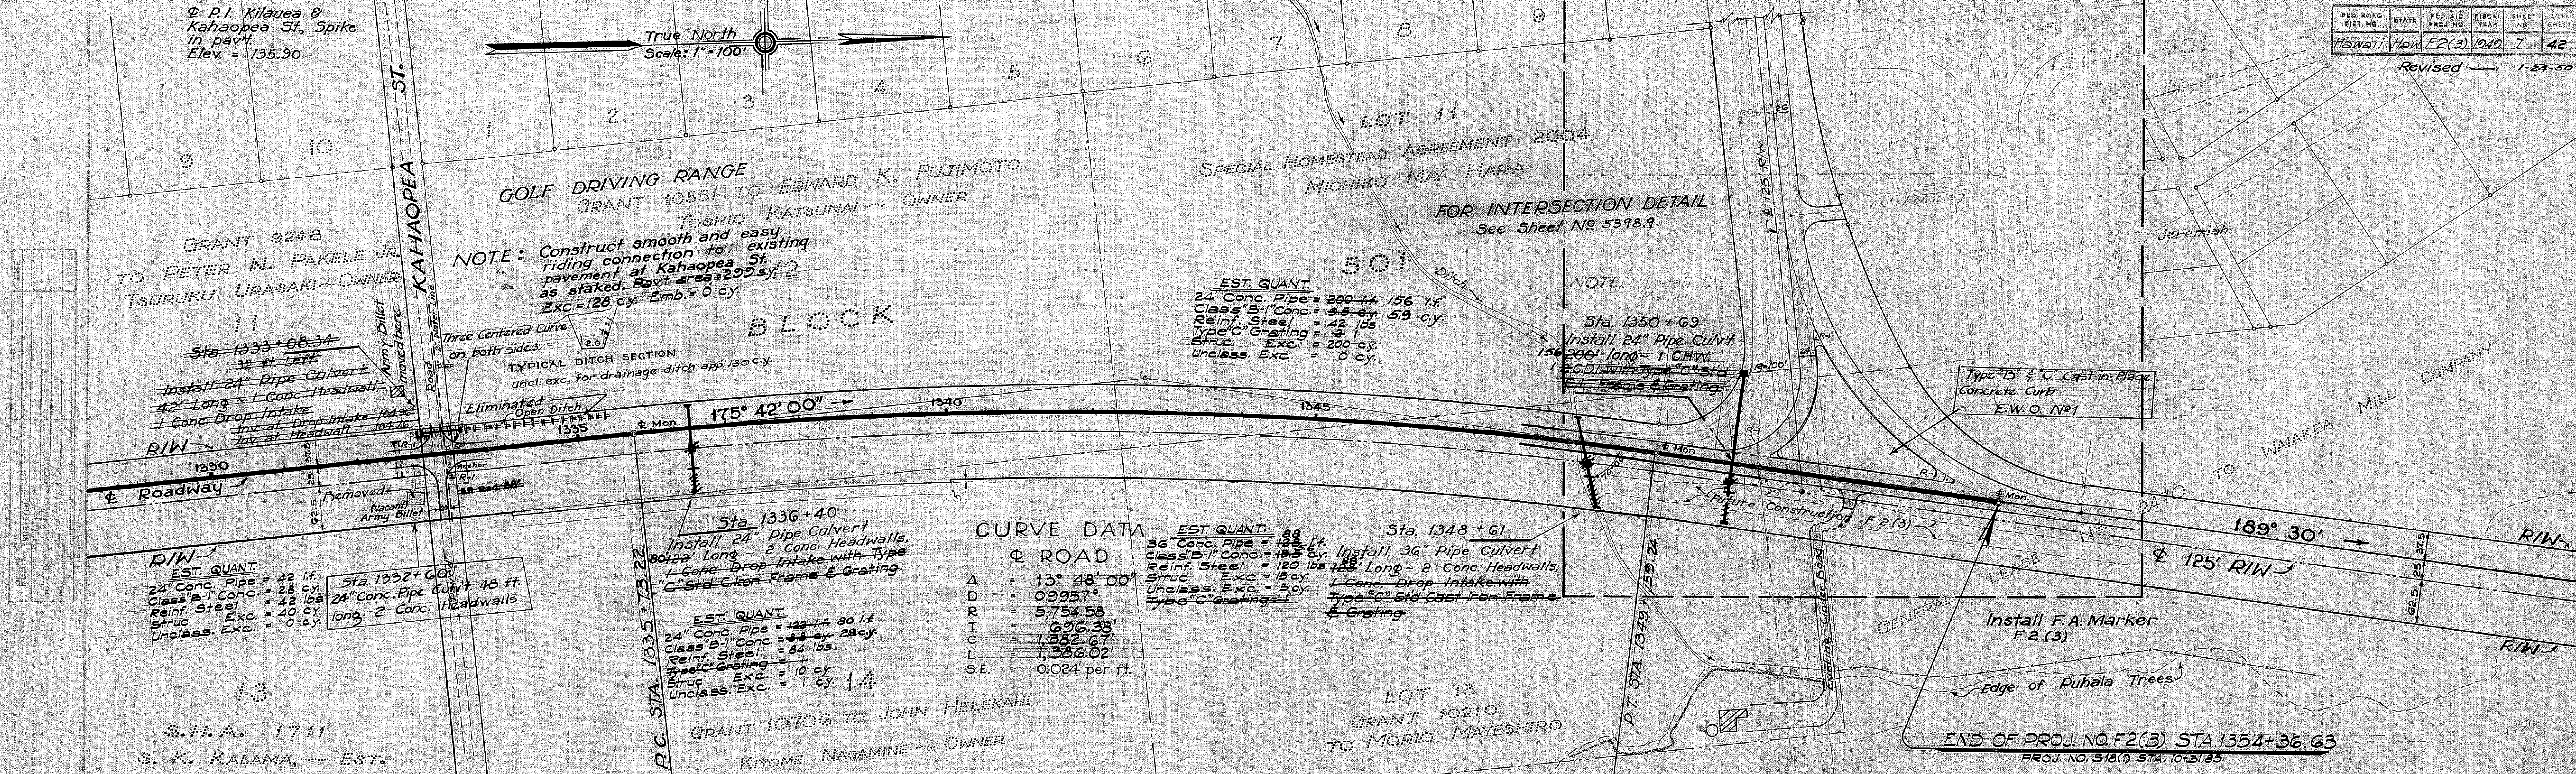

OVERHAUL SUMMARY					
FROM STATION	TO STATION	OVERHAUL DISTANCE	CUBIC YARDS	STATION YARD	MILE YARD
1258+80	1348+85	8,005	1,820		2,766
1268+25	1348+30	7,005	5,250		6,878
1270+55	1337+80	5,725	1,790		1,933
1272+40	1324+20	4,250	7,290		5,832
1286+80	1349+05	5,225	1,010		1,000
1304+50	1349+45	3,495	1,840		1,214
1305+90	1323+30	740	6,160	45,584	
1308+40	1319+40	100	1,840	1,840	
BOR. PIT	1266+70	17,960	1,010		3,434
BOR. PIT	1316+25	13,000	22,804		56,098
BOR. PIT	1352+15	9,840	784		1,458
TOTAL			27,000	47,424	89,613
FREE HAUL			32,175		
WASTE			610		
SELECT MATERIAL			23,588		
FINE SELECT MATERIAL			1010		

OVERHAUL SUMMARY					
FROM STATION	TO STATION	OVERHAUL DISTANCE	CUBIC YARDS	STATION YARD	MILE YARD
1258+80	1348+85	8,005	1,465		2,057
1268+25	1348+30	7,005	3,004		3,114
1270+55	1337+80	5,725	1,330		1,437
1272+40	1324+20	4,250	5,420		4,336
1286+80	1349+05	5,225	752		744
1304+50	1349+45	3,495	1,568		203
1305+90	1323+30	740	5,759	42,617	
1308+40	1319+40	100	1,720	1,720	
BOR. PIT	1266+70	17,960	1,007		4,440
BOR. PIT	1316+25	13,000	22,795		72,532
BOR. PIT	1352+15	9,840	782		1,885
TOTAL				44,337	93,455
FREE HAUL			32,175		
WASTE			610		
SELECT MATERIAL			23,121		71,184.18
FINE SELECT MATERIAL			1,403		7,681.42