FED. ROAD DIST. NO.	STATE	FED. AID PROJ. NO.	FISCAL YEAR	SHEET NO.	TOTAL SHEETS
HAWAII	HAW.	F 2 (3)	1940	1	42

INDEX TO DRAWINGS

SHEET	DESCRIPTION
1	Title Sheet
2	Typical Road Section
3	Detail Of Connections
4-7	Plan & Profile
8-9	Intersection Details
10-15A	Standard Details
16-18	Box Culvert Details
19	Std. Bridge Details
20-25	Bridge Details
26-42	Cross Sections

TERRITORY OF HAWAII

TERRITORIAL HIGHWAY DEPARTMENT

HONOLULU T.H.

PLANS OF

VOLCANO ROAD

FEDERAL AID PROJECT Nº. F 2 (3)

DISTRICT OF SOUTH HILO

ISLAND OF HAWAII

SCALES

PLAN		1 IN. = 100 FT.
PROFILE	HOR.	1 IN. = 100 FT.
	VERT.	1 IN. = 10 FT.
CROSS SECTION	HOR.	1 IN. = 10 FT.
	VERT.	1 IN. = 10 FT.

CONVENTIONAL SIGNS USED

- Centerline ——— 155
- Boundary Lines ——— ··· ——— ··· or, ———
- Fences (Noted) —x—x— or, —|—|—
- Existing Roadway ==========
- Box Culvert
- Circular Culvert
- Bridge
- Railroad +++++++++++++ or,
- Tree (Large) or,
- Telephone Pole ○TP
- Electric Line Pole ⊠EP
- Water Main W⁴—W⁵—
- Water Valve ⋈WV
- Water Valve Manhole ○WVH
- Storm Drain Manhole ○DMH
- Sewer Manhole ○SMH
- Fire Hydrant ♂FH
- Warning & Regulatory Signs ⊢ Type
- Centerline Monument ◎

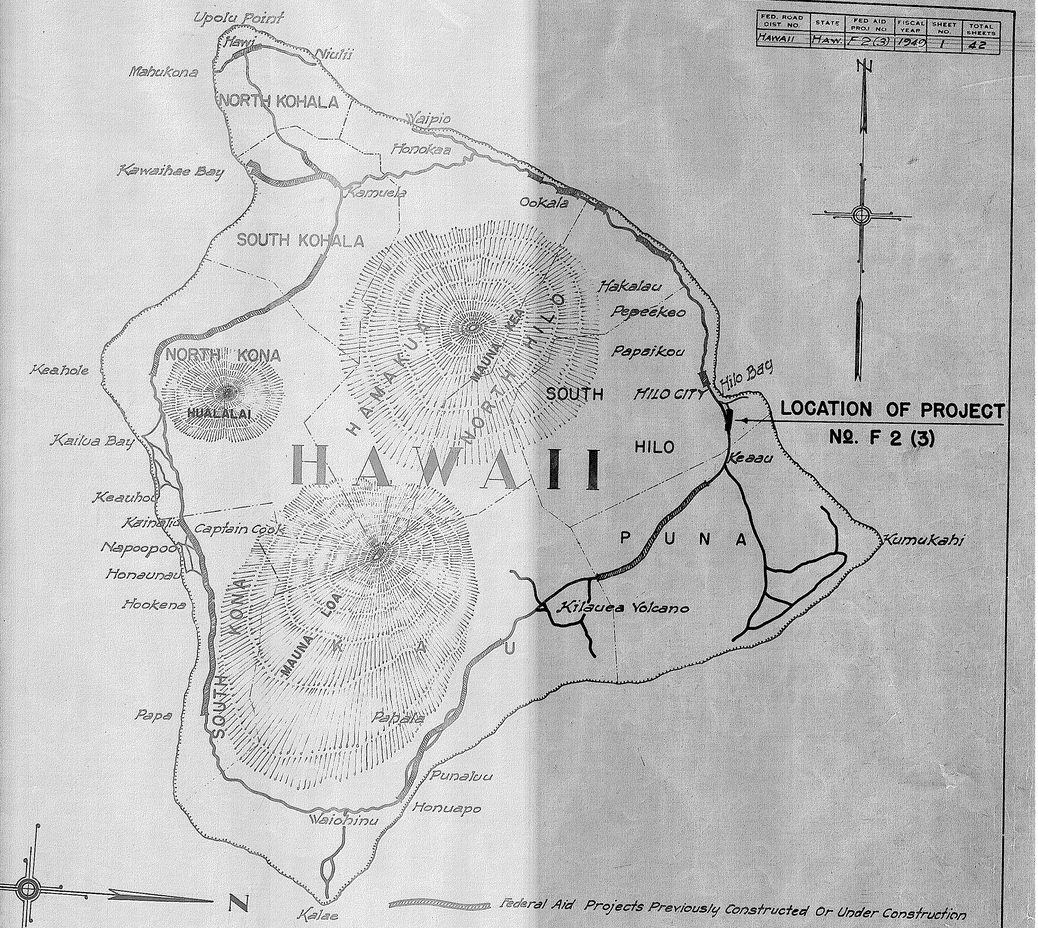

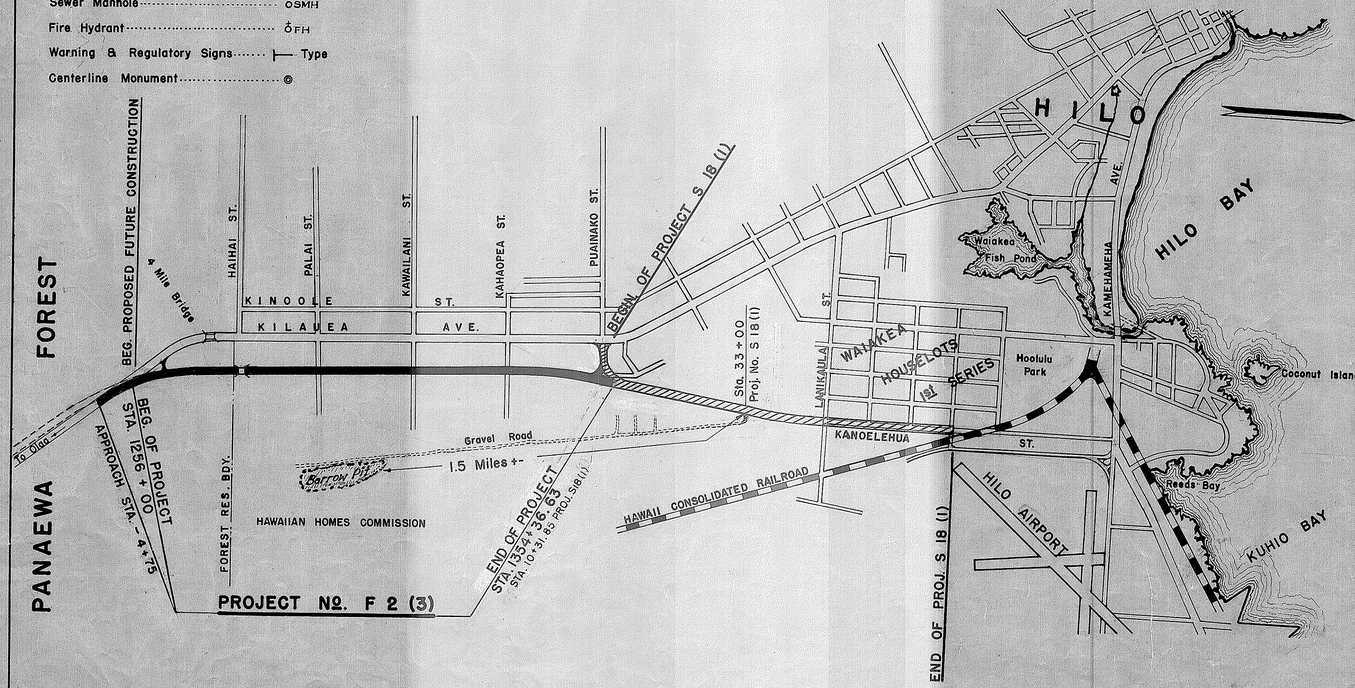

GENERAL LOCATION PLAN

Scale: 1 Inch = 1,760 Feet

Gross Length of Project 1.863 Miles.
Bridge: 0.020 Miles.
Net Length of Project: 1.843 Miles.

NOTE:

ALL CHANGES MADE DURING CONSTRUCTION HAVE BEEN NOTED IN RED ON THESE TRACINGS AND CHECKED BY:

E.K. Kaauwa
DISTRICT ENGINEER
3/21/61
DATE

RECOMMENDED FOR APPROVAL: DATE:

DISTRICT ENGINEER
PUBLIC ROADS ADMINISTRATION
FEDERAL WORKS AGENCY

APPROVED: DATE: 8-25-49

TERRITORIAL HIGHWAY ENGINEER

APPROVED: DATE:

DIVISION ENGINEER
PUBLIC ROADS ADMINISTRATION
FEDERAL WORKS AGENCY

		DATE
ORIGINAL PLAN	SURVEY PLOTTED BY	
	DESIGNED BY	
	TRACED BY	
NOTE BOOK	CHECKED BY	
	QUANTITIES (CHECKED BY)	
No.	CHECKED BY	

5398.1