FED. ROAD DIST. NO.	STATE	FED. AID PROJ. NO.	FISCAL YEAR	SHEET NO.	TOTAL SHEETS
HAWAII	HAW	BF011-1(3)	1959	1	75



STATE OF HAWAII
HAWAII STATE HIGHWAY DEPARTMENT
HONOLULU, OAHU, HAWAII

AS BUILT

PLANS OF

HAWAII BELT ROAD

FEDERAL AID PROJECT NO. BF011-1(3)

DISTRICTS OF SOUTH KONA & KAU

ISLAND OF HAWAII

·SCALES·

PLAN ..... 1 INCH = 100 FT.
PROFILE ..... HOR. 1 INCH = 100 FT.
VER. 1 INCH = 10 FT.
CROSS SECTION ..... HOR. 1 INCH = 10 FT.
VER. 1 INCH = 10 FT.

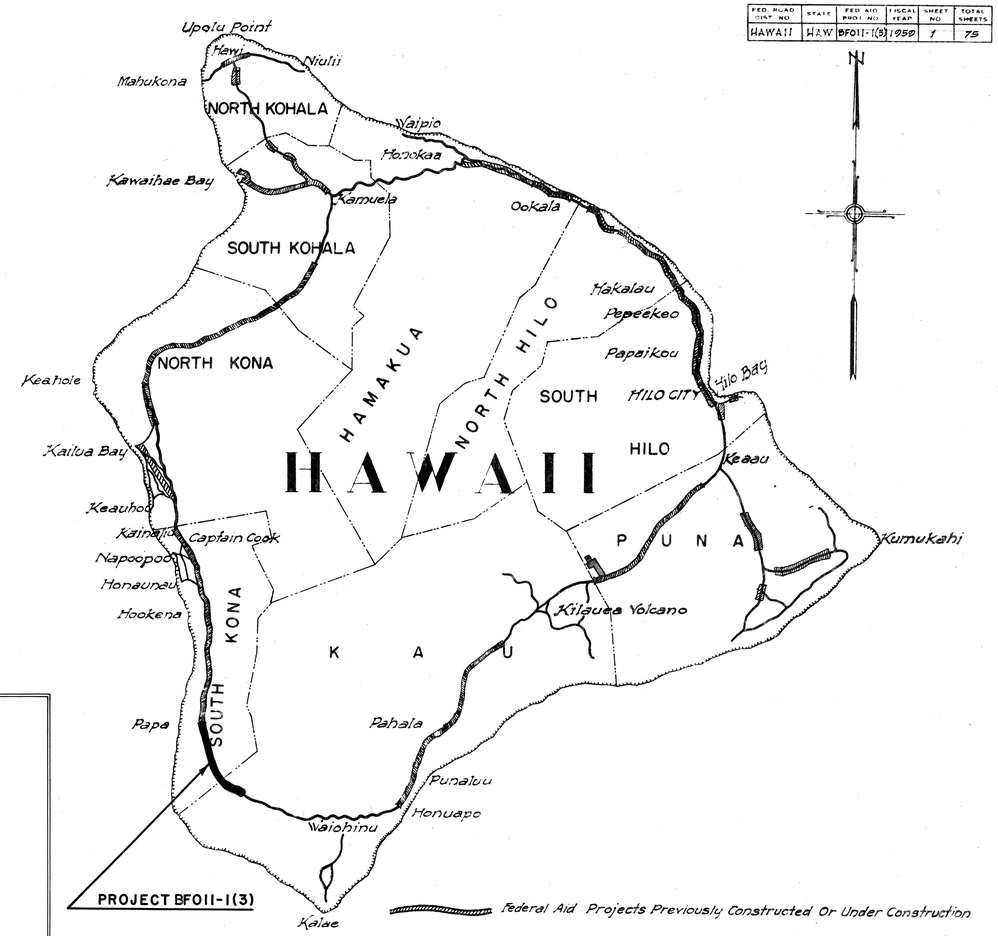

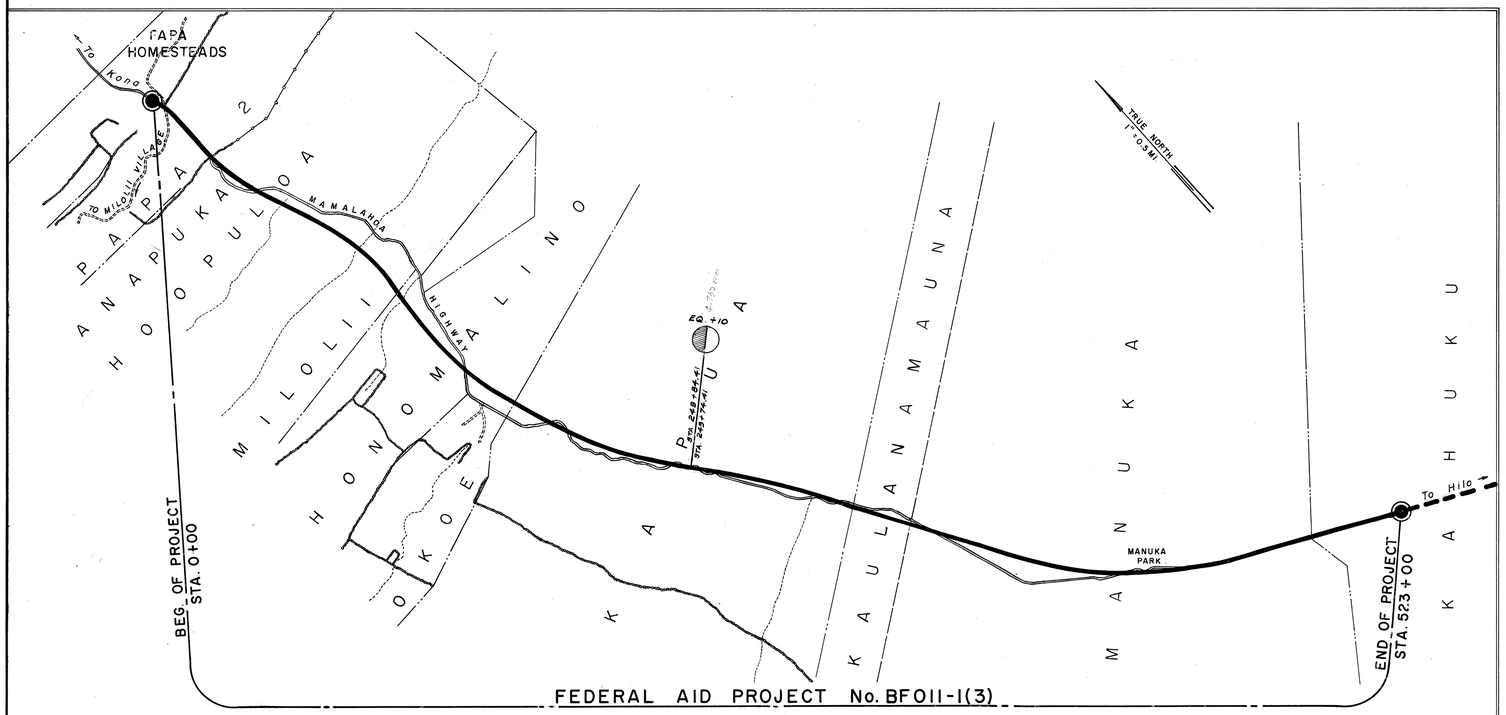

LOCATION PLAN

Gross & Net Length of Project 9.907 Miles

NOTE:
ALL CHANGES MADE DURING CONSTRUCTION HAVE BEEN NOTED IN RED ON THESE TRACINGS AND CHECKED BY:

S. Iwashita
PROJECT ENGINEER
Nov. 24, 1961
DATE

BELT, COLLINS & ASSOCIATES, LTD.
Civil Engineers — Honolulu, Hawaii

APPROVED: DATE 7/13/59
STATE HIGHWAY ENGINEER

DEPARTMENT OF COMMERCE
BUREAU OF PUBLIC ROADS
APPROVED:
DIVISION ENGINEER — DATE

ORIGINAL PLAN		DATE
	SURVEY PLOTTED BY	
	DESIGNED BY	
	DRAWN BY	
NOTE BOOK	TRACED BY	
	QUANTITIES BY	
No.	QUANTITIES CHECKED BY	
	CHECKED BY	

B. S. 3116. 1