FED. ROAD DIST. NO.	STATE	FED. AID PROJ. NO.	FISCAL YEAR	SHEET NO.	TOTAL SHEETS
HAWAII	HAW.	F-011-1(4)	1963	1	40

INDEX TO DRAWINGS

SHEET	DESCRIPTION
1	Title Sheet
2	Typical Sections
3-6	Plan and Profile
7	Detail of Connection at Sta. 0+00
8-9	Profile of Pipe Culverts
10-32	Cross Sections
33	Destination Signs
34-40	Standard Details

STATE OF HAWAII

DEPARTMENT OF TRANSPORTATION

HIGHWAYS DIVISION

"AS BUILT"

PLANS OF

HAWAII BELT ROAD

KAINALIU TO KEAUHOU

FEDERAL AID PROJECT NO. F-011-1(4)

DISTRICT OF NORTH KONA

ISLAND OF HAWAII

SCALES

PLAN ..... 1 INCH = 100 FT.
PROFILE ..... HOR. 1 INCH = 100 FT.
VER. 1 INCH = 10 FT.
CROSS SECTION ..... HOR. 1 INCH = 10 FT.
VER. 1 INCH = 10 FT.

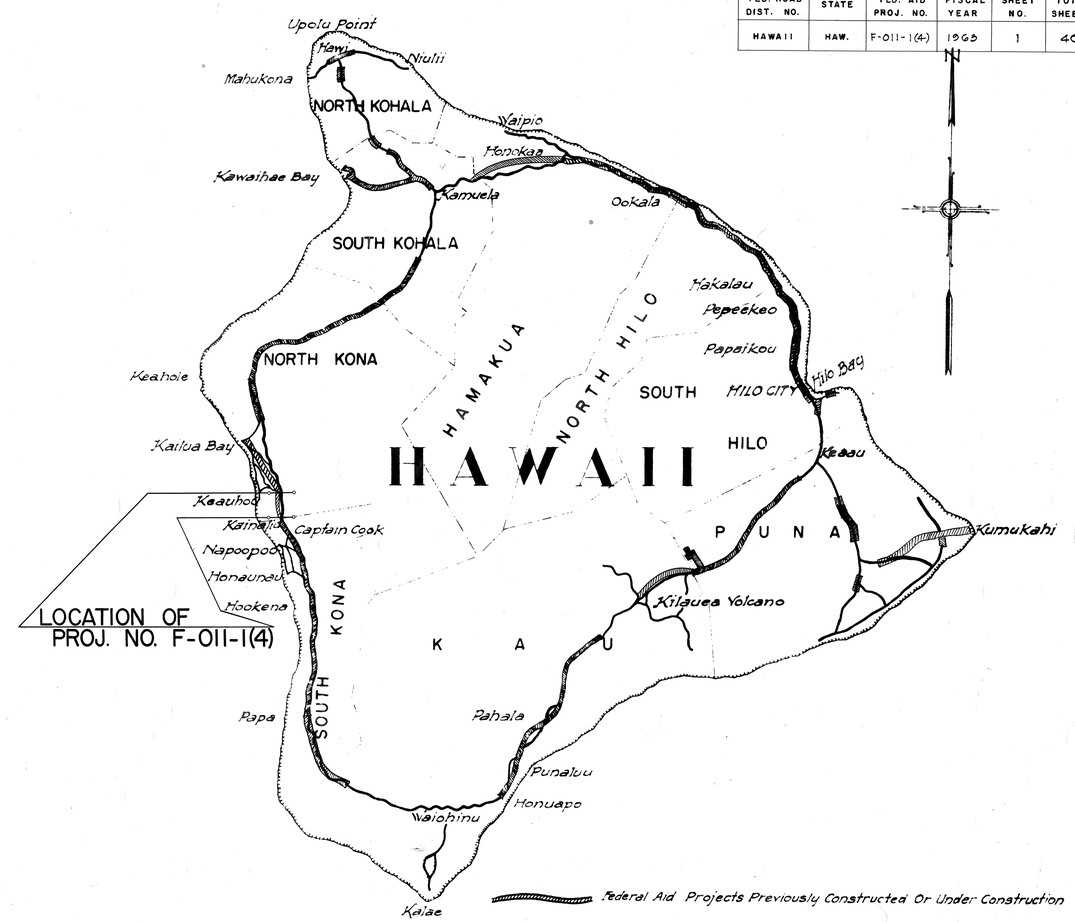

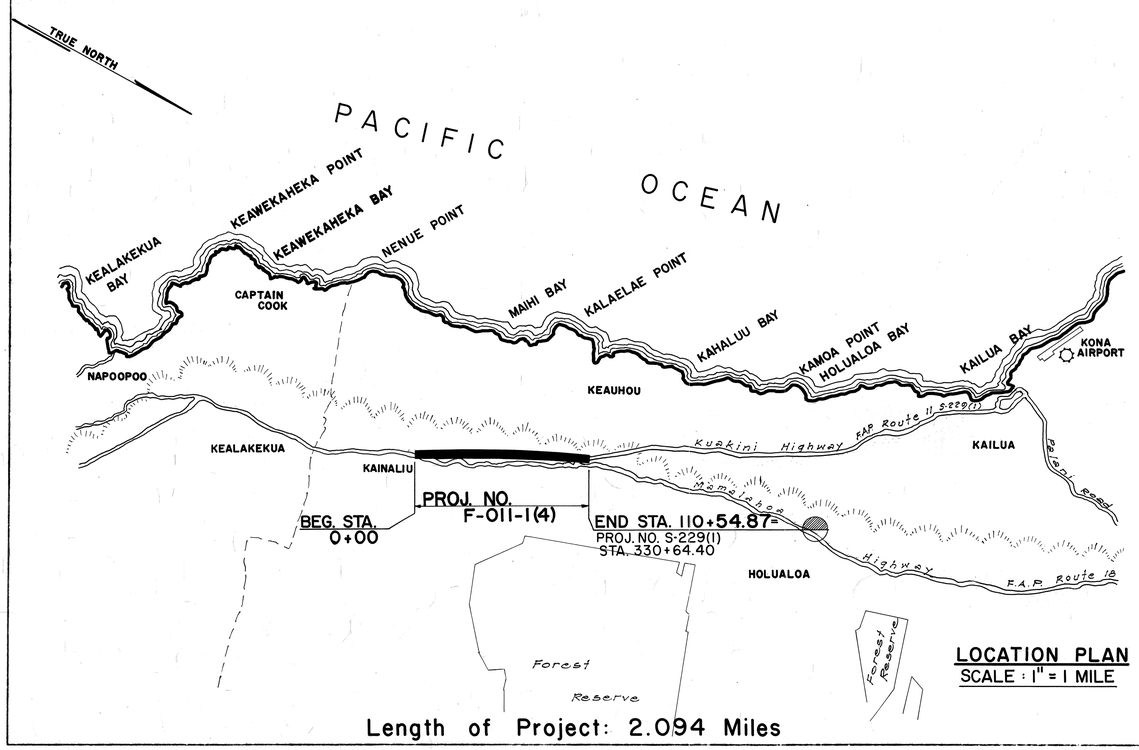

LOCATION PLAN
SCALE : 1" = 1 MILE

Length of Project: 2.094 Miles

DESIGN CLASSIFICATION

ADT (1962) 1610
Design ADT 5600
DHV ..... 12 %
D 60/40
T ..... 4 %
V ..... 60 MPH

NOTE:

ALL CHANGES MADE DURING CONSTRUCTION HAVE BEEN NOTED IN RED ON THESE SHEETS AND CHECKED BY:

Howard C. Ale
PROJECT ENGINEER

6/9/67
DATE

APPROVED: DATE 21 Nov 63
Jerio Watanabe
DIRECTOR OF TRANSPORTATION

DEPARTMENT OF COMMERCE
BUREAU OF PUBLIC ROADS
APPROVED:
[redacted]
DIVISION ENGINEER DATE

ORIGINAL PLAN	SURVEYS PLOTTED BY	DATE
	DESIGNED BY	
	TRACED BY	
	CHECKED BY	
SHEET NO.	QUANTITIES BY	
	QUANTITIES CHECKED BY	
	CHECKED BY	

2-1-8

F011104.1

DD-C-1-8