FED. ROAD DIST. NO.	STATE	FED. AID PROJ. NO.	FISCAL YEAR	SHEET NO.	TOTAL SHEETS
HAWAII	HAW.	IIA-01-67	1967	1	5

INDEX TO DRAWINGS	
SHEET	DESCRIPTION
1	TITLE SHEET
2	TYPICAL SECTIONS
3	CROSS SECTIONS
4-5	STANDARD DETAILS

STATE OF HAWAII

DEPARTMENT OF TRANSPORTATION

"AS BUILT"

PLANS FOR

CORRECTIVE PAVING AND RESURFACING OF A PORTION OF

KUAKINI HIGHWAY

(KAILUA - KEAUHOU ROAD)

PROJECT NO. IIA-01-67

DISTRICT OF NORTH KONA
ISLAND OF HAWAII

LOCATION OF PROJ. NO. IIA-01-67

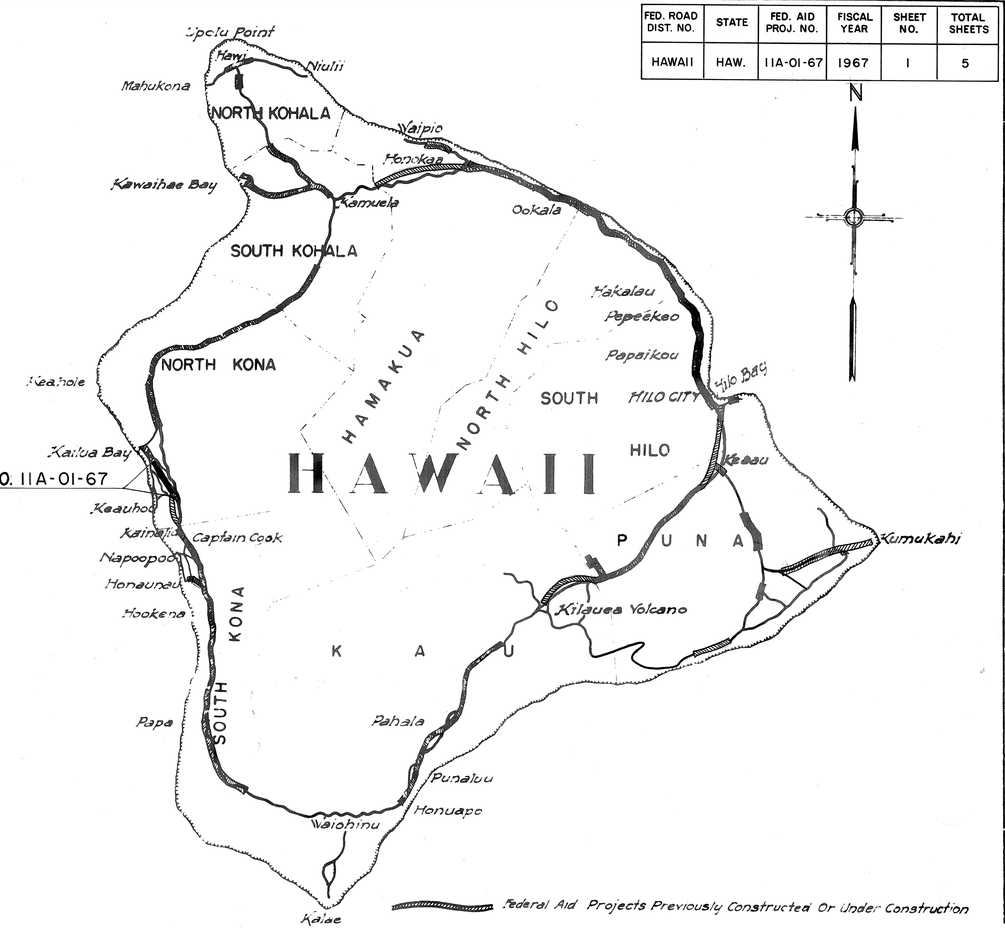

NOTE:

ALL CHANGES MADE DURING CONSTRUCTION HAVE BEEN NOTED IN RED ON THESE TRACINGS AND CHECKED BY:

Serge Krdani
PROJECT ENGINEER

DATE

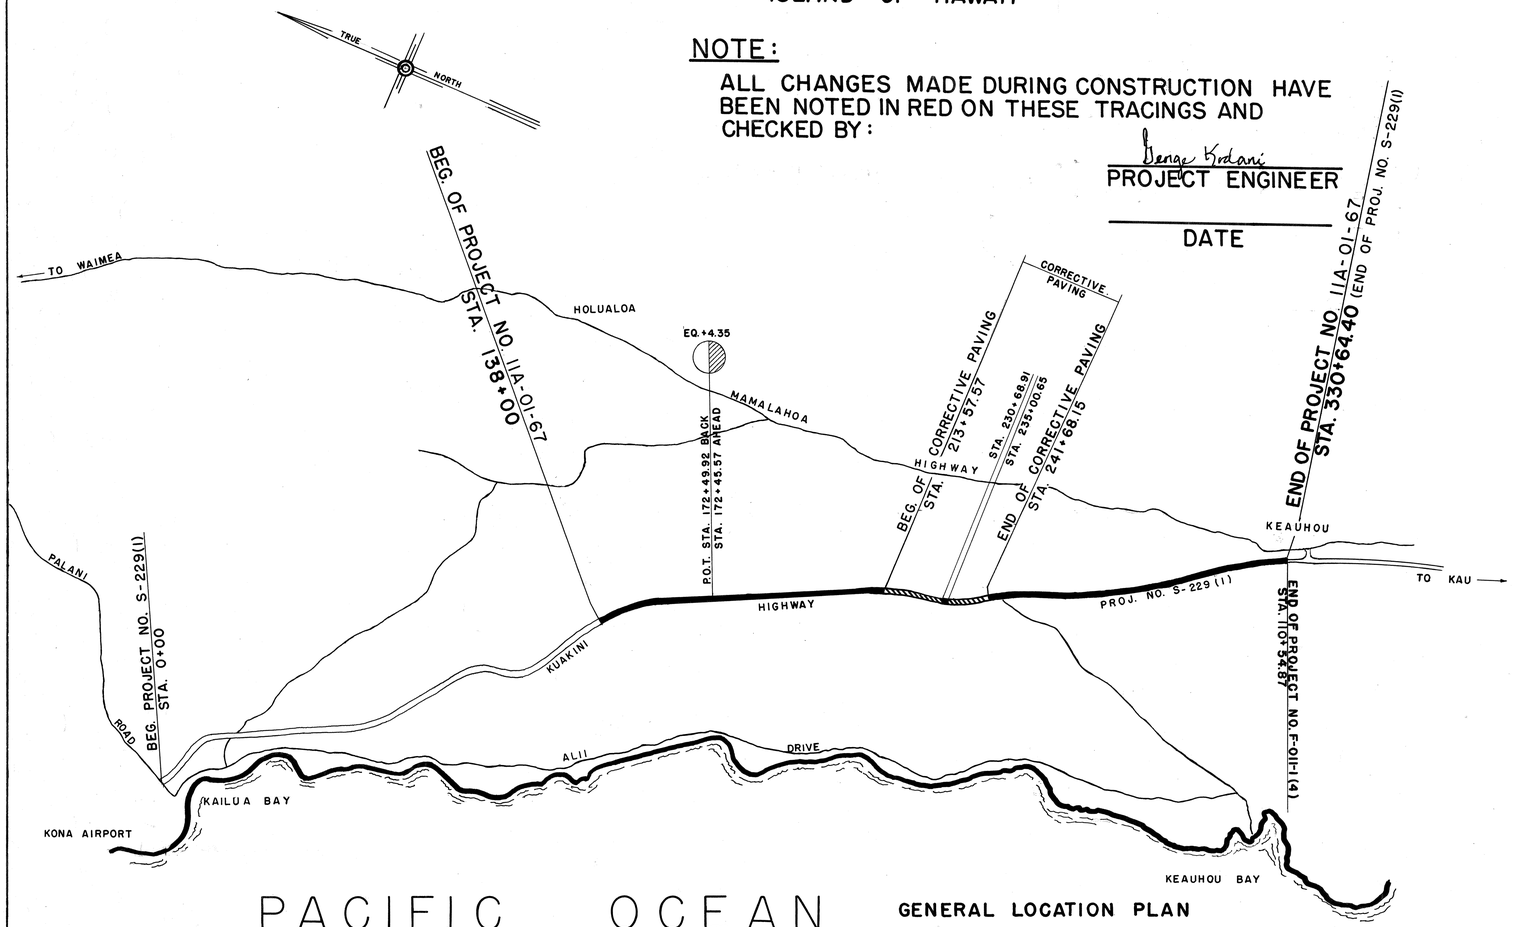

GENERAL LOCATION PLAN

SCALE: 1 INCH = 2000 FEET

LAYOUT OF PROJECT

CORRECTIVE PAVING LENGTH	0.450 MILES
RESURFACING LENGTH	3.199 MILES
GROSS LENGTH OF PROJECT	3.649 MILES

APPROVED: DATE 6-27-67

John W. M. Lee
for DIRECTOR OF TRANSPORTATION

ORIGINAL PLANS	SURVEY PLOTTED BY	DATE
	DESIGNED BY A. Maruyama	June '67
	TRACED BY	
	QUANTITIES BY	
NEW ROAD	QUANTITIES CHECKED BY	
	CHECKED BY	

C-1-6