FED. ROAD DIST. NO.	STATE	PROJ. NO.	FISCAL YEAR	SHEET NO.	TOTAL SHEETS
HAWAII	HAW.	11P-01-71	1971	1	12

INDEX TO DRAWINGS	
SHEET NO.	DESCRIPTION
1	TITLE SHEET
2	TYPICAL SECTION
3-7	PLANS
8-10	STANDARD AND MISC. DETAILS
11-12	CROSS SECTIONS

STATE OF HAWAII
DEPARTMENT OF TRANSPORTATION
HIGHWAYS DIVISION

"AS BUILT" PLANS FOR

RESURFACING OF KANOELEHUA AVENUE

MAKALIKA STREET TO KAMEHAMEHA AVENUE

PROJECT 11P-01-71

DISTRICT OF SOUTH HILO
ISLAND OF HAWAII

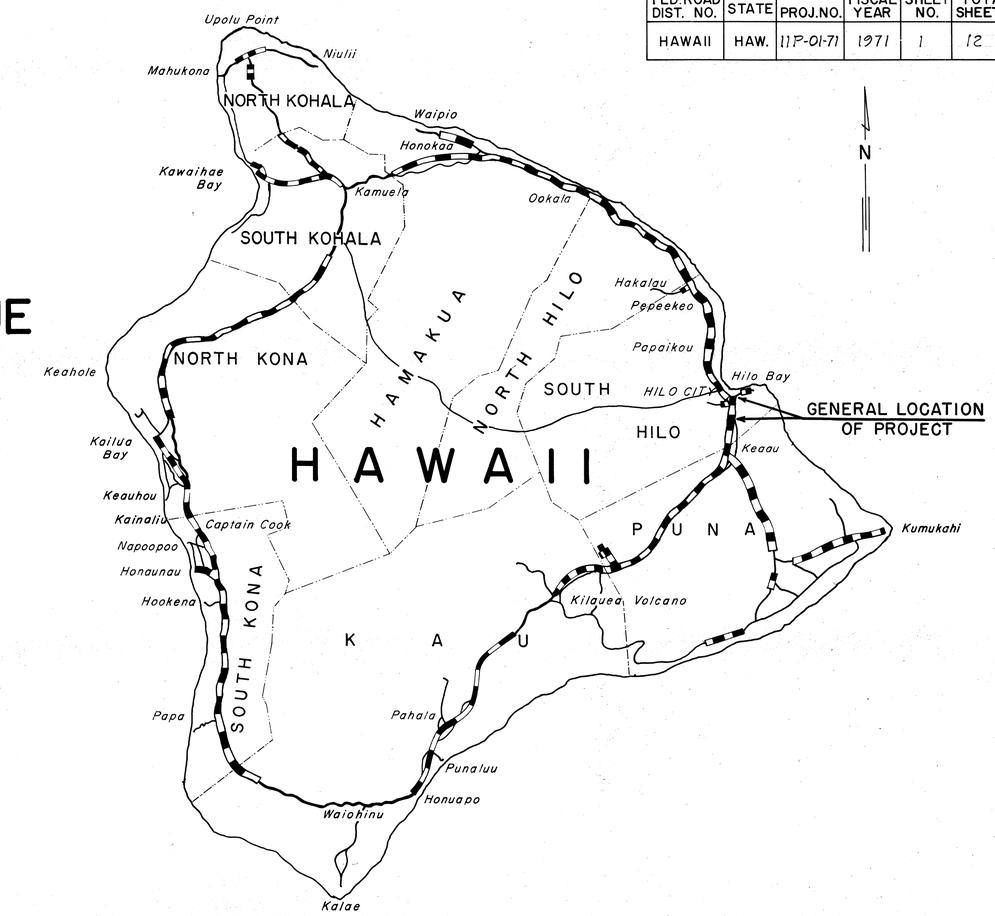

Federal Aid Projects Previously Constructed Or Under Construction

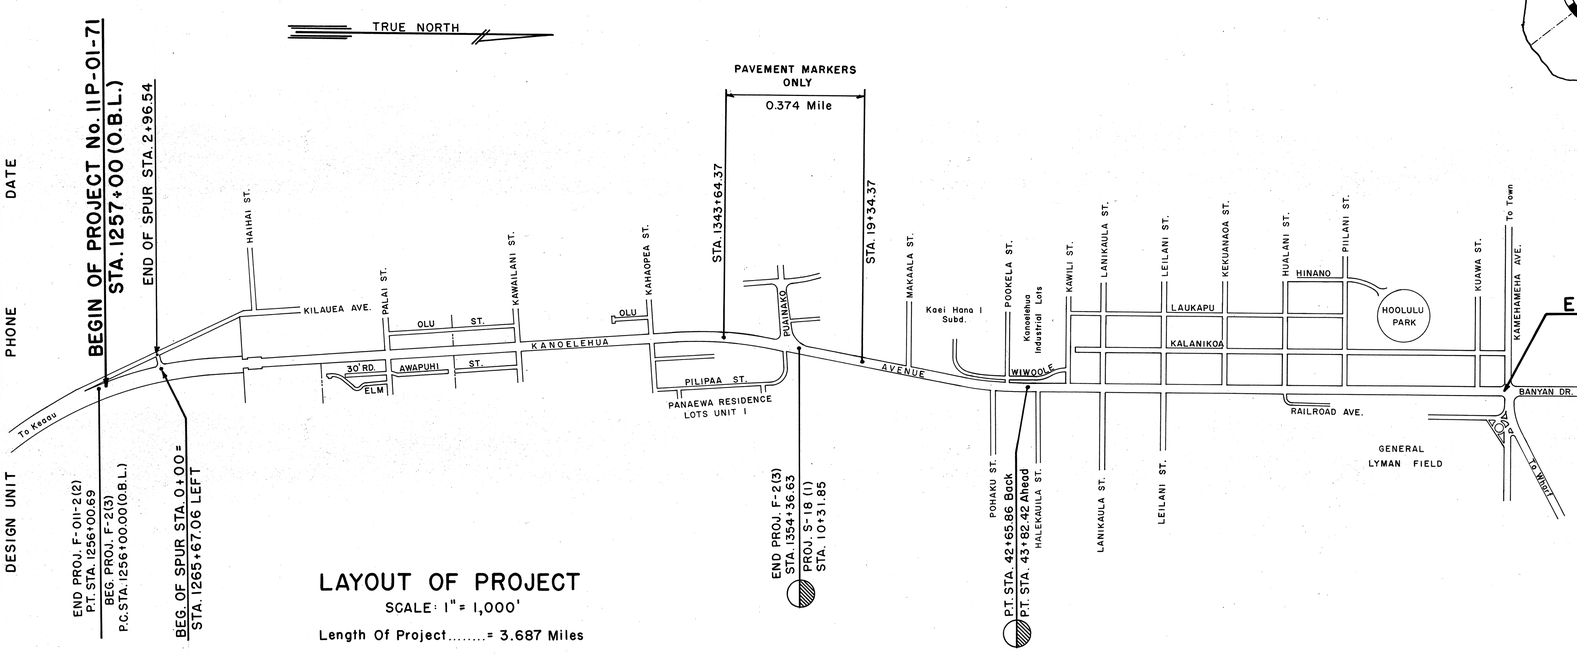

LAYOUT OF PROJECT

SCALE: 1" = 1,000'

Length Of Project.....= 3.687 Miles

DESIGNED BY: HAWAII DISTRICT
PS & E — R. Mikami — DESIGN UNIT
548-7534 — PHONE
Nov. 1971 — DATE

NOTE:

ALL CHANGES MADE DURING CONSTRUCTION HAVE BEEN INCORPORATED ON THESE PLANS EXCEPT CHANGES IN THE ORIGINAL THEORETICAL QUANTITIES:

Ernest Y. Ikawa
PROJECT ENGINEER
Aug. 28, 1972
DATE

DEPARTMENT OF TRANSPORTATION STATE OF HAWAII	
APPROVED:	
for E. Alvey Wright	11/23/71
DIR. OF TRANSPORTATION	DATE