FED. ROAD DIST. NO.	STATE	PROJ. NO.	FISCAL YEAR	SHEET NO.	TOTAL SHEETS
HAWAII	HAW.	IIC-01-69	1972	1	16

INDEX TO DRAWINGS	
SHEET NO.	DESCRIPTION
1	TITLE SHEET
2 - 7	LAVA FLOW NO. 1
8 - 9	LAVA FLOW NO. 2
10 - 15	STANDARD DETAILS
16	PROJECT INFORMATION SIGN

STATE OF HAWAII
DEPARTMENT OF TRANSPORTATION
HIGHWAYS DIVISION

"AS BUILT" PLANS FOR

DRAINAGE IMPROVEMENTS

ON

MAMALAHOA HIGHWAY

(LAVA FLOW NO. 1 STA. 14 + 75)
(LAVA FLOW NO. 2 STA. 14 + 82)
PROJ. NO. IIC-01-69

DISTRICT OF SOUTH KONA
ISLAND OF HAWAII

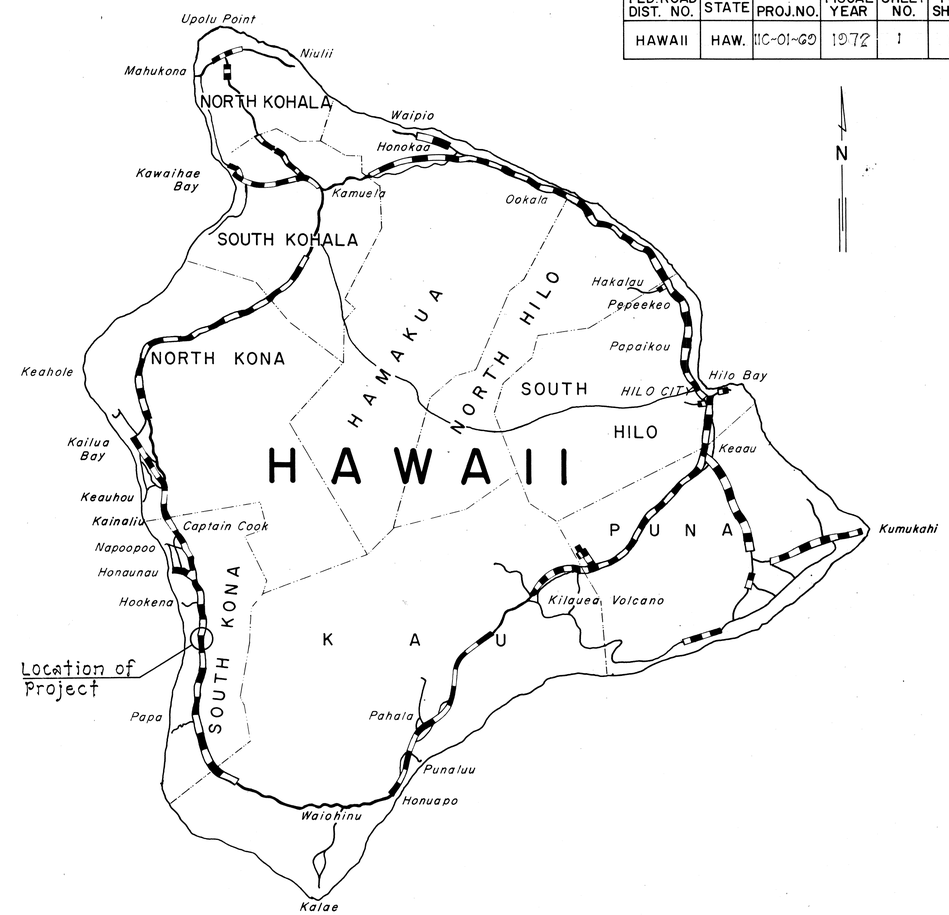

Federal Aid Projects Previously Constructed Or Under Construction

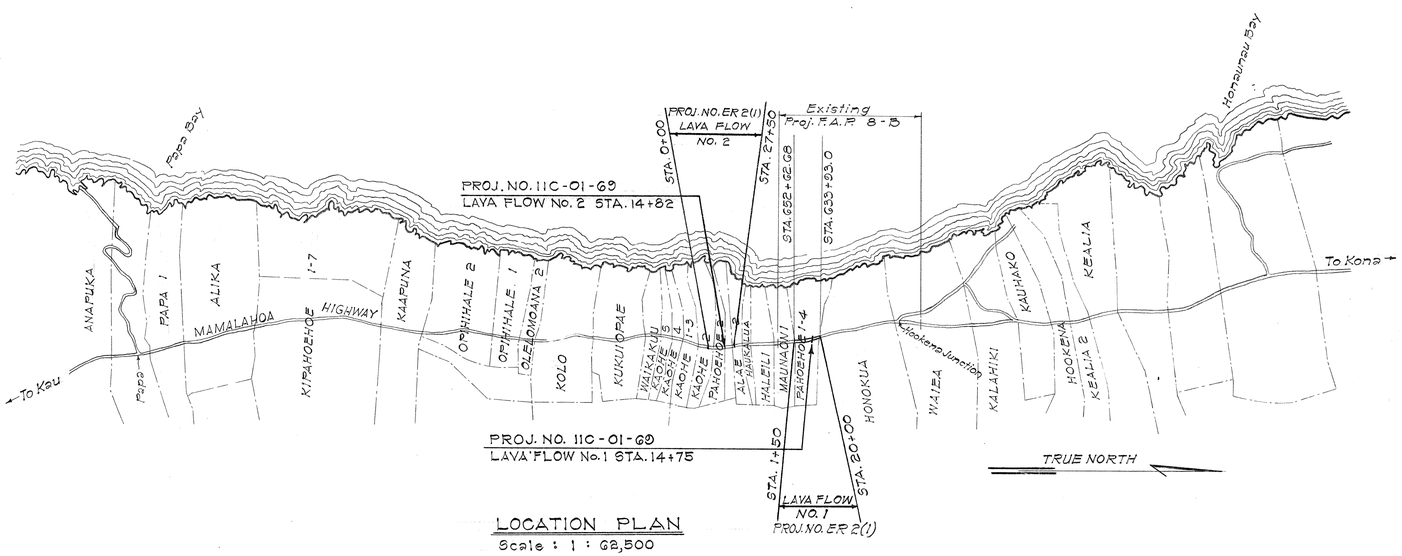

LOCATION PLAN
Scale : 1 : 62,500

NOTE:

ALL CHANGES MADE DURING CONSTRUCTION HAVE BEEN NOTED IN RED ON THESE TRACINGS AND CHECKED BY:

Carl Ajiboy
PROJECT ENGINEER

8/27/73
DATE

DEPARTMENT OF TRANSPORTATION STATE OF HAWAII	
APPROVED:	
Murray Lee	4/4/72
FOR DIR. OF TRANSPORTATION	DATE

DESIGNED BY: D. BEVIER Mar. 1972