FED. ROAD DIST. NO.	STATE	FED. AID PROJ. NO.	FISCAL YEAR	SHEET NO.	TOTAL SHEETS
HAWAII	HAW.	IIA-01-75 IIA-01-79M	1978	1	65

INDEX TO DRAWINGS

SHEET NO.	DESCRIPTION
PROJECT NO. IIA-01-75	
1	TITLE SHEET
2 - 3	TYP. SECT. & MISC. DETAILS
4 - 13	PLAN & PROFILE
14	SUPERELEVATION DIAGRAM
15 - 32	STANDARD DETAILS
33 - 60	CROSS SECTIONS
PROJECT NO. IIA-01-79M	
61	TYP. SECT. & MISC. DETAILS
62 - 65	PLANS
66	STANDARD DETAILS-B.C.T.

STATE OF HAWAII

DEPARTMENT OF TRANSPORTATION

LAND TRANSPORTATION FACILITIES DIVISION

"AS BUILT" PLANS FOR
CONSTRUCTION OF

KUAKINI HIGHWAY
TRUCK CLIMBING LANE, NORTH KONA
PROJECT NO. IIA-01-75

KUAKINI HIGHWAY RESURFACING
PROJECT NO. IIA-01-79M

DISTRICT OF NORTH KONA
ISLAND OF HAWAII

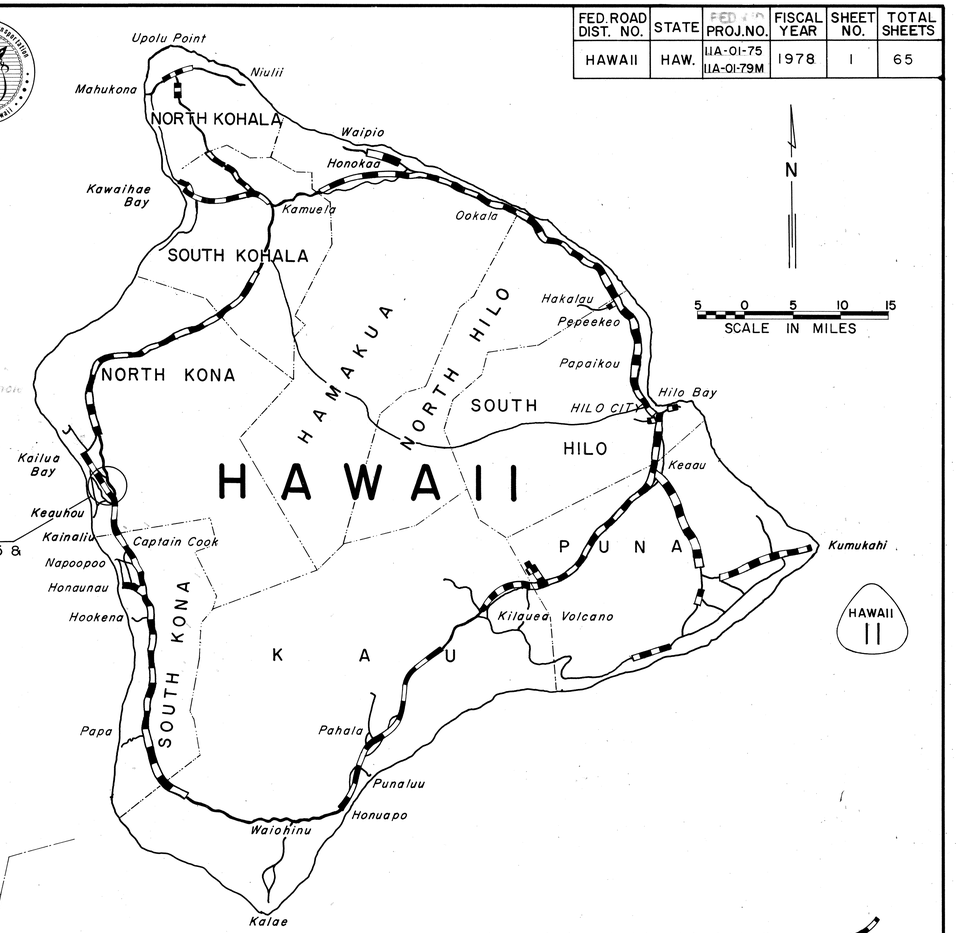

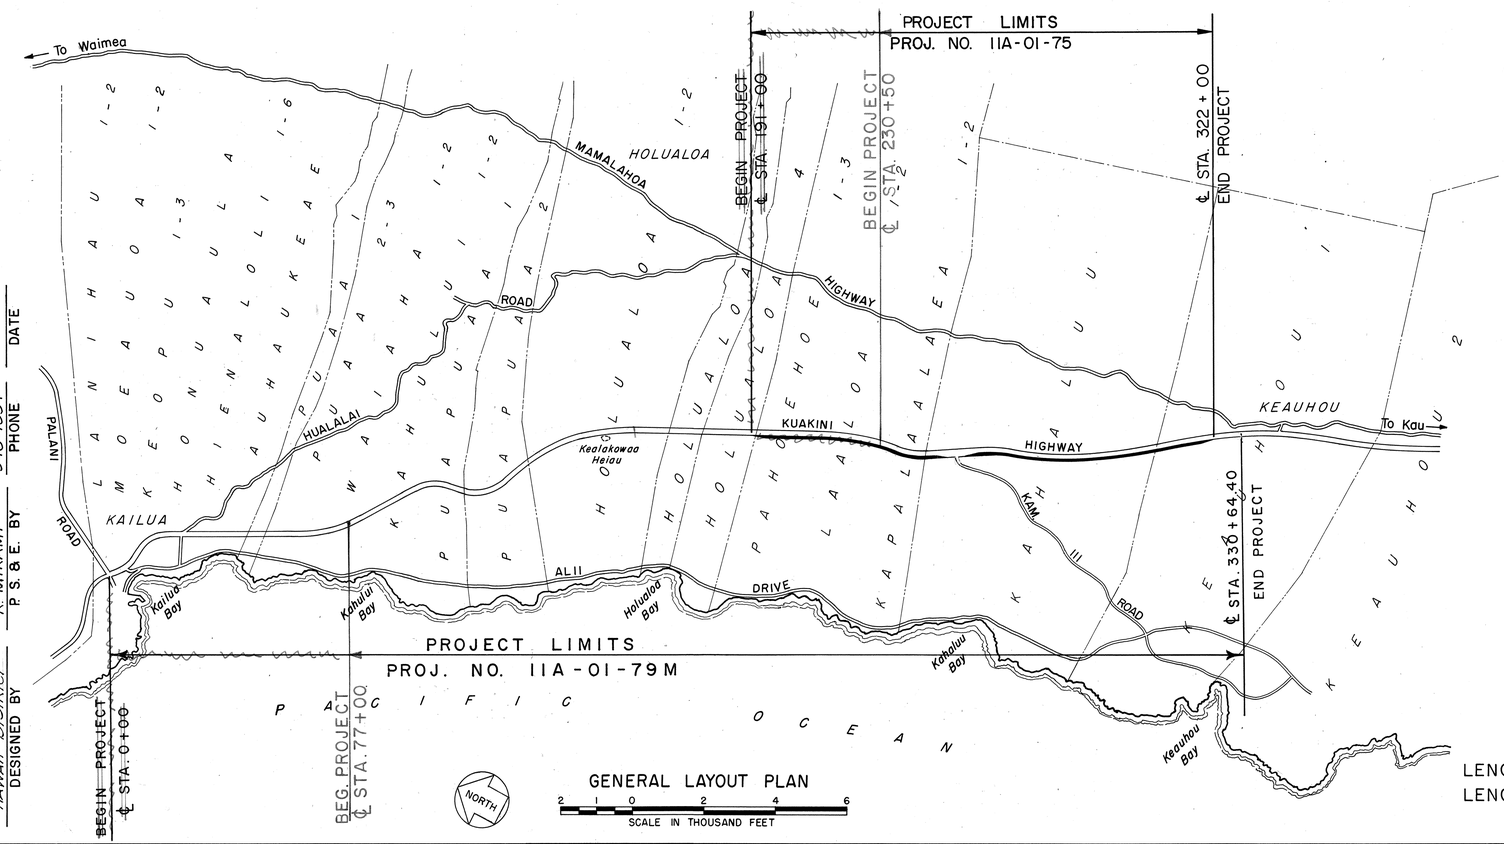

Federal Aid Projects Previously Constructed or Under Construction

ALL CHANGES MADE DURING CONSTRUCTION HAVE BEEN INCORPORATED ON THESE PLANS EXCEPT CHANGES IN THE ORIGINAL THEORETICAL QUANTITIES.

Floyd P.C. Lee Sr. — PROJECT ENGINEER — 11-28-79 DATE

DESIGN CLASSIFICATION

CURRENT ADT (1976)	7,520
DESIGN ADT (1996)	17,320
DHV	9.7%
D	60/40 (S/N)
T	3.5%
T_{24}	4.0%
V	60

LENGTH OF PROJECT NO. IIA-01-75 ..... ~~2.462~~ 1.733 Mi.
LENGTH OF PROJECT NO. IIA-01-79M ..... ~~6.262~~ 4.804 Mi.

DEPARTMENT OF TRANSPORTATION
STATE OF HAWAII
APPROVED:
Ryokichi Higashionna — DIR. OF TRANSPORTATION — 5/31/78 DATE

HAWAII DISTRICT
DESIGNED BY R. MIKAMI P.S.&E. BY 548-7534 PHONE DATE