FED. ROAD DIST. NO.	STATE	PROJ. NO.	FISCAL YEAR	SHEET NO.	TOTAL SHEETS
HAWAII	HAW.	IIJK-01-84M	1984	1	14

INDEX TO DRAWINGS

SHEET NO.	DESCRIPTION
1	TITLE SHEET
2	TYPICAL SECTIONS
3	PAVEMENT RECONSTRUCTION
	DETAILS & SCHEDULE
4	ROADWAY SITE
5-10	CROSS SECTIONS AND PAVEMENT
	PROFILES
11-14	STANDARD DETAILS

STATE OF HAWAII

DEPARTMENT OF TRANSPORTATION

HIGHWAYS DIVISION

"AS-BUILT"

PLANS FOR

VOLCANO ROAD

REPAIRS TO EARTHQUAKE DAMAGES

Hawaii Volcanoes National Park Section

PROJECT NO. IIJK-01-84M

DISTRICT OF KAU

ISLAND OF HAWAII

CONTRACTOR : YAMADA & SONS, INC.

CONTRACT NO. : 17577

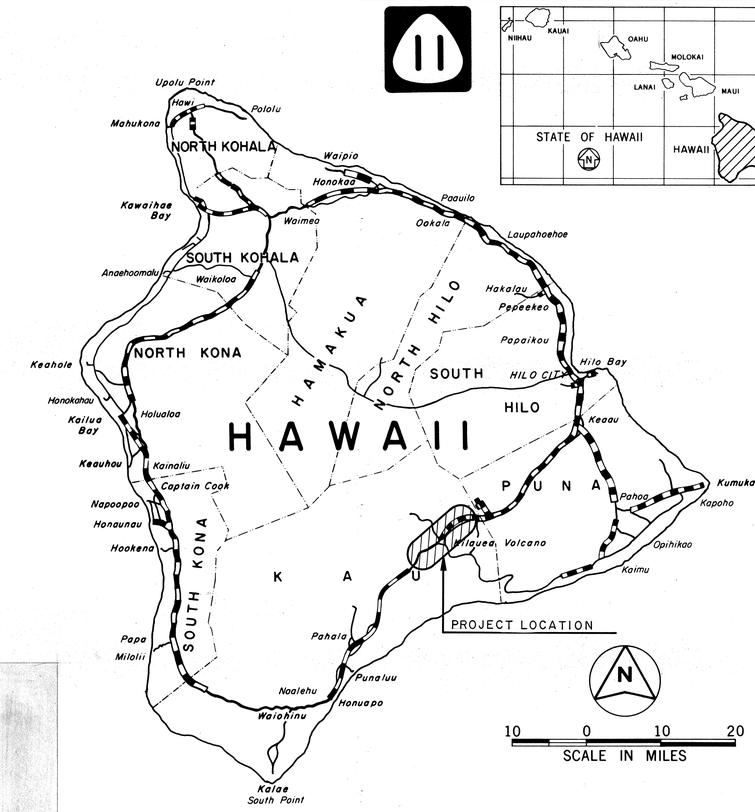

FEDERAL AID PROJECTS PREVIOUSLY CONSTRUCTED OR UNDER CONSTRUCTION

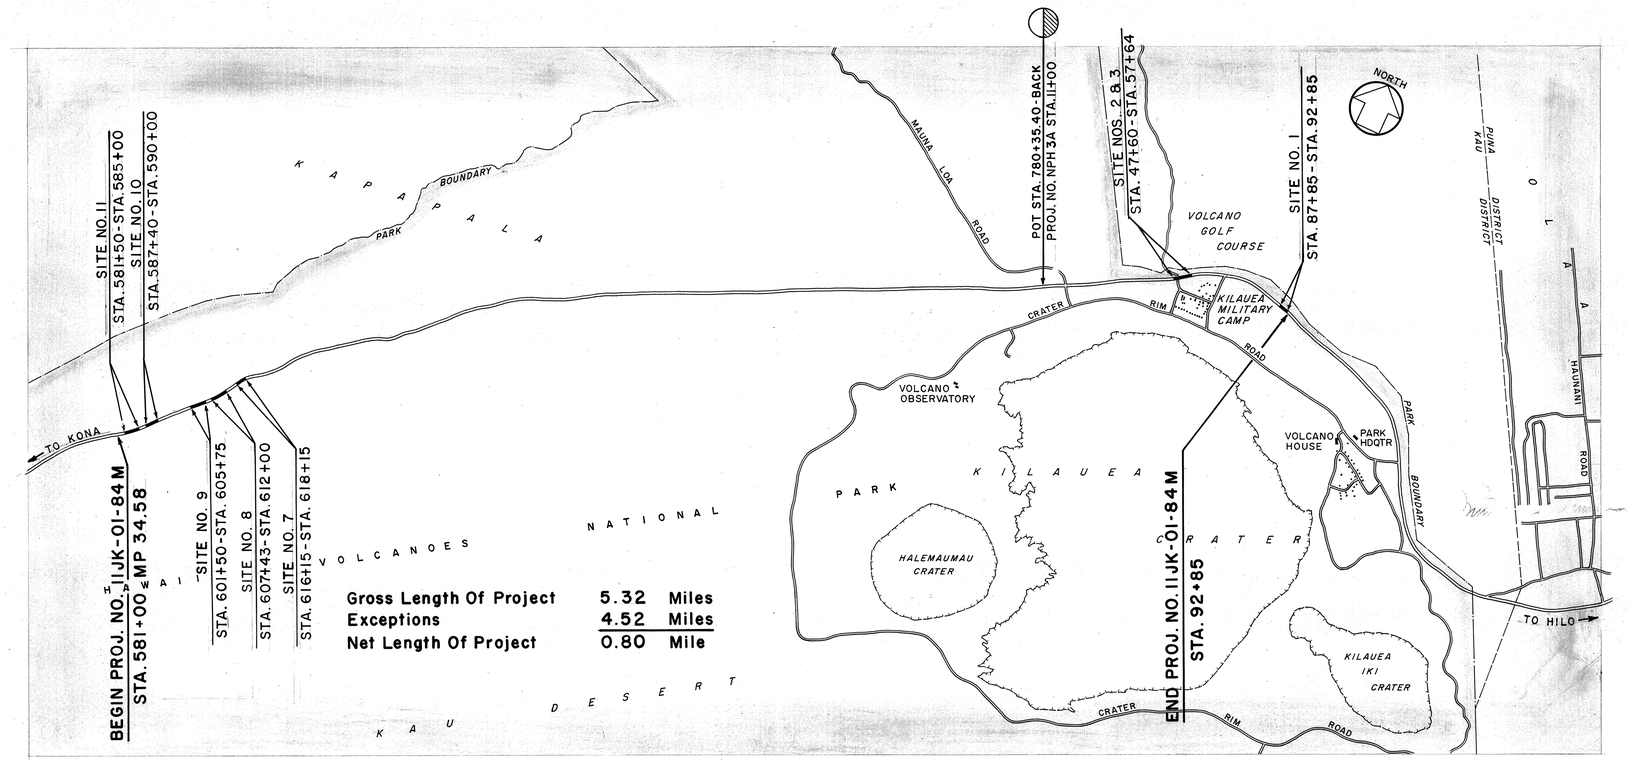

GENERAL LOCATION PLAN

CHANGES MADE DURING CONSTRUCTION HAVE BEEN INCORPORATED ON THESE PLANS EXCEPT CHANGES IN THE ORIGINAL THEORETICAL QUANTITIES. FOR ACTUAL QUANTITIES, REFER TO PROJECT LEDGER AND/OR COMPUTATION BOOK.

RESIDENT ENGINEER — DATE 10-10-85

HAWAII DISTRICT	HAWAII DISTRICT	935-3347	MAY, 1984
DESIGNED BY	P. S. & E. BY	PHONE	DATE

DEPARTMENT OF TRANSPORTATION
STATE OF HAWAII

APPROVED:

Cheryl D. Soon — 5/22/84

DIR. OF TRANSPORTATION — DATE

C-1-5