FED. ROAD DIST. NO.	STATE	PROJ. NO.	FISCAL YEAR	SHEET NO.	TOTAL SHEETS
HAWAII	HAW.	11N-01-07M	2008	1	29

11

STATE OF HAWAII

DEPARTMENT OF TRANSPORTATION

HIGHWAYS DIVISION

HONOLULU, HAWAII

"AS-BUILT"

PLANS FOR

VOLCANO ROAD

PAVEMENT PREVENTIVE MAINTENANCE, OUTBOUND LANES KEA'AU BYPASS ROAD TO PANAEWA BRIDGE

PROJECT NO. 11N-01-07M

DISTRICT OF SOUTH HILO

ISLAND OF HAWAII

INDEX TO DRAWINGS

SHEET NO.	DESCRIPTION
1	TITLE SHEET
2	STANDARD PLANS SUMMARY
3	GENERAL NOTES AND LEGEND
4–5	WATER POLLUTION AND EROSION CONTROL NOTES
6	TYPICAL SECTION
7 – 16	ROADWAY PLANS
17	RECONSTRUCTION AREA SCHEDULE AND MONUMENT SCHEDULE
18	SIGN AND PAVEMENT MARKING LEGEND AND NOTES, SIGN SCHEDULE
19 – 28	SIGNING AND PAVEMENT MARKING PLANS
29	HIGH SPEED DIVIDED HIGHWAY WORK ZONE SIGNING PLANS, NOTES AND DETAILS

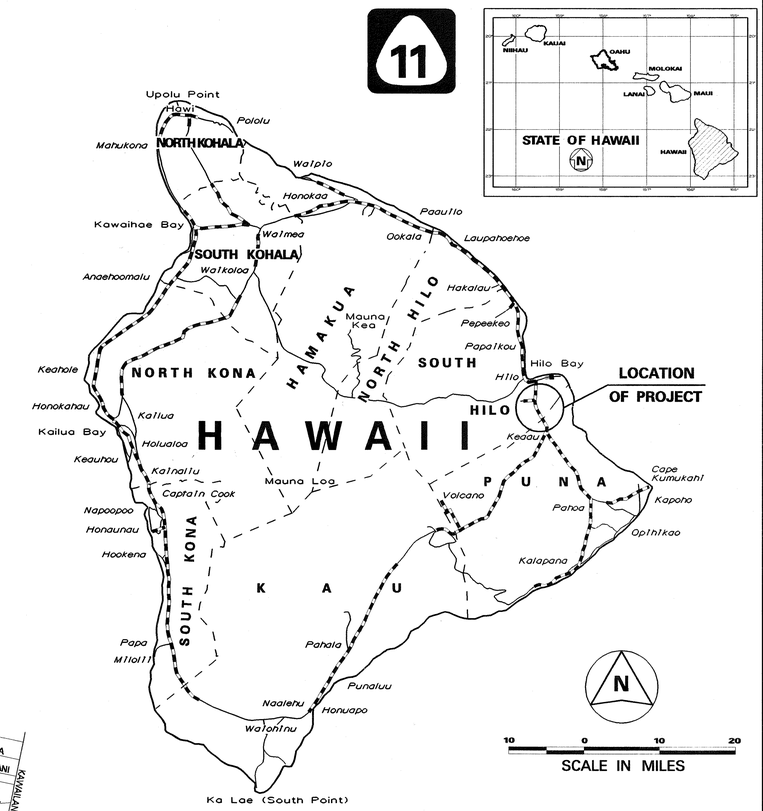

FEDERAL AID PROJECTS PREVIOUSLY CONSTRUCTED OR UNDER CONSTRUCTION

MILE POST 6.50 TO MILE POST 3.31

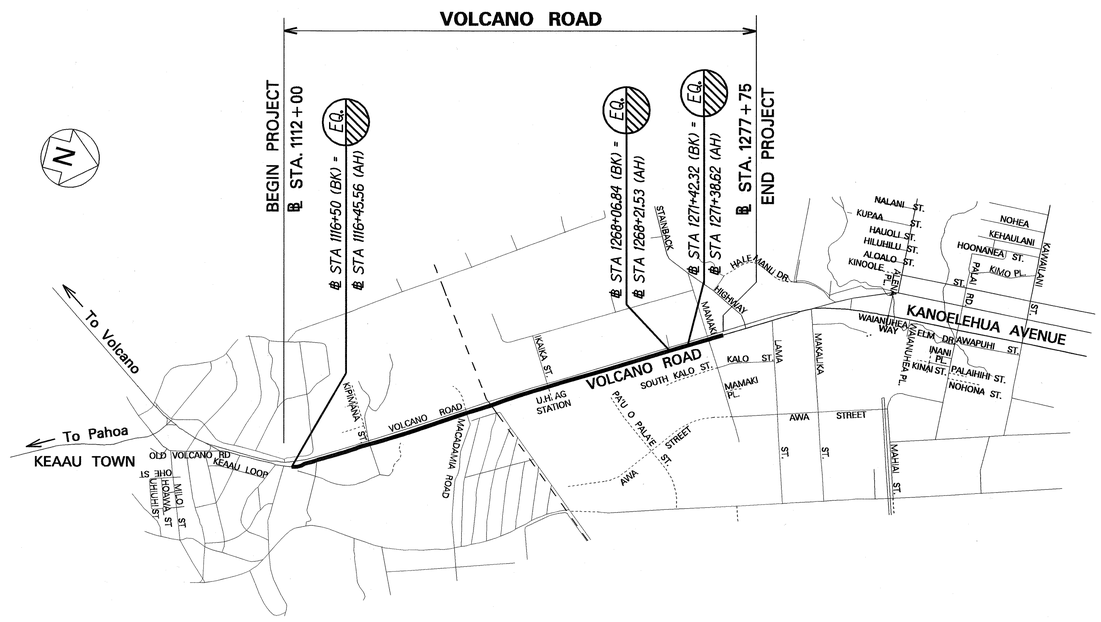

LAYOUT PLAN

GROSS LENGTH OF PROJECT..... 3.19 MILES

NET LENGTH OF PROJECT..... 3.19 MILES

2 0 2 4 6

SCALE IN THOUSAND FEET

CHANGES MADE DURING CONSTRUCTION HAVE BEEN INCORPORATED ON THESE PLANS EXCEPT CHANGES IN THE ORIGINAL THEORETICAL QUANTITIES. FOR ACTUAL QUANTITIES, REFER TO PROJECT LEDGER AND/OR COMPUTATION BOOK.

for RESIDENT ENGINEER — DATE 6-29-10

DEPARTMENT OF TRANSPORTATION
STATE OF HAWAII

APPROVED:

DIR. OF TRANSPORTATION — DATE 5.22.08

HWY-D DESIGNED BY	HWY-DD MANAGED BY	692-7570 PHONE	MAY 2008 DATE