DIST. NO.	STATE	FED. AID PROJ. NO.	FISCAL YEAR	SHEET NO.	TOTAL SHEETS
HAWAII	HAW.	STP-011-1(026)	2012	1	21

INDEX TO DRAWINGS

SHEET NO.	DESCRIPTION
1	TITLE SHEET
2	STANDARD PLANS SUMMARY
3	GENERAL NOTES AND LEGEND
4–5	WATER POLLUTION AND EROSION CONTROL NOTES
6	TYPICAL SECTION AND DETAILS
7–16	ROADWAY PLANS
17	PAVEMENT MARKING LEGEND AND NOTES
18	STRIPING AND PAVEMENT MARKING SCHEDULE
19	MONUMENT SCHEDULE
20	TYPICAL GUARDRAIL PAVING DETAILS FULL PAVING UNDER GUARDRAIL
21	LOW SPEED UNDIVIDED HIGHWAY WORK ZONE SIGNING PLAN, NOTES AND DETAILS

STATE OF HAWAII

DEPARTMENT OF TRANSPORTATION

HIGHWAYS DIVISION

HONOLULU, HAWAII

"AS-BUILT"

PLANS FOR

MAMALAHOA HIGHWAY PAVEMENT PREVENTIVE MAINTENANCE

KAOHE TO KAAPUNA

FEDERAL AID PROJECT NO. STP–011–1(026)

DISTRICT OF SOUTH KONA

ISLAND OF HAWAII

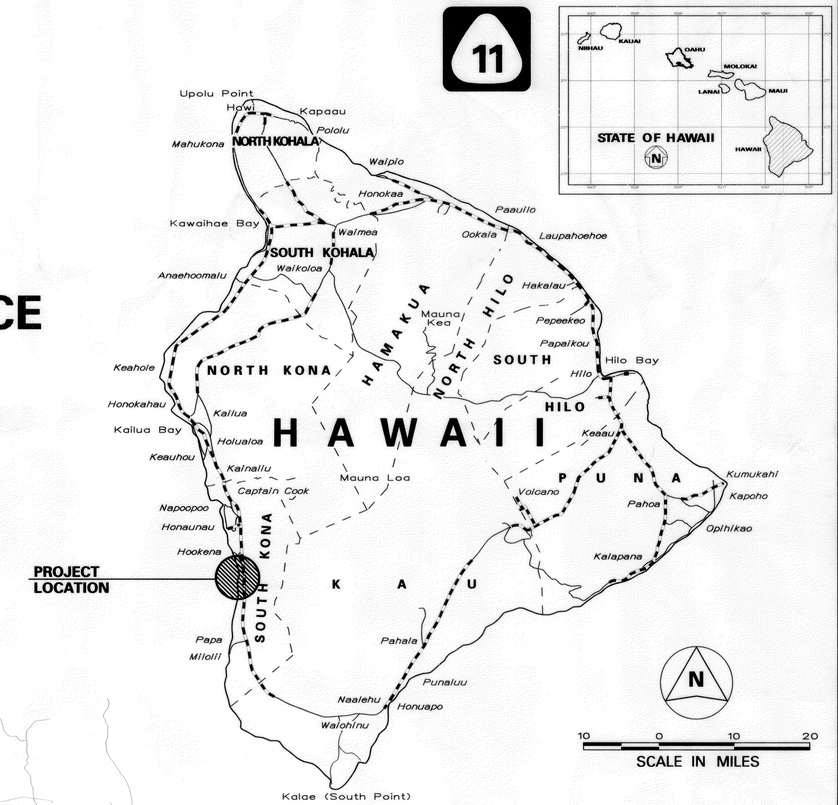

FEDERAL AID PROJECTS PREVIOUSLY CONSTRUCTED OR UNDER CONSTRUCTION

MILE POST 96.50 TO MILE POST 92.49

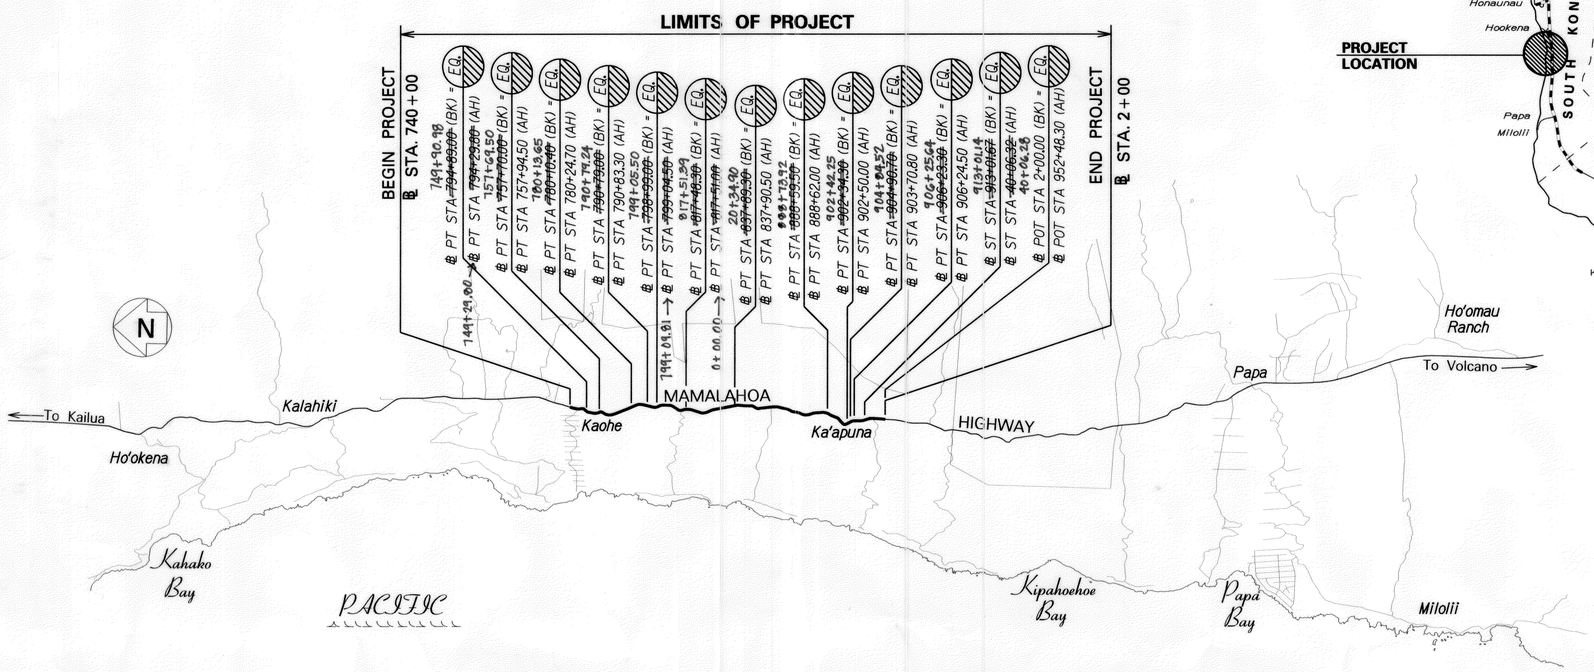

LAYOUT PLAN

LENGTH OF PROJECT..... 4.01 MILES

4 0 4 8 12

SCALE IN THOUSAND FEET

DESIGN DESIGNATION

ADT (2012)..... 4,600
ADT (2022)..... 5,900
DHV 530
D 65/35
T ..... 3.0 %
V ..... 35 M.P.H.

CHANGES MADE DURING CONSTRUCTION HAVE BEEN INCORPORATED ON THESE PLANS EXCEPT CHANGES IN THE ORIGINAL THEORETICAL QUANTITIES. FOR ACTUAL QUANTITIES, REFER TO PROJECT LEDGER AND/OR COMPUTATION BOOK.

RESIDENT ENGINEER 7/22/13 DATE

DEPARTMENT OF TRANSPORTATION
STATE OF HAWAII

APPROVED:

for DIR. OF TRANSPORTATION 5/04/12 DATE

HAWAII DISTRICT DESIGNED BY | HWY-HE MANAGED BY | 933-8866 PHONE | MAY, 2012 DATE