

FED. ROAD DIST. NO.	STATE	PROJ. NO.	FISCAL YEAR	SHEET NO.	TOTAL SHEETS
HAWAII	HAW.	IIN-01-87	1987	4	5

TRUE NORTH
SCALE: 1" = 20'




INSTALL NEW R17-3 SIGN AND POST MOUNTED ON TS STANDARD

REMOVE EXIST. R1-2 SIGN AND POST

NEW BITUMINOUS CURB TYPE 6, PAINTED YELLOW

NEW 4" SOLID YELLOW EDGE STRIPING WITH TYPE "H" MARKERS

INSTALL NEW W3-3 SIGNS AND POSTS 94.0 LF FROM STOP BAR 12 FT. FROM RT. EP. 12 FT. FROM LT. EP.

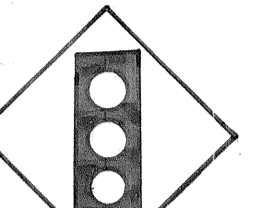


SIGNAL AHEAD

REMOVE EXIST. R3-2 & R3-4 SIGNS & POST

SIGN POST ANCHOR CUT OFF AT GROUND LINE



NEW 8" SOLID WHITE LANE LINE W/ TYPE "C" MARKERS

NEW 8" SOLID WHITE LANE LINE W/ TYPE "C" MARKERS (REMOVE EXIST. 4" SOLID YELLOW STRIPING AND TYPE "H" MARKERS)

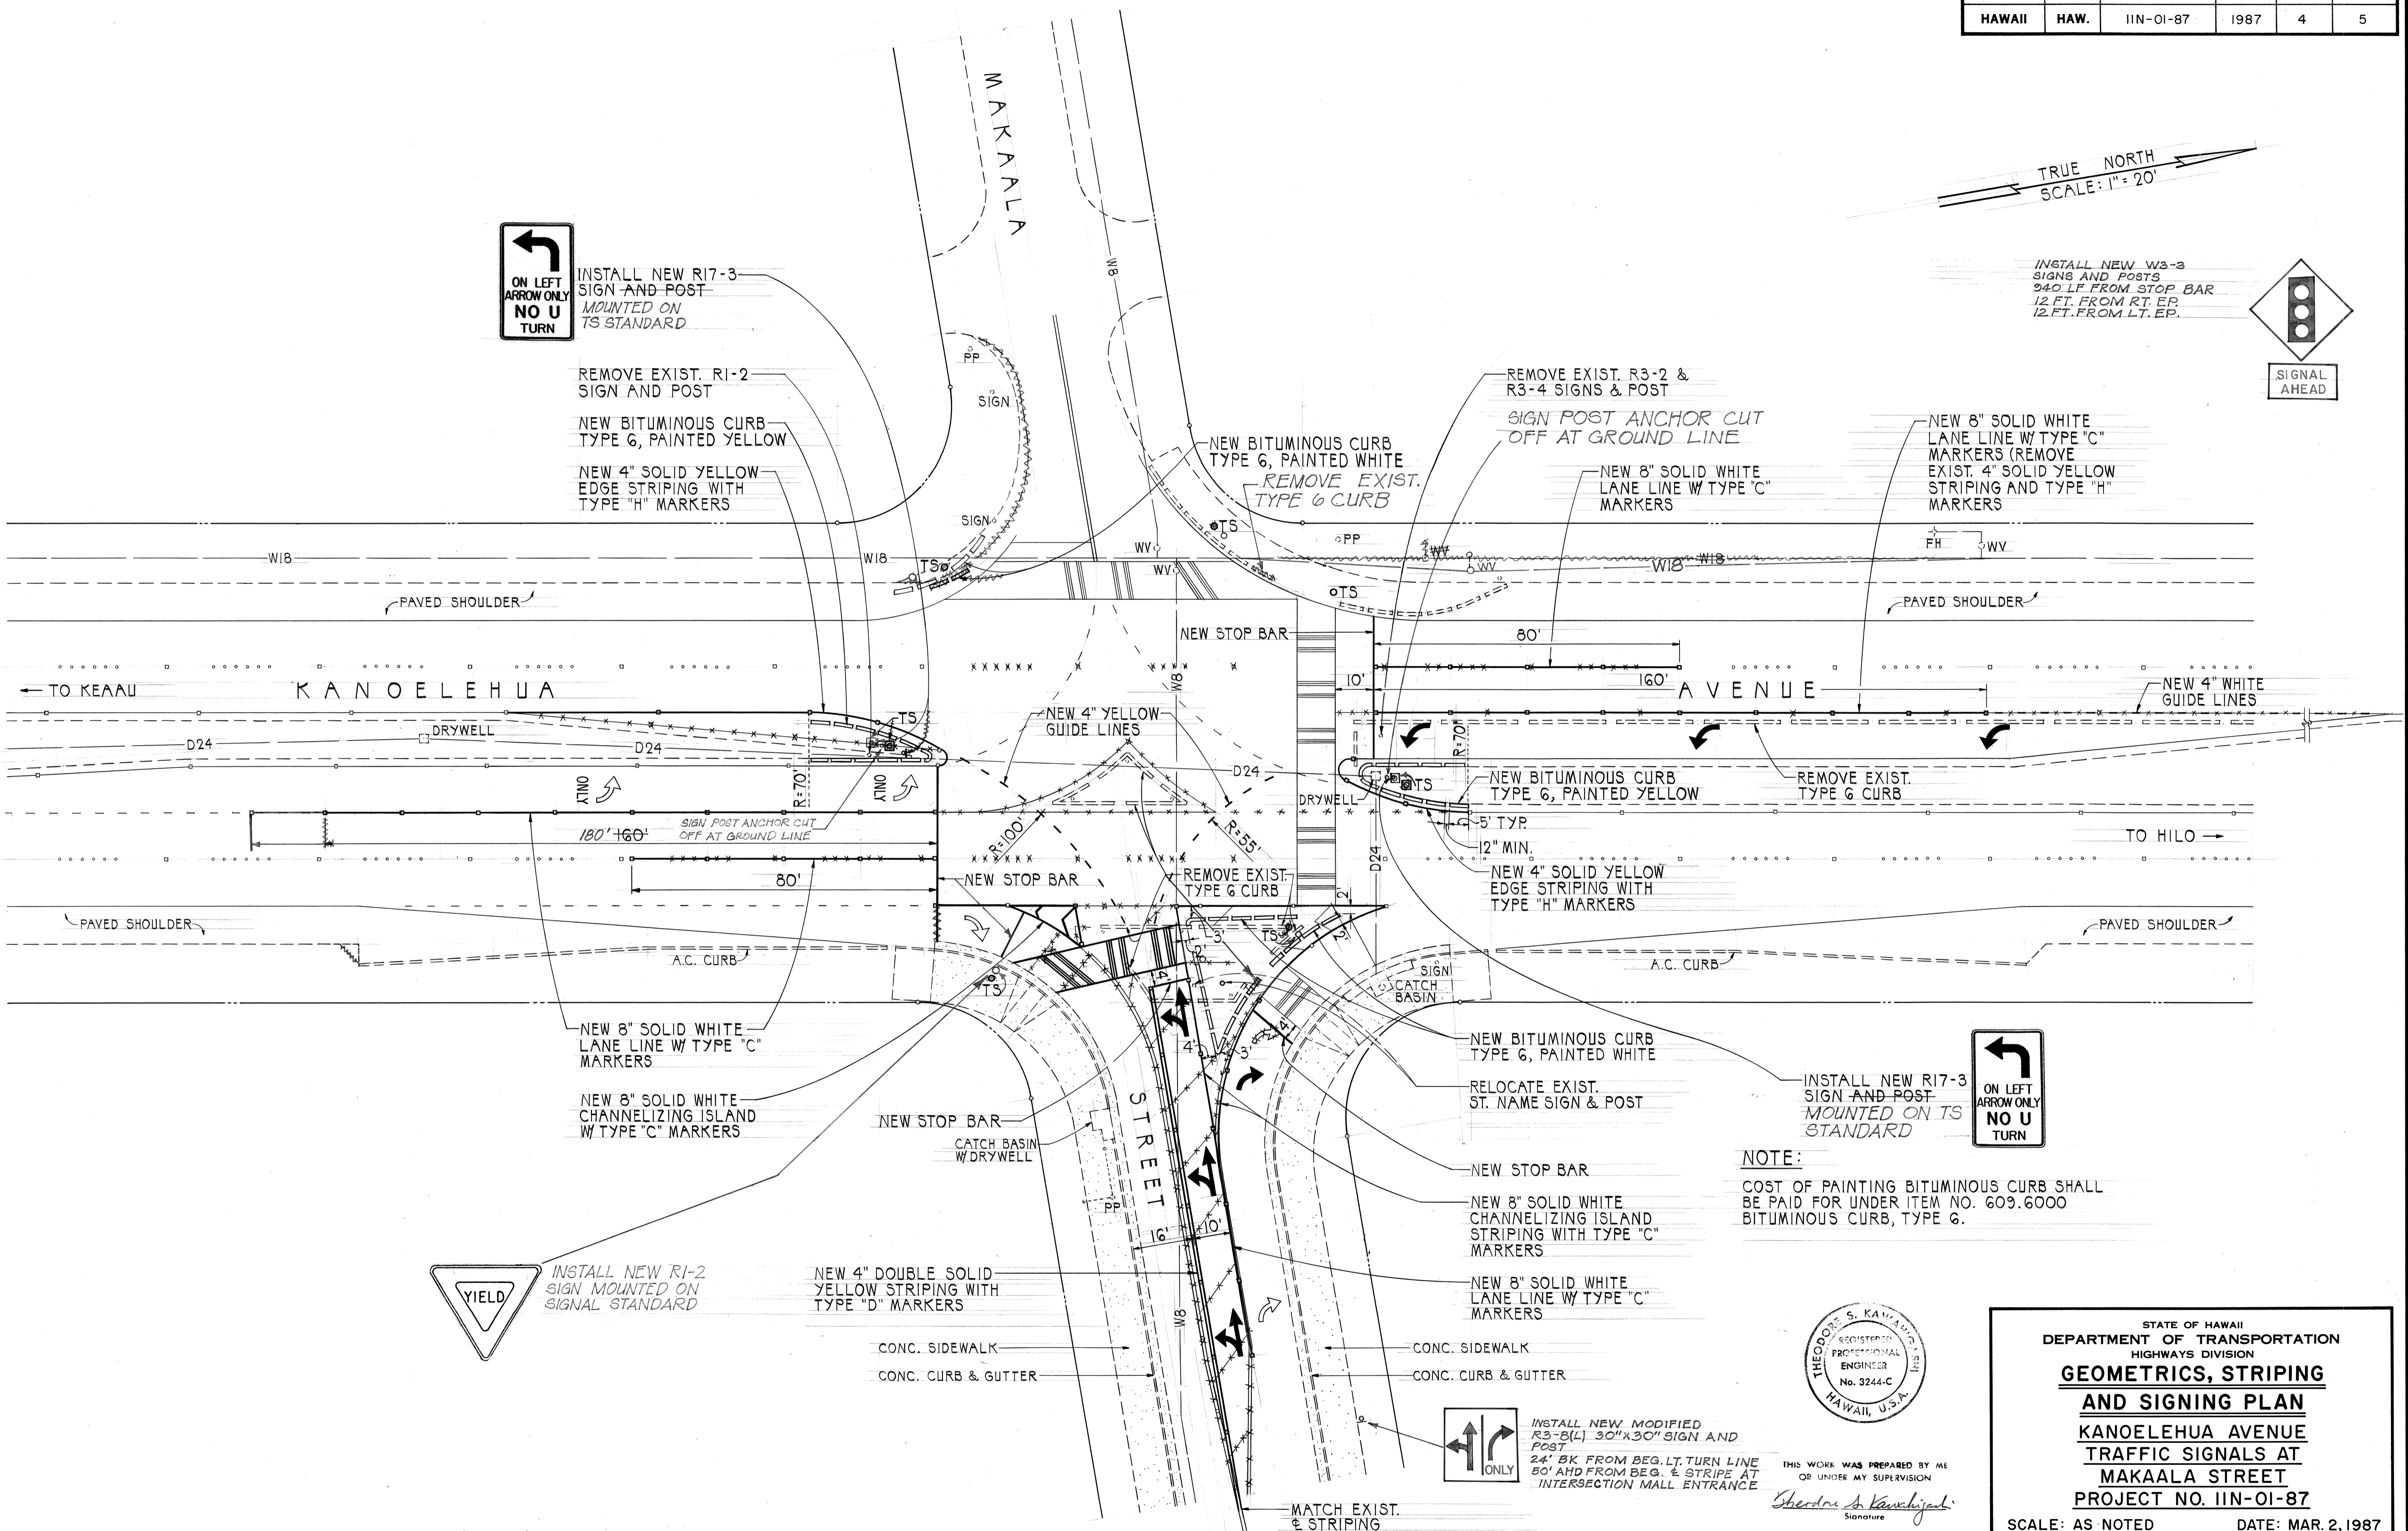


NOTE:
COST OF PAINTING BITUMINOUS CURB SHALL BE PAID FOR UNDER ITEM NO. 609.6000 BITUMINOUS CURB, TYPE 6.

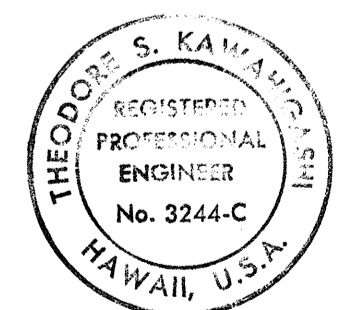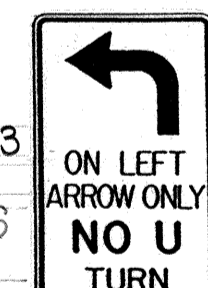

THIS WORK WAS PREPARED BY ME OR UNDER MY SUPERVISION
Signature

STATE OF HAWAII
DEPARTMENT OF TRANSPORTATION
HIGHWAYS DIVISION
**GEOMETRICS, STRIPING
AND SIGNING PLAN**
KANOELEHUA AVENUE
TRAFFIC SIGNALS AT
MAKALA STREET
PROJECT NO. IIN-01-87
SCALE: AS NOTED DATE: MAR. 2, 1987
