FED. ROAD DIST. NO.	STATE	PROJ. NO.	FISCAL YEAR	SHEET NO.	TOTAL SHEETS
HAWAII	HAW.	IIN-01-87	1987	1	5

INDEX TO DRAWINGS

SHEET NO.	DESCRIPTION
1	TITLE SHEET
2	STANDARD PLANS SUMMARY
3	LEGEND AND NOTES
4	GEOMETRICS, STRIPING & SIGNING PLAN
5	TRAFFIC SIGNAL PLAN

STATE OF HAWAII

DEPARTMENT OF TRANSPORTATION

HIGHWAYS DIVISION

HONOLULU, HAWAII

"AS-BUILT"

PLANS FOR

KANOELEHUA AVENUE
TRAFFIC SIGNALS AT MAKAALA STREET
PROJECT NO. IIN-01-87

DISTRICT OF SOUTH HILO
ISLAND OF HAWAII

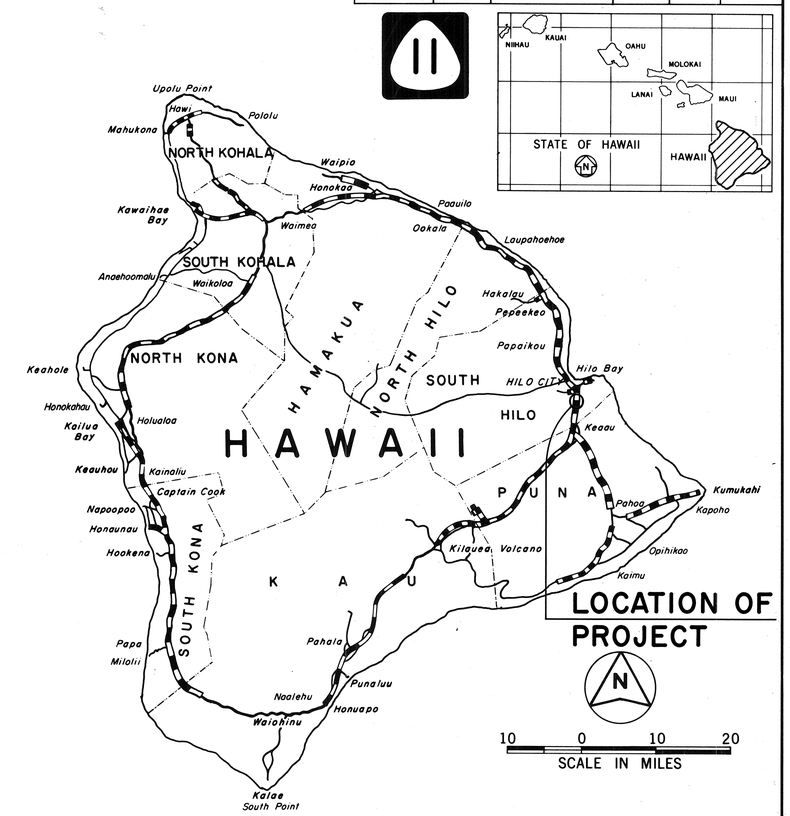

FEDERAL AID PROJECTS PREVIOUSLY CONSTRUCTED OR UNDER CONSTRUCTION

CHANGES MADE DURING CONSTRUCTION HAVE BEEN INCORPORATED ON THESE PLANS EXCEPT CHANGES IN THE ORIGINAL THEORETICAL QUANTITIES. FOR ACTUAL QUANTITIES, REFER TO PROJECT LEDGER AND/OR COMPUTATION BOOK.

Howard Hayman — 9-27-88
RESIDENT ENGINEER — DATE

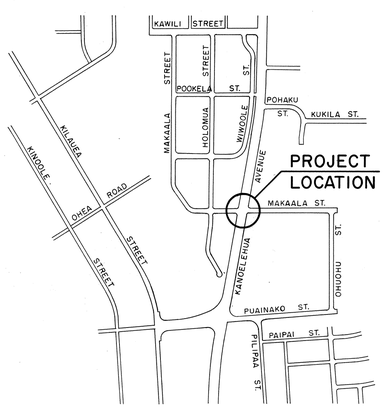

LAYOUT PLAN

1000 0 1000 2000
SCALE IN FEET

N

AUSTIN, TSUTSUMI & ASSOC., INC.
ENGINEERS · SURVEYORS · HAWAII

DESIGNED BY — ALVIN TAKESHITA, P. S. & E. — PHONE 548-7537 — DATE MARCH 2, 1987

DEPARTMENT OF TRANSPORTATION
STATE OF HAWAII

APPROVED:

FOR DIR. OF TRANSPORTATION — 3/20/87 — DATE