FED. ROAD DIST. NO.	STATE	PROJ. NO.	FISCAL YEAR	SHEET NO.	TOTAL SHEETS
HAWAII	HAW.	IIC-01-90M	1990	1	7

INDEX TO DRAWINGS

SHEET NO.	DESCRIPTION
1	TITLE SHEET
2	STANDARD PLAN SUMMARY
3	TYPICAL SECTION
4-5	ROADWAY & STRIPING LAYOUT
6	TYPICAL SIDEROAD & DRIVEWAY CONNECTION & PAVEMENT MARKER SCHEDULE
7	CENTERLINE MONUMENT & CONSTRUCTION SIGN SCHEDULE

STATE OF HAWAII

DEPARTMENT OF TRANSPORTATION
HIGHWAYS DIVISION

"AS-BUILT"

PLANS FOR

HAWAII BELT ROAD RESURFACING

HONOKUA TO KAOHE

PROJECT NO. IIC-01-90M

DISTRICT OF SOUTH KONA
ISLAND OF HAWAII

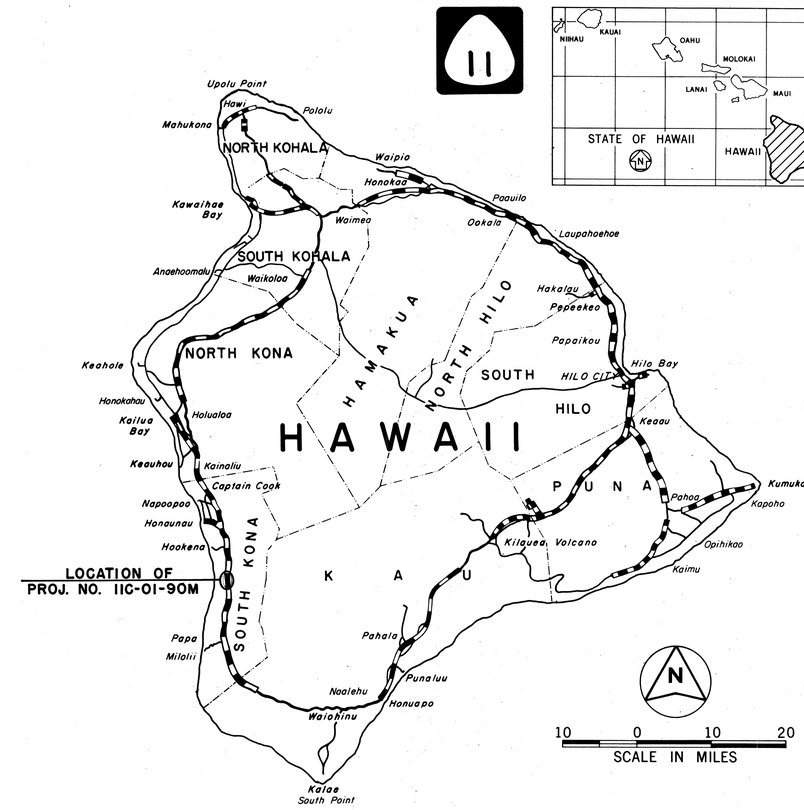

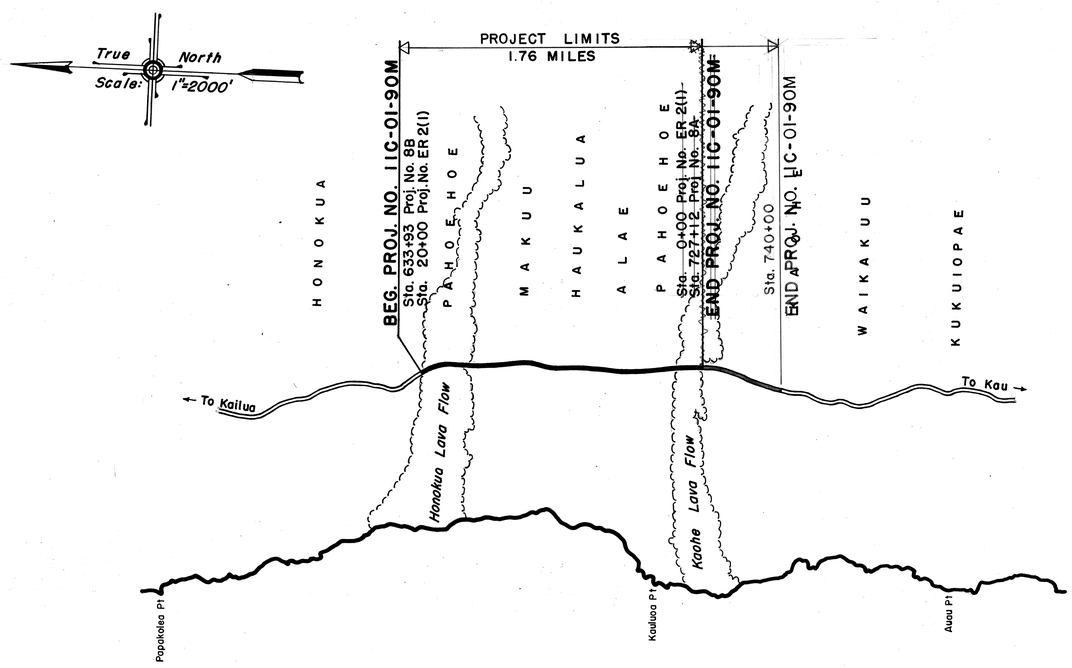

LAYOUT OF PROJECT

FEDERAL AID PROJECTS PREVIOUSLY CONSTRUCTED OR UNDER CONSTRUCTION

MILE POST 98.52 TO MILE POST 96.50

CHANGES MADE DURING CONSTRUCTION HAVE BEEN INCORPORATED ON THESE PLANS EXCEPT CHANGES IN THE ORIGINAL THEORETICAL QUANTITIES. FOR ACTUAL QUANTITIES, REFER TO PROJECT LEDGER AND/OR COMPUTATION BOOK.

RESIDENT ENGINEER — DATE 12-10-90

DEPARTMENT OF TRANSPORTATION
STATE OF HAWAII
APPROVED:
DIR. OF TRANSPORTATION — DATE 2/9/90

HWY-H	A. YAMAGUCHI	548-7534	FEB. 6, 1990
DESIGNED BY	P. S. & E. BY	PHONE	DATE