FED. ROAD DIST. NO.	STATE	PROJ. NO.	FISCAL YEAR	SHEET NO.	TOTAL SHEETS
HAWAII	HAW.	11BC-01-90	1989	28	36

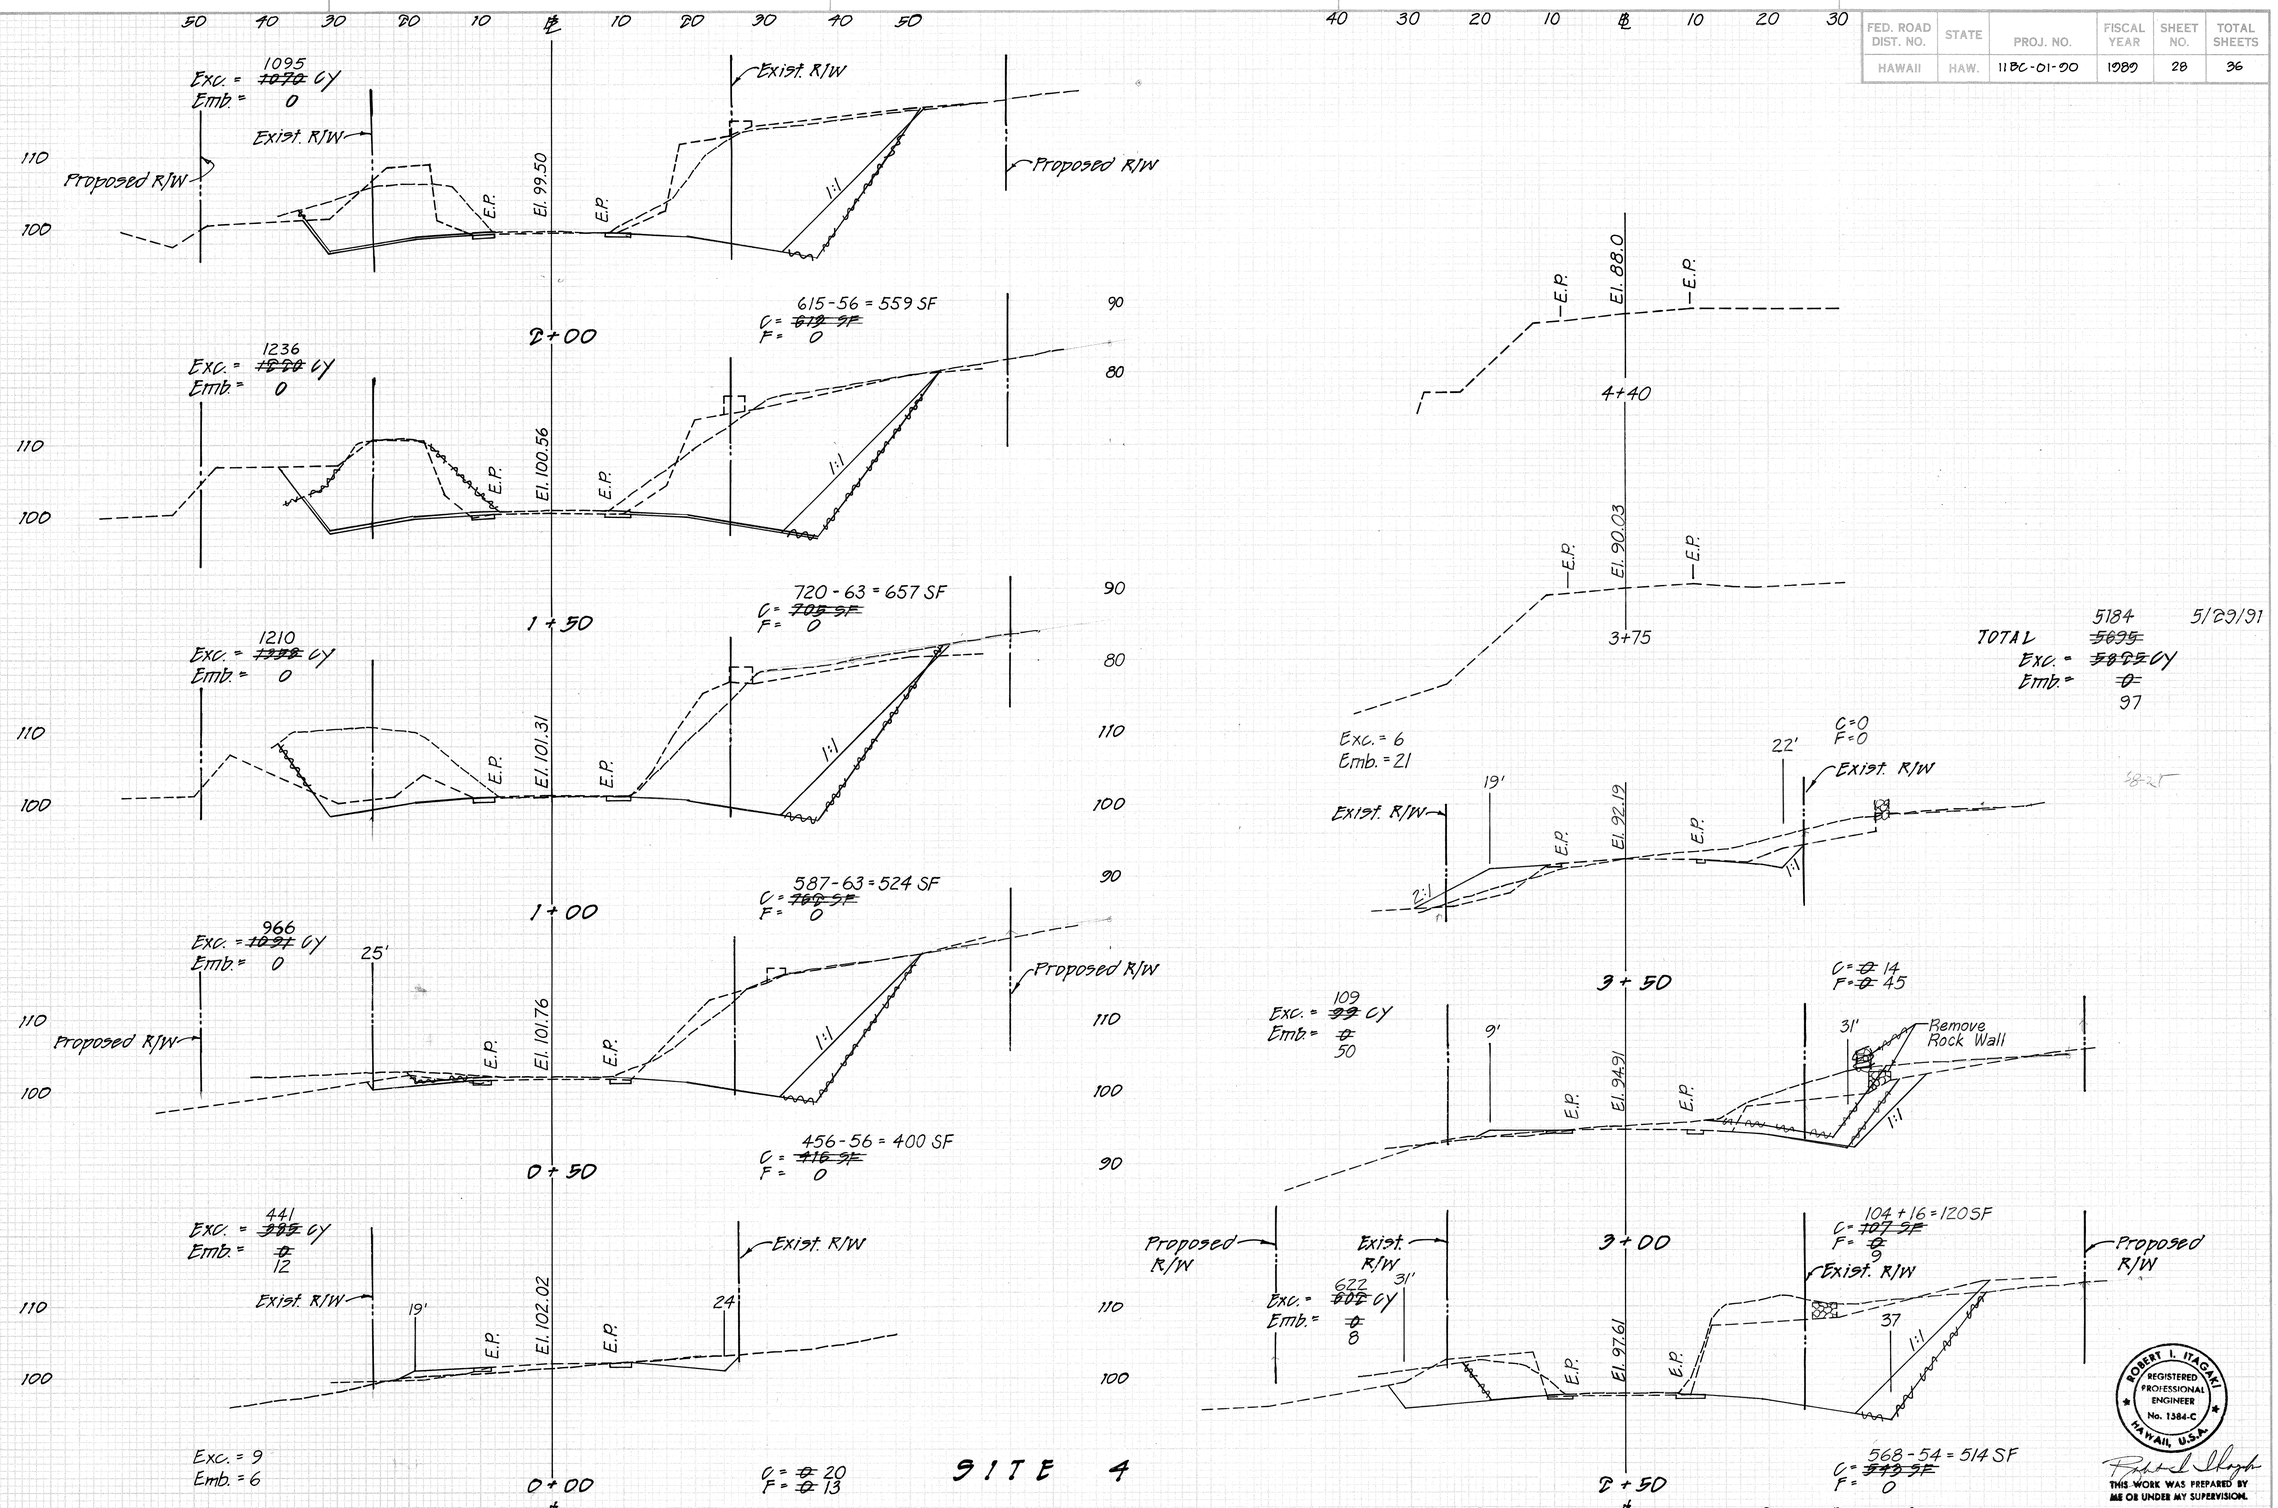

FINAL SURVEY — NOTE BOOK NO. — SURVEYED — PLOTTED — COMPUTED — AREAS — AREAS CHECKED — BY — DATE

ORIGINAL SURVEY — NOTE BOOK NO. — SURVEYED — PLOTTED — COMPUTED — AREAS — AREAS CHECKED — BY — DATE