FED. ROAD DIST. NO.	STATE	PROJ. NO.	FISCAL YEAR	SHEET NO.	TOTAL SHEETS
HAWAII	HAW.	11MN-01-93M	1993	1	13

INDEX TO DRAWINGS

SHEET NO.	DESCRIPTION
1	TITLE SHEET
2	STANDARD PLAN SUMMARY SHEET
3	GENERAL NOTES
4	TYPICAL SECTION & DETAILS
5	TYPICAL DETAILS & SCHEDULE
6 – 8	PLAN
9	TRAFFIC LEGEND, DETAILS & NOTES
10 – 12	SIGNING & PAVEMENT MARKING PLAN
13	TRAFFIC SUMMARIES

STATE OF HAWAII

DEPARTMENT OF TRANSPORTATION

HIGHWAYS DIVISION

HONOLULU, HAWAII

"AS-BUILT"

PLANS FOR

VOLCANO ROAD RESURFACING
Kurtistown to Keaau

PROJECT NO. 11MN-01-93M

DISTRICT OF PUNA

ISLAND OF HAWAII

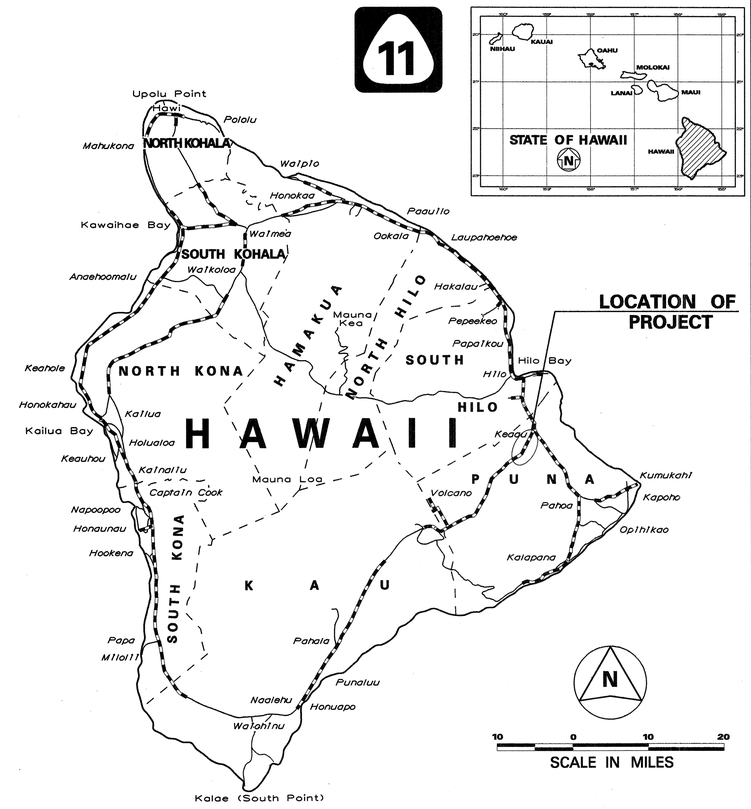

FEDERAL AID PROJECTS PREVIOUSLY CONSTRUCTED OR UNDER CONSTRUCTION

MILE POST 8.24 TO MILE POST 9.71

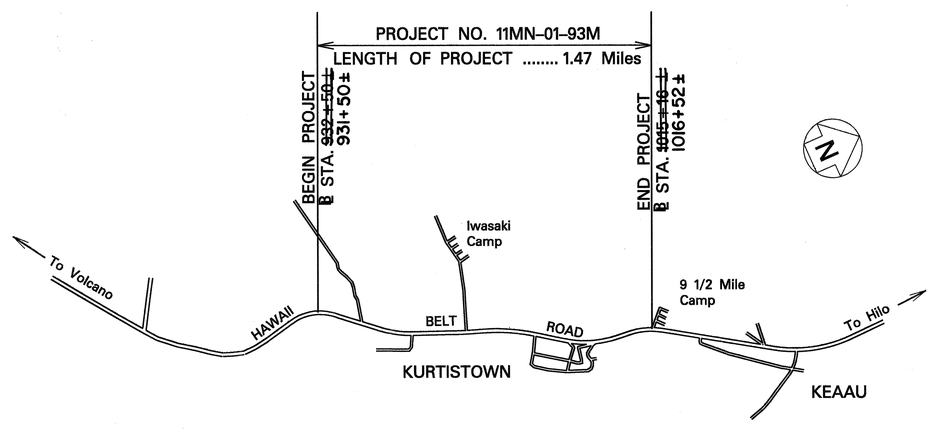

LAYOUT PLAN

2 0 2 4

SCALE IN TWO THOUSAND FEET

CHANGES MADE DURING CONSTRUCTION HAVE BEEN INCORPORATED ON THESE PLANS EXCEPT CHANGES IN THE ORIGINAL THEORETICAL QUANTITIES.

Robert Y.W. Lee Jr. 7-22-96

RESIDENT ENGINEER DATE

DEPARTMENT OF TRANSPORTATION
STATE OF HAWAII

APPROVED:

T. Hamano 3/24/93

FOR DIR. OF TRANSPORTATION DATE

HWY-DD UNIT A — DESIGNED BY

JULIUS B. FRONDA — P. S. & E. BY

587-2246 — PHONE

MAR., 1993 — DATE