| INDEX TO DRAWINGS | |
|---|---|
| SHEET NO. | DESCRIPTION |
| 1 | TITLE SHEET |
| 2 | STANDARD PLANS SUMMARY |
| 3 | TYPICAL SECTIONS & DETAILS |
| 4-6 | ROADWAY AND STRIPING PLAN |
| 7 | CONSTRUCTION SIGN DETAIL, SIGN AND MISC. SCHEDULES |

| FED. ROAD DIST. NO. | STATE | PROJ. NO. | FISCAL YEAR | SHEET NO. | TOTAL SHEETS |
|---|---|---|---|---|---|
| HAWAII | HAW. | IIL-01-91M | 1991 | 1 | 7 |

STATE OF HAWAII

DEPARTMENT OF TRANSPORTATION

HIGHWAYS DIVISION

HONOLULU, HAWAII

"AS-BUILT"

PLANS FOR

# VOLCANO ROAD RESURFACING

## GLENWOOD

## PROJECT NO. IIL-01-91M

## DISTRICT OF PUNA

## ISLAND OF HAWAII

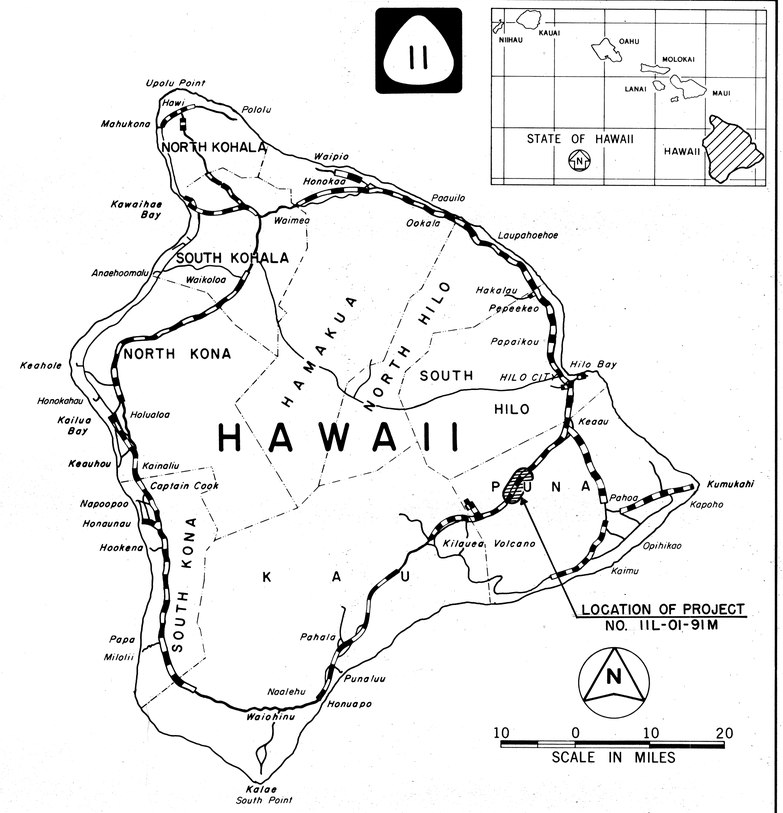


FEDERAL AID PROJECTS PREVIOUSLY CONSTRUCTED OR UNDER CONSTRUCTION

MILE POST 16.54 TO MILE POST 21.25

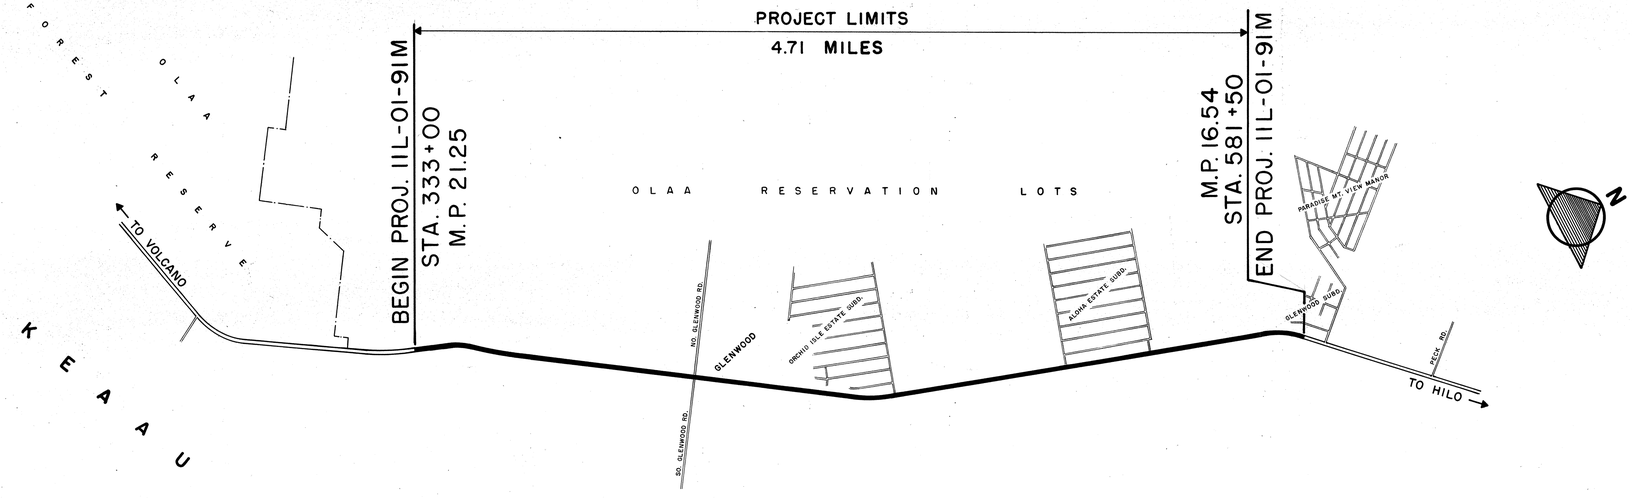


GENERAL LOCATION MAP

0.5 0
SCALE: IN MILES

CHANGES MADE DURING CONSTRUCTION HAVE BEEN INCORPORATED ON THESE PLANS EXCEPT CHANGES IN THE ORIGINAL THEORETICAL QUANTITIES. FOR ACTUAL QUANTITIES, REFER TO PROJECT LEDGER AND/OR COMPUTATION BOOK.

RESIDENT ENGINEER — DATE 7-2-93

| | | | |
|---|---|---|---|
| HAWAII DISTRICT | J. KASAMOTO | 548-7537 | JAN., 1991 |
| DESIGNED BY | P. S. & E. BY | PHONE | DATE |

DEPARTMENT OF TRANSPORTATION
STATE OF HAWAII

APPROVED:

DIR. OF TRANSPORTATION — DATE 2/12/91

C-2-5