FED. ROAD DIST. NO.	STATE	FED. AID PROJ. NO.	FISCAL YEAR	SHEET NO.	TOTAL SHEETS
HAWAII	HAW.	STP-011-2(26)	1993	1	15

INDEX TO DRAWINGS	
SHEET NO.	DESCRIPTION
1	TITLE SHEET
2	STANDARD PLANS SUMMARY
3	GENERAL NOTES & LEGEND
4	TYPICAL SECTION
5	TYPICAL DETAILS
6-15 ①	PLANS

Plan Sht. Nos. ① 15S-1 through 15S-14 are supplementary sheets to this project. TOTAL SHEET COUNT AFTER "AS-BUILT" postings 29 Sheets.

STATE OF HAWAII

DEPARTMENT OF TRANSPORTATION

HIGHWAYS DIVISION

HONOLULU, HAWAII

"AS-BUILT"

PLANS FOR

VOLCANO ROAD RESURFACING

VICINITY OF HAWAII VOLCANOES NATIONAL PARK

FEDERAL AID PROJECT NO. STP-011-2(26)

DISTRICT OF KAU & PUNA

ISLAND OF HAWAII

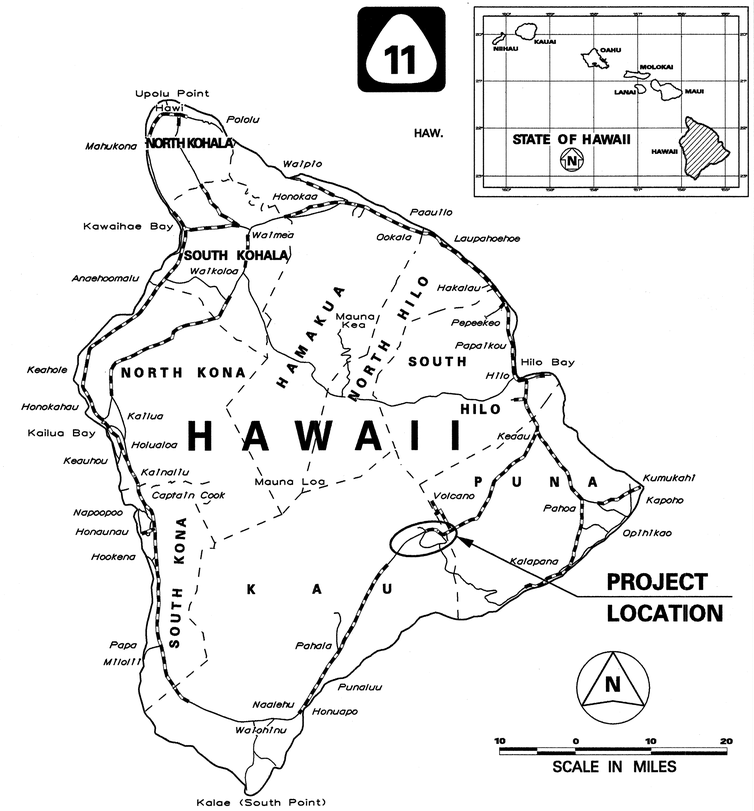

FEDERAL AID PROJECT NO. STP-011-2(26)

LENGTH OF PROJECT = 4.65 MILES

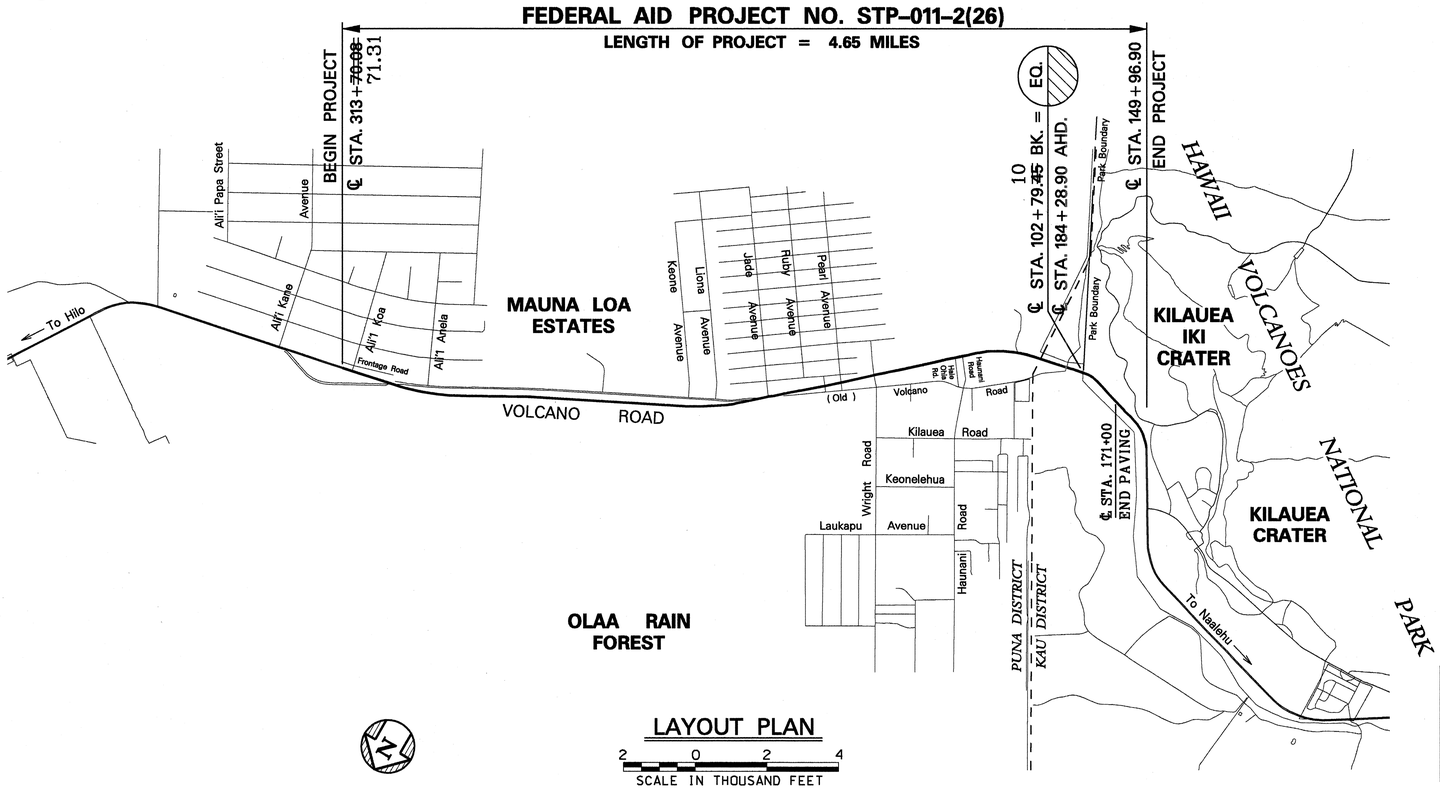

LAYOUT PLAN

FEDERAL AID PROJECTS PREVIOUSLY CONSTRUCTED OR UNDER CONSTRUCTION

MILE POST 23.52 TO MILE POST 28.17

DESIGN DESIGNATION

ADT (1993)..... 4,300
ADT (2002)..... 5,100
D 60/40
T ..... 6.5 %
V ..... 60 M.P.H.

ALL CHANGES MADE DURING CONSTRUCTION HAVE BEEN NOTED IN RED ON THESE TRACINGS AND CHECKED BY

Howard Kapua 8-8-97

RESIDENT ENGINEER DATE

DEPARTMENT OF TRANSPORTATION FEDERAL HIGHWAY ADMINISTRATION	
APPROVED:	
DIVISION ADMINISTRATOR	DATE

DEPARTMENT OF TRANSPORTATION STATE OF HAWAII	
APPROVED:	
DIR. OF TRANSPORTATION	DATE

UNIT "D"	587-2244	APRIL 1993
DESIGNED BY	PHONE	DATE
A. NISHIMURA		
P. S. & E. BY		