FED. ROAD DIST. NO.	STATE	PROJ. NO.	FISCAL YEAR	SHEET NO.	TOTAL SHEETS
HAWAII	HAW.	IIG-02-91	1992	1	4

INDEX TO DRAWINGS	
SHEET NO.	DESCRIPTION
1	TITLE SHEET
2	STANDARD PLANS SUMMARY
3	PLAN, TYPICAL SECTIONS, GENERAL NOTES & DETAILS
4	CROSS SECTIONS

STATE OF HAWAII

DEPARTMENT OF TRANSPORTATION
HIGHWAYS DIVISION

"AS-BUILT"

PLANS OF

HAWAII BELT ROAD

SHOULDER IMPROVEMENTS AT KAWA BAY

PROJECT NO. IIG-02-91

DISTRICT OF KAU
ISLAND OF HAWAII

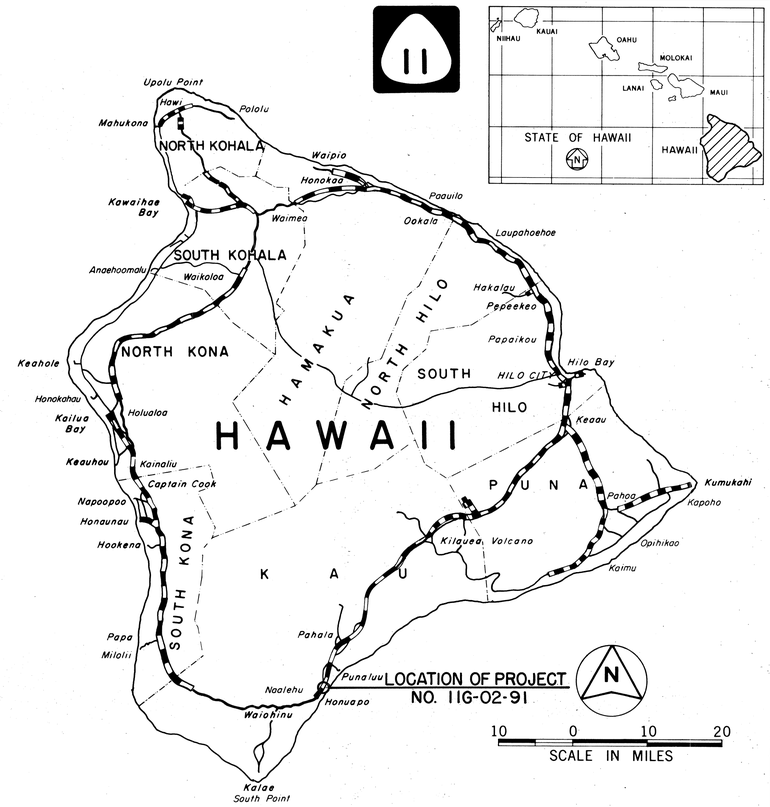

FEDERAL AID PROJECTS PREVIOUSLY CONSTRUCTED OR UNDER CONSTRUCTION

MILE POST 58.44 TO MILE POST 58.48

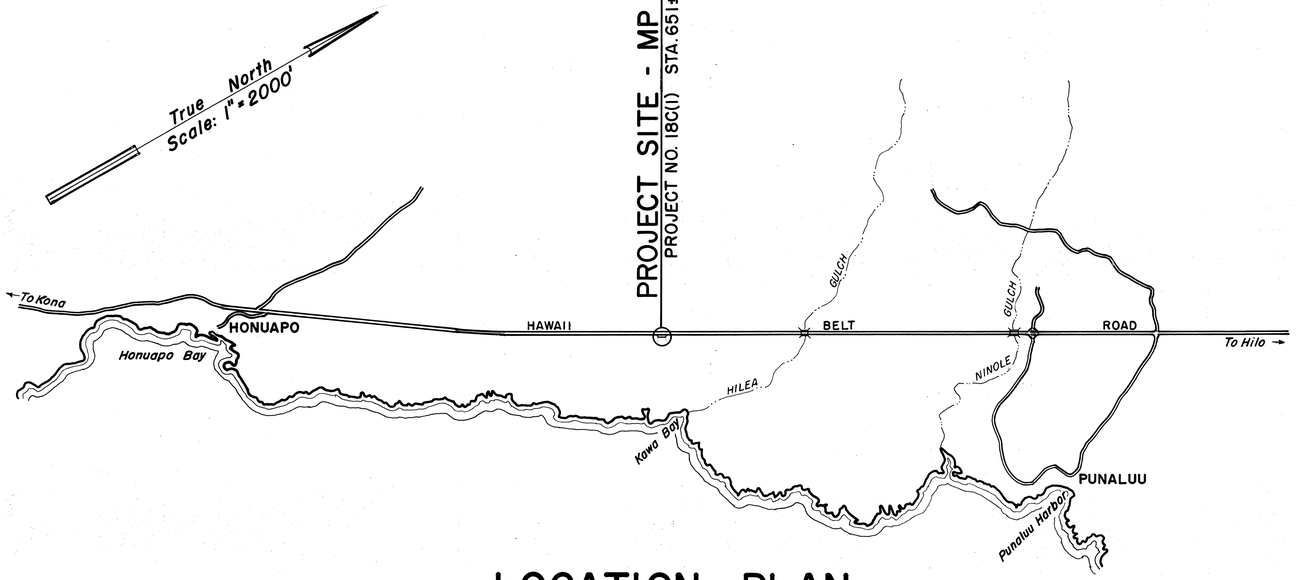

LOCATION PLAN

NO SIGNIFICANT CHANGES WERE MADE DURING CONSTRUCTION.

Roy Shioji — RESIDENT ENGINEER — 12-1-92 DATE

DEPARTMENT OF TRANSPORTATION
STATE OF HAWAII
APPROVED:
for DIR. OF TRANSPORTATION — 4/2/92 DATE

HAWAII DISTRICT — DESIGNED BY
J. KASAMOTO — P. S. & E. BY
587-2250 — PHONE
APRIL, 1992 — DATE